0055-170

ELECTROLYTIC ZINC COMPANY OF AUSTRALASIA LIMITED

WEST COAST MINES A.C.N. 004 074 962 DEPT.

	By	Date
Drawn	P. J. S.	29·05·84
Traced		
Checked		
Approved		

ROSEBERY MINE

LONGITUDINAL PROJECTION

400mS to 100mN – BELOW 17 LEVEL

5 cm

SCALE: 1:500 | FILE: | DESIGN: | DRAWING No. | SURVEY:

Revisions

No.	By	Date	Details	App.	No.	By	Date	Details	App.	References	No.

DEPARTMENT OF MINES
BROUGHT TO DATE: 31 DEC 1983
MINE MANAGER:
MINE SURVEYOR:
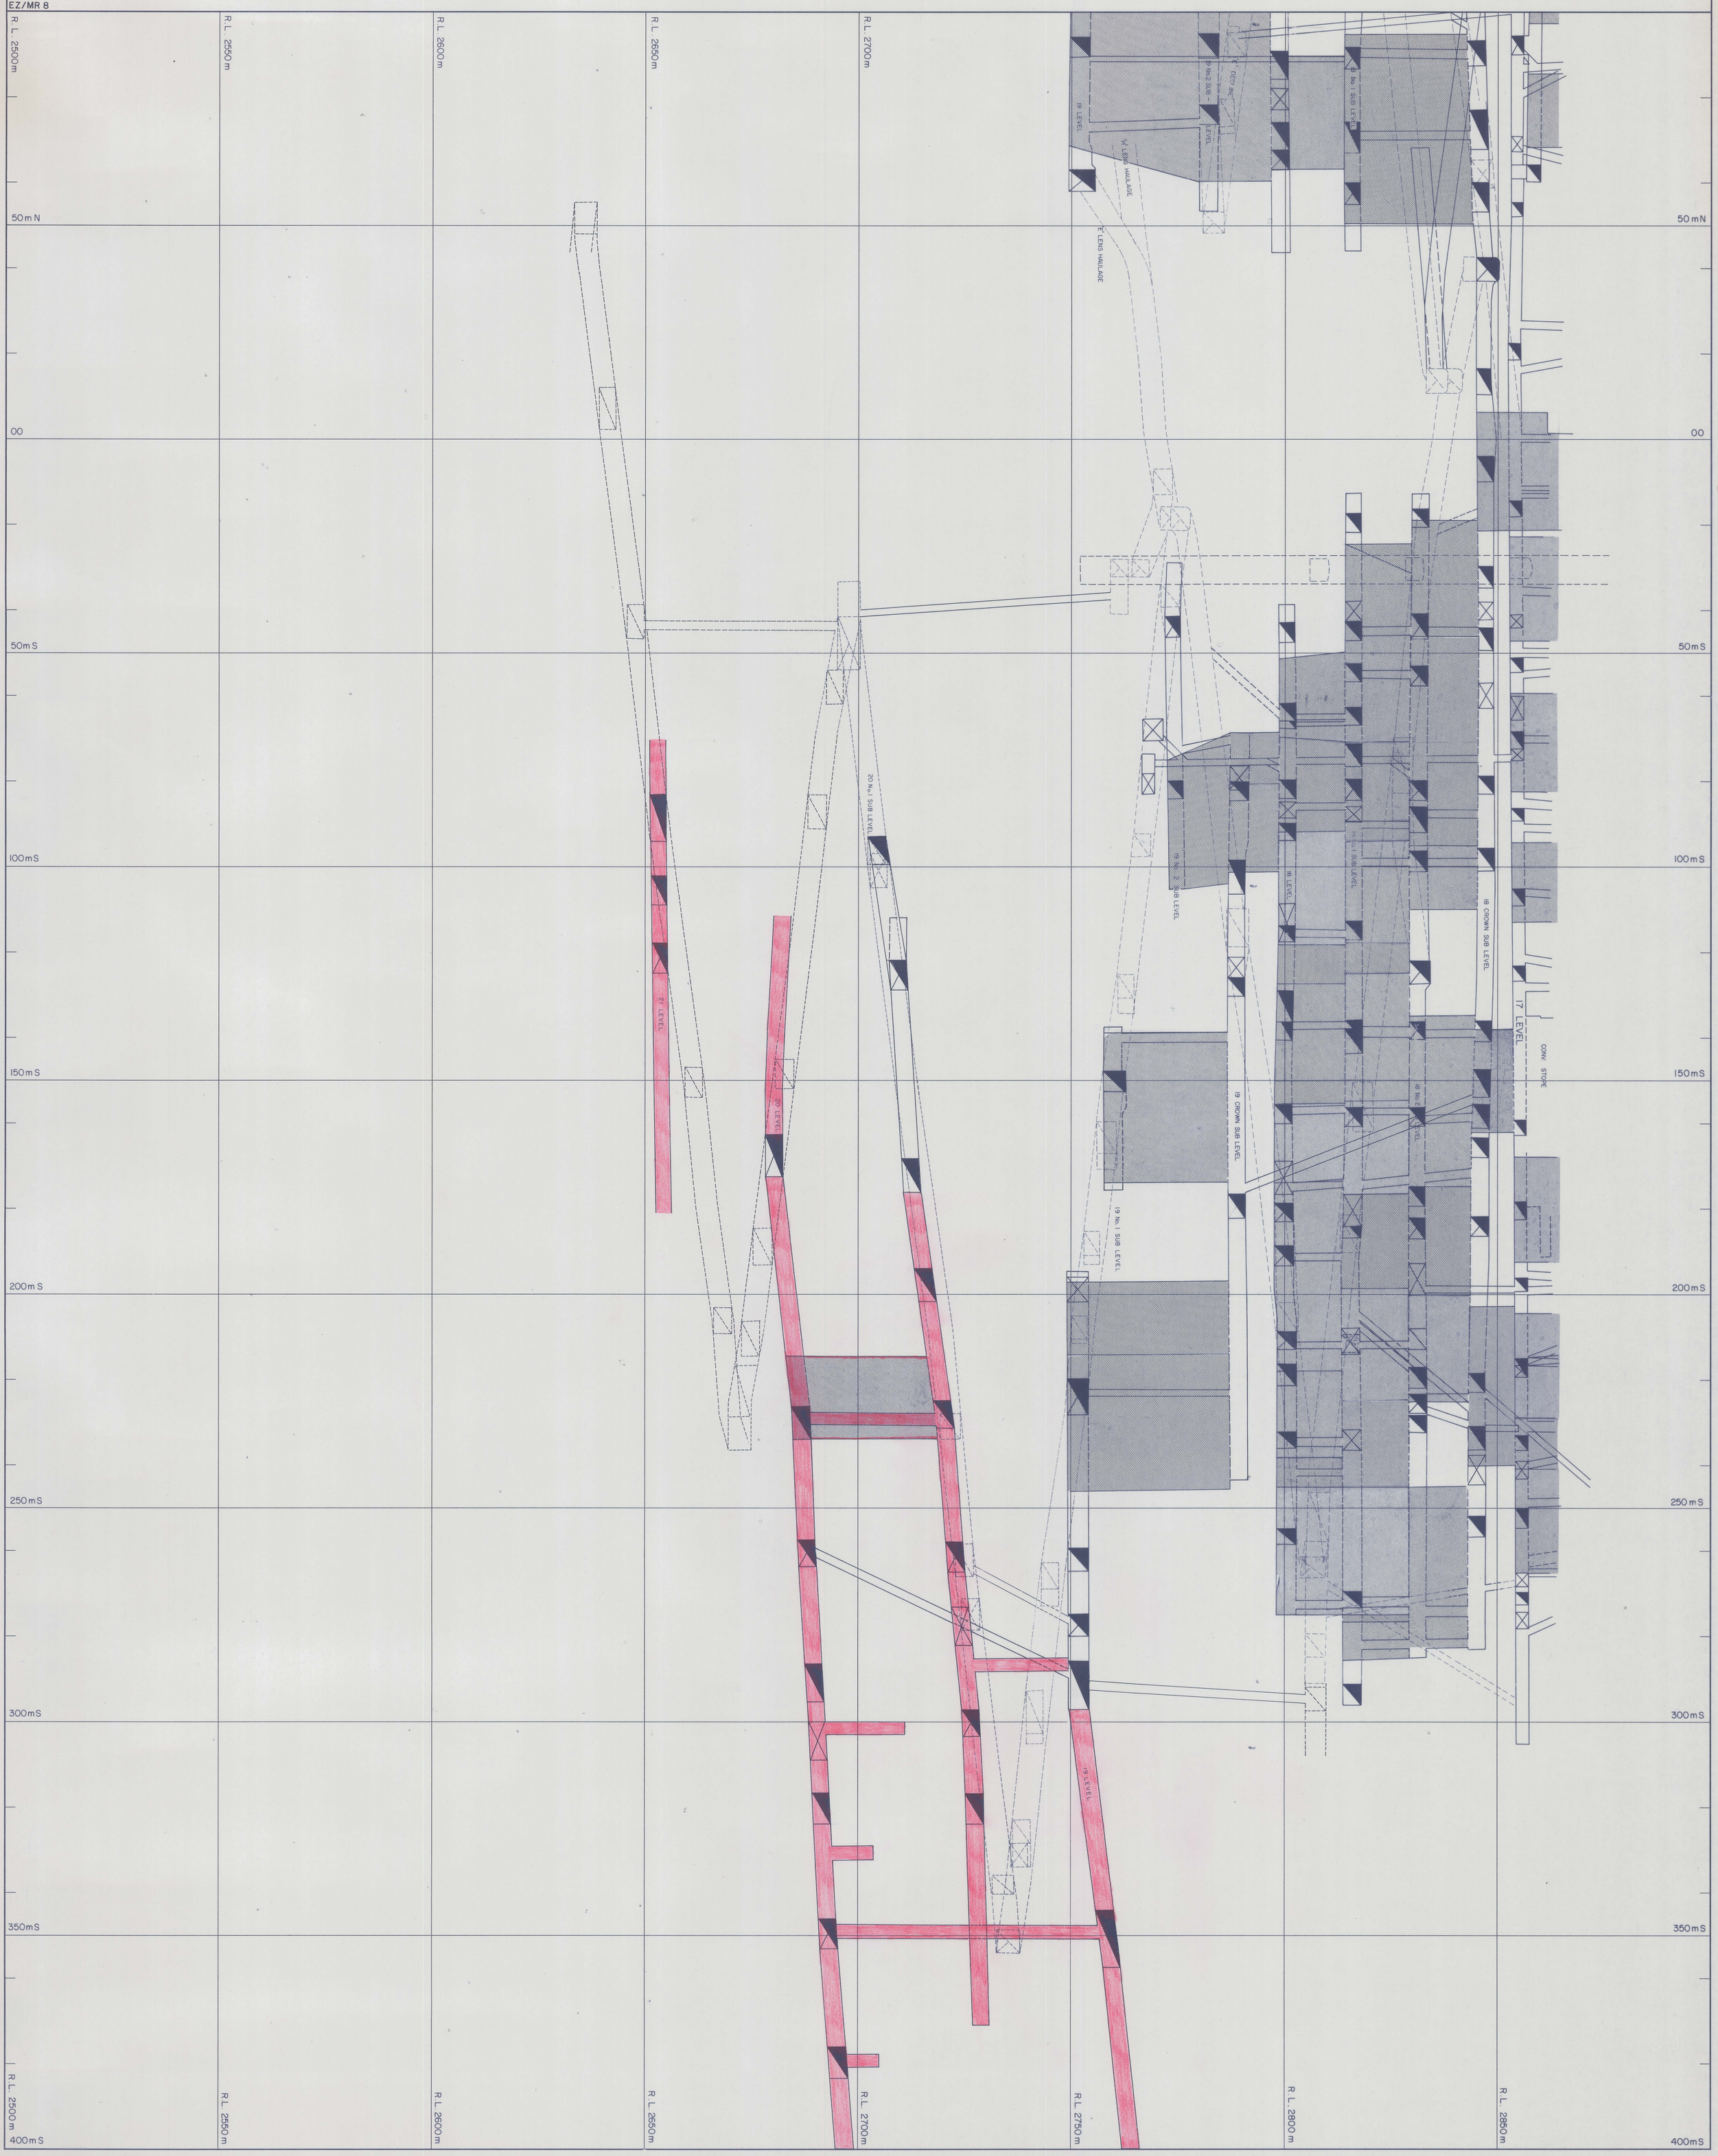
EZ/MR 8