00 SS - 183

ELECTROLYTIC ZINC COMPANY OF AUSTRALASIA LIMITED

WEST COAST MINES A.C.N. 004 074 962 DEPT.

	By	Date
Drawn	G.M. Bennett	25·05·84
Traced		
Checked		
Approved		

ROSEBERY MINE

DECLINE

SCALE: | DESIGN: | SURVEY: | FILE: | DRAWING No. 1

Revisions

No.	By	Date	Details	App.	No.	By	Date	Details	App.	References	No.

5 cm

DEPARTMENT OF MINES
BROUGHT TO DATE 31 DEC 1991
MINE MANAGER
MINE SURVEYOR

EZ/MR 8

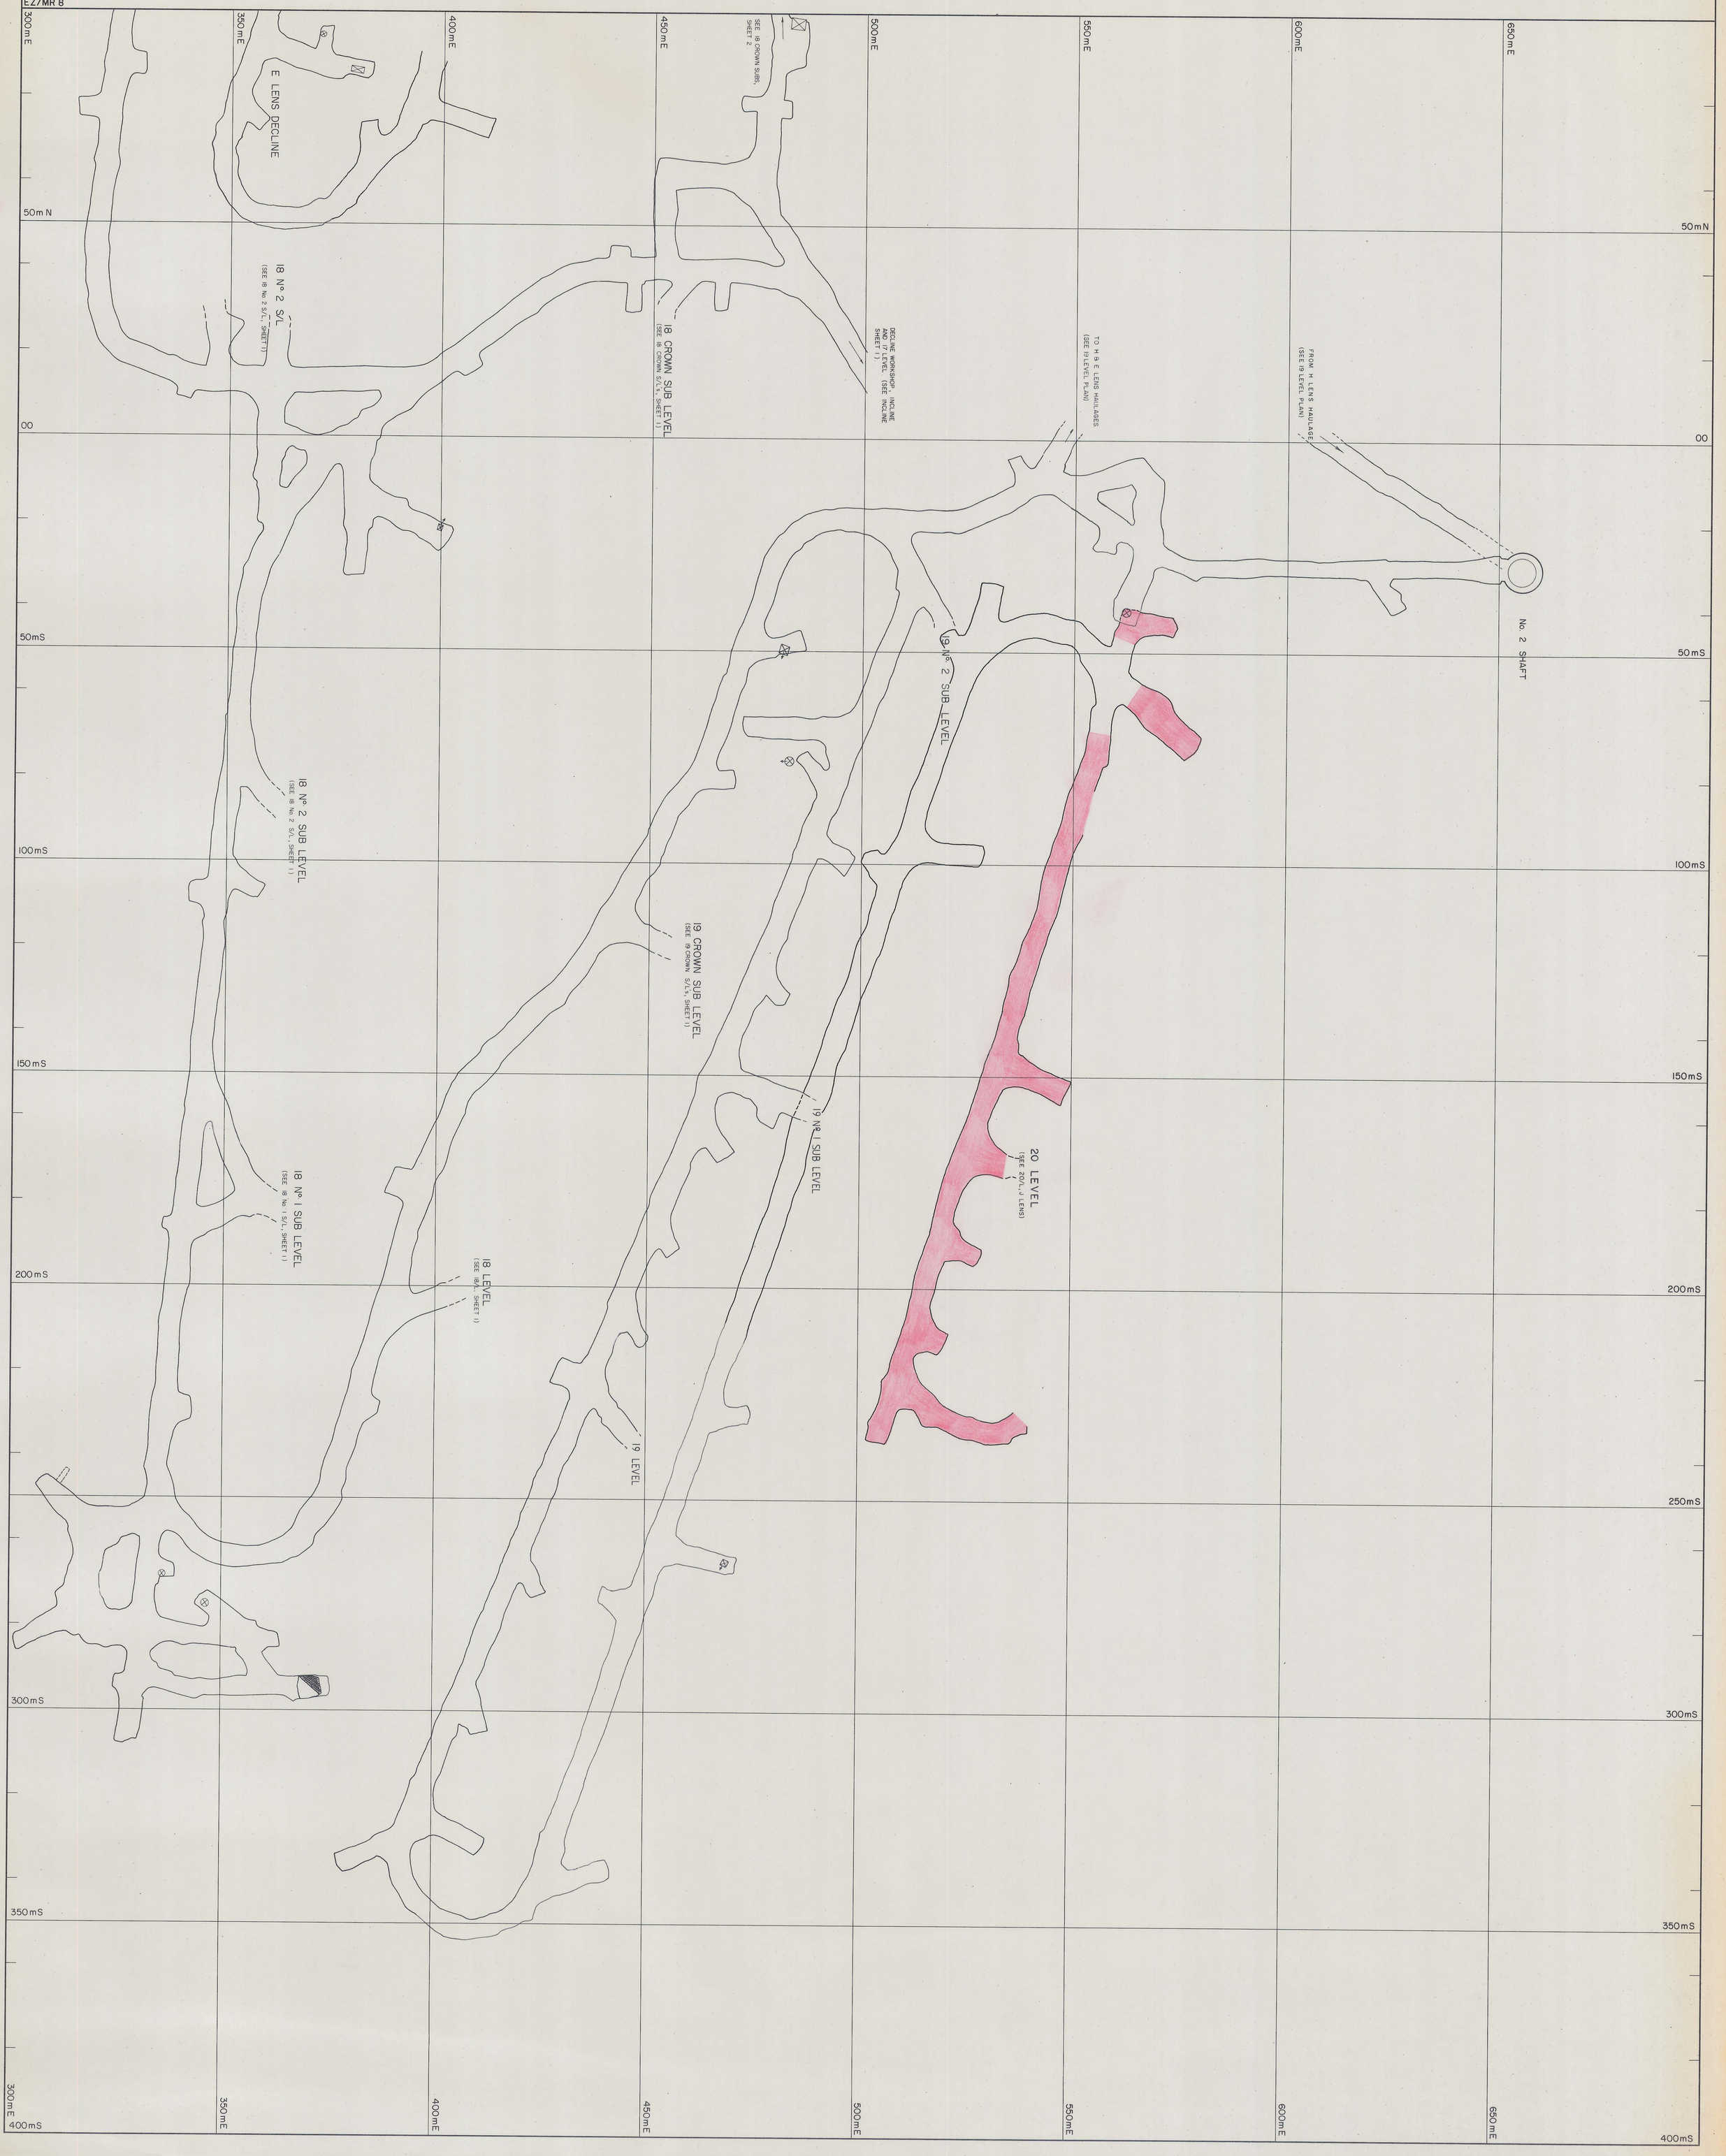

DECLINE, Sheet 1.