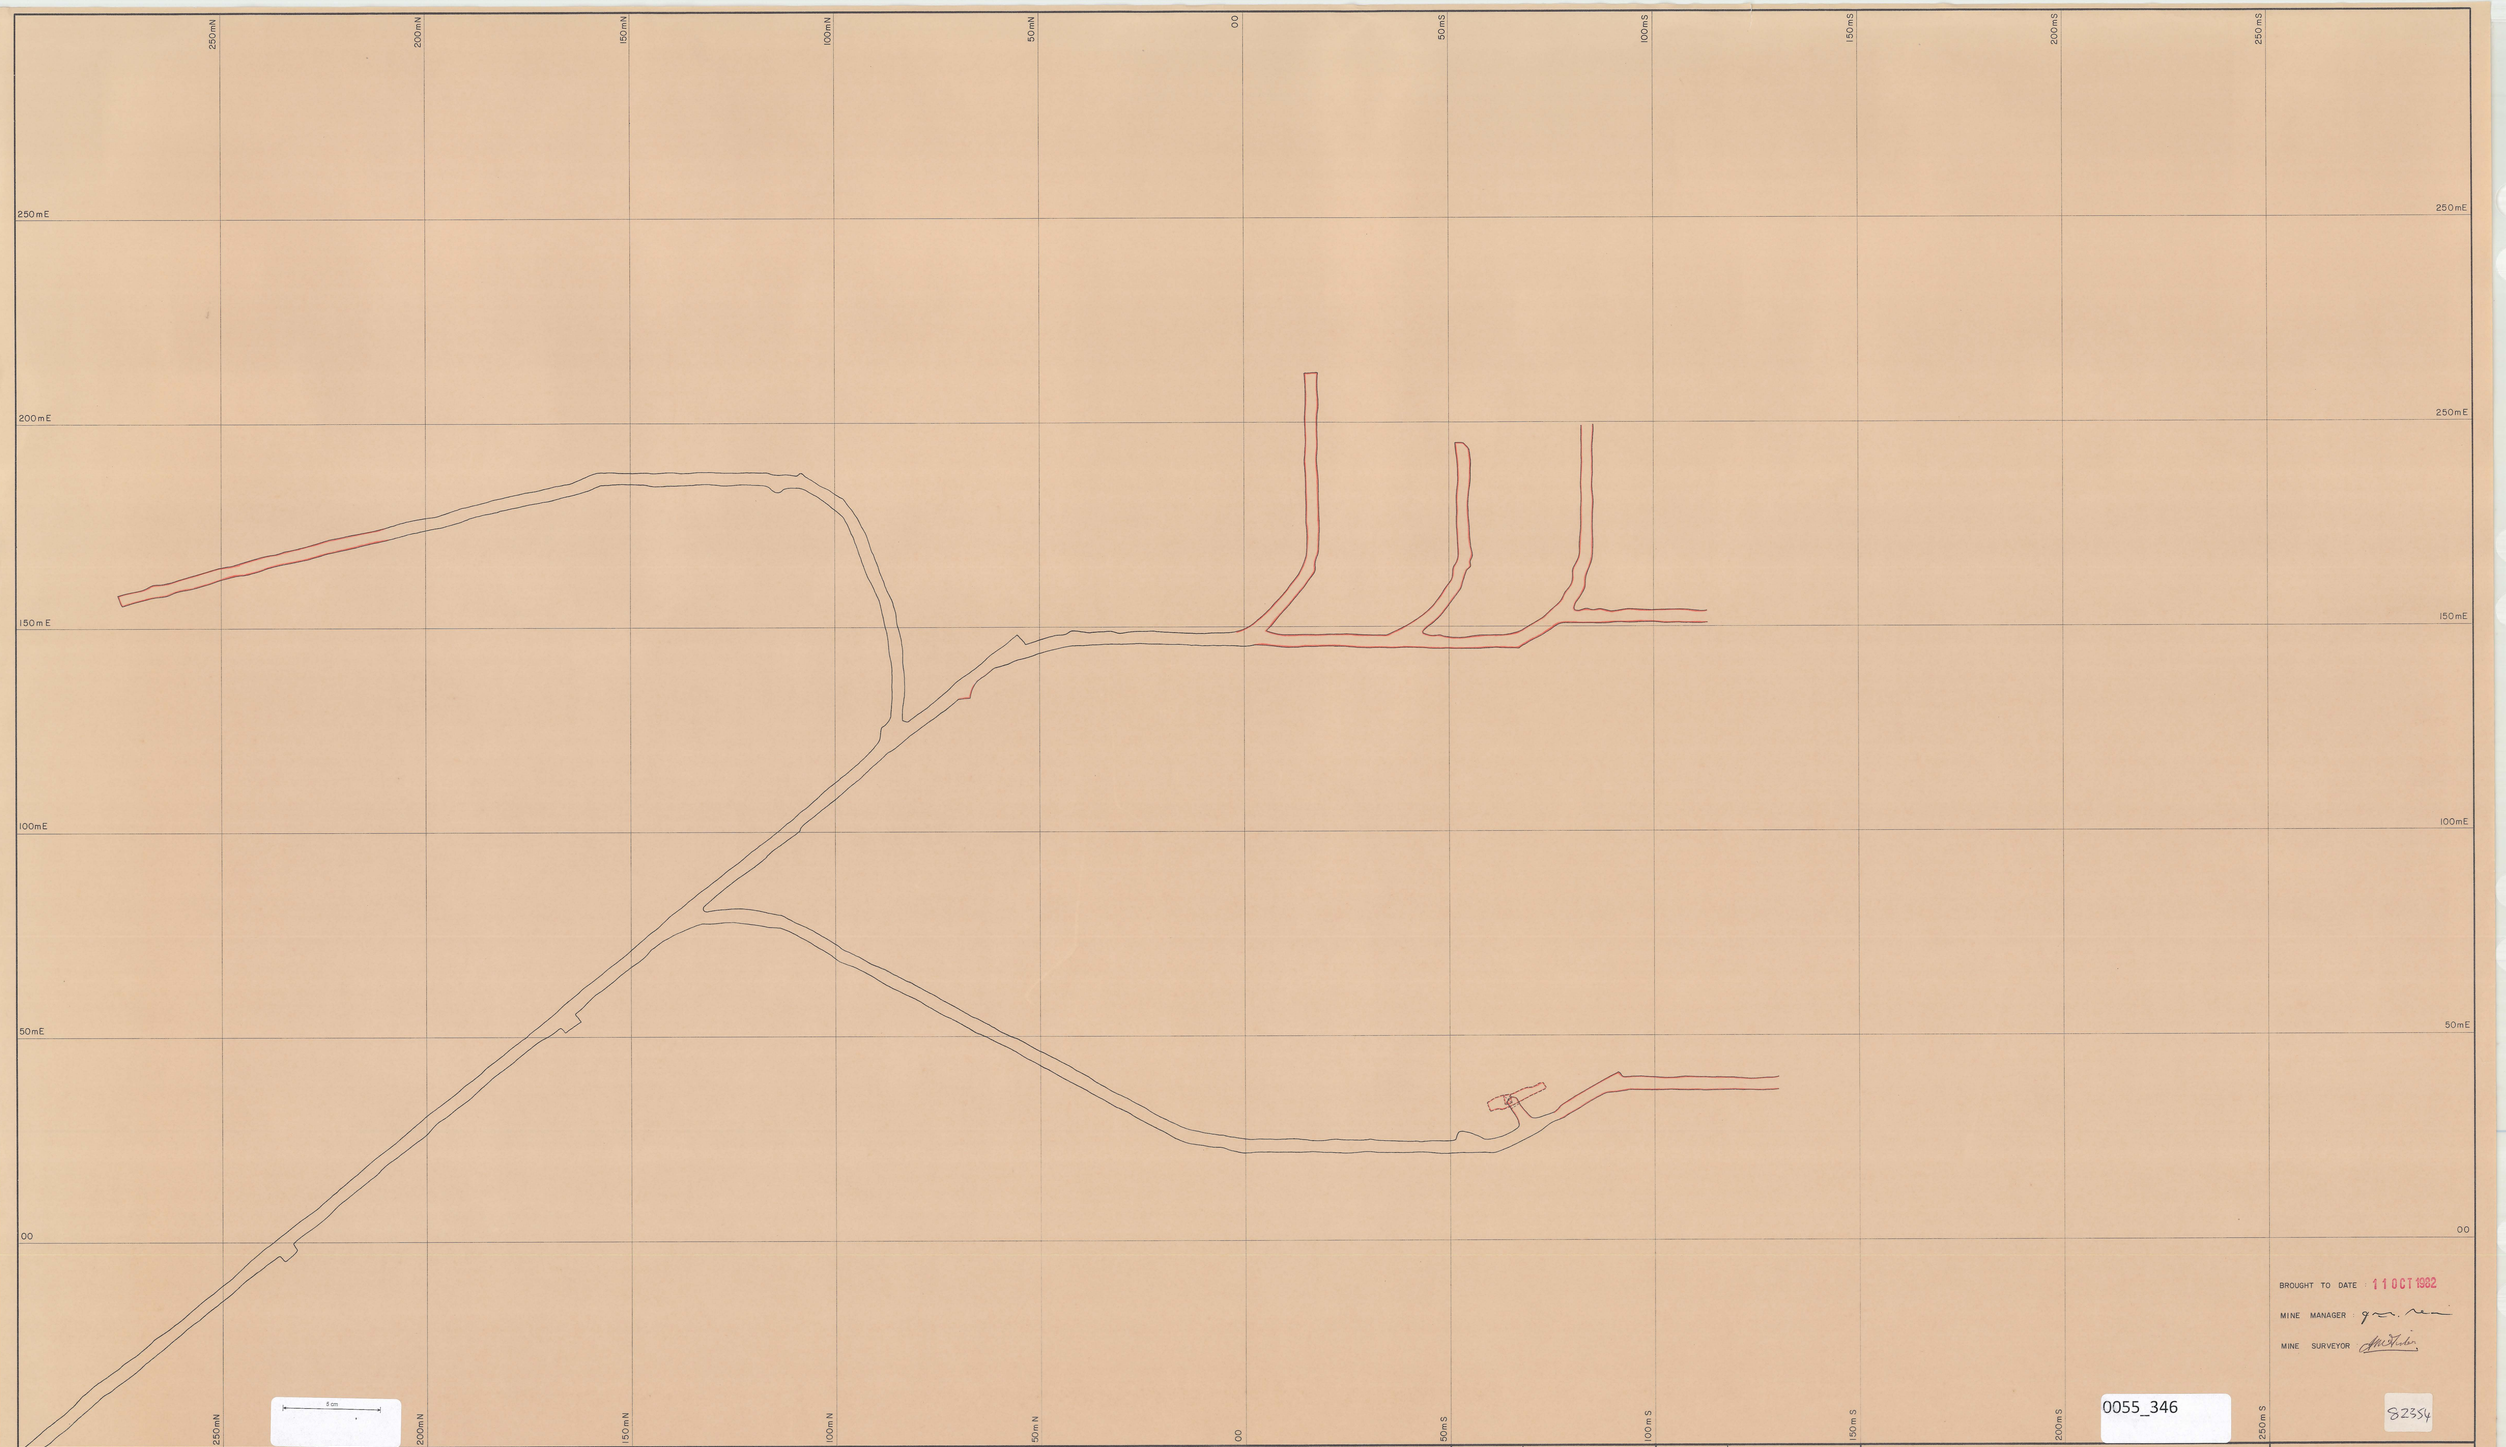

BROUGHT TO DATE 11 OCT 1982

MINE MANAGER

MINE SURVEYOR

0055_346

82354

SCALE SHOWING 1:500 METRES AND EQUIVALENT FEET

0 25 50 75 100 Metres

0 100 200 300 400 Feet

ELECTROLYTIC ZINC COMPANY OF AUSTRALASIA LIMITED

WEST COAST MINES, TAS.

SURVEY BY		SCALE	1:500
DRAWN BY		DATE	20·3·80
TRACED BY	G.M. BENNETT	REFERENCE	

HERCULES MINE

Nº 7 LEVEL (2)

DRAWING Nº:

(2) (1)

0055_346