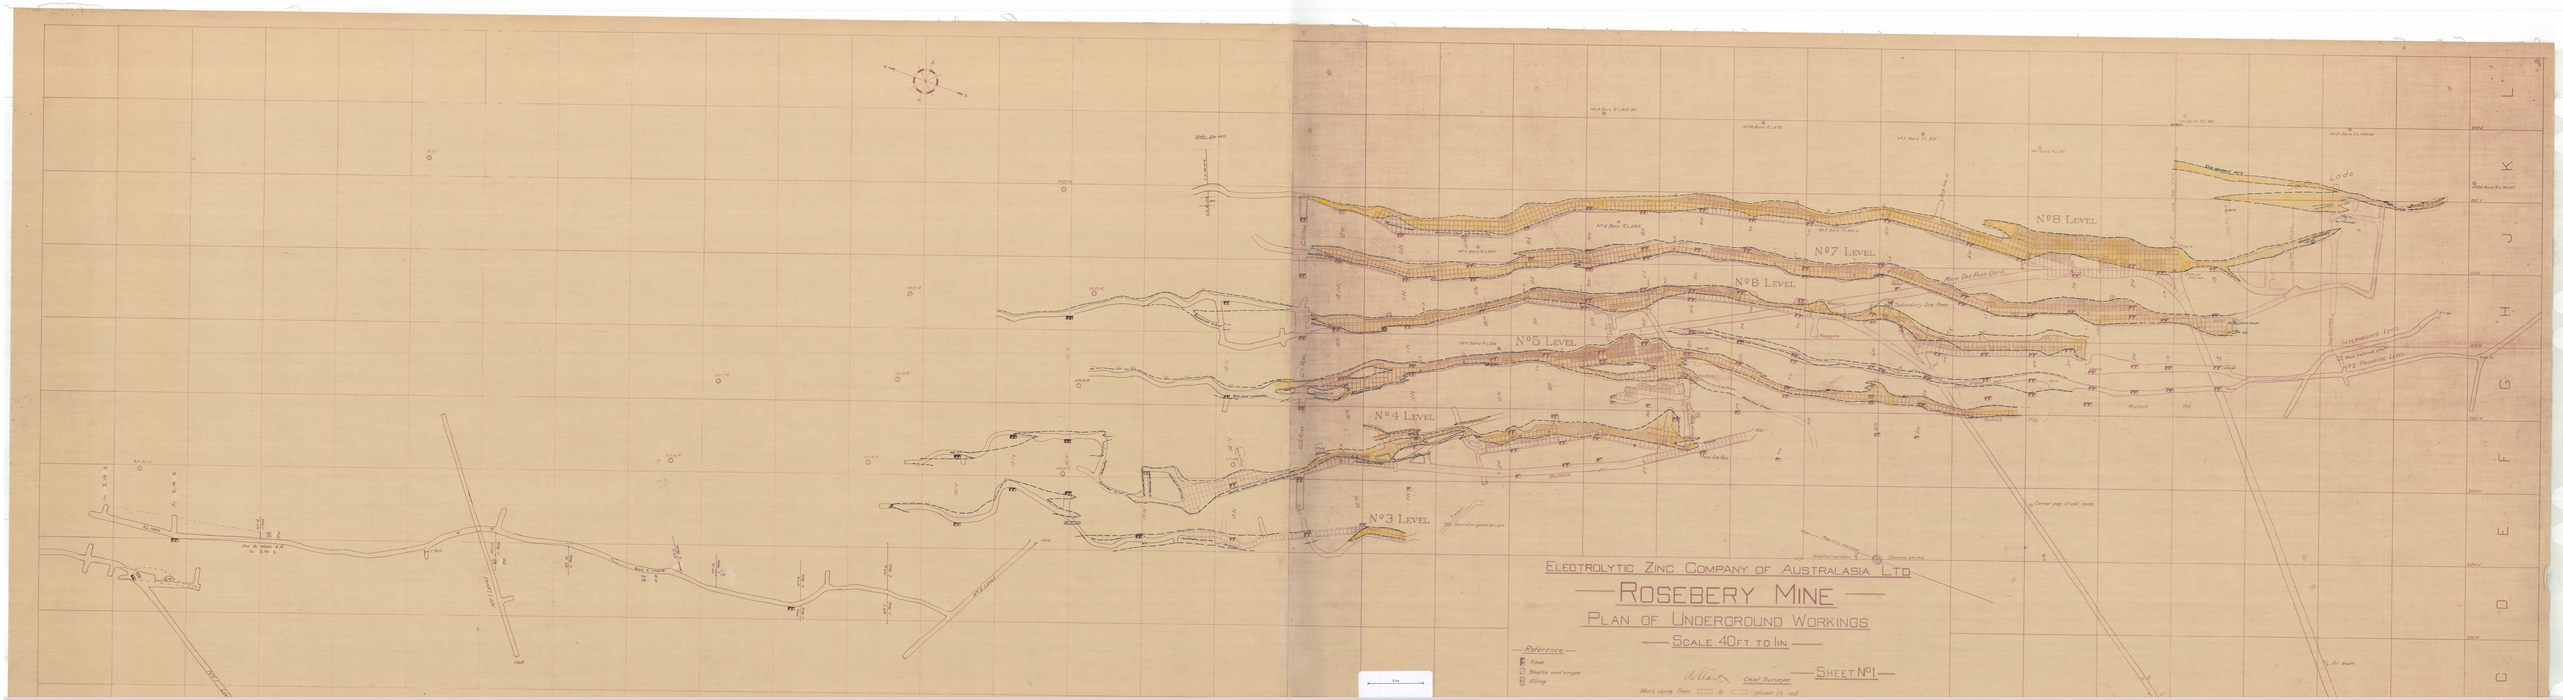
No 8 Level
No 7 Level
No 6 Level
No 5 Level
No 4 Level
No 3 Level
Lode
Main Cut Pass Drive
Intermediate Levels
No 2 Haulage Level
Electrolytic Zinc Company of Australasia Ltd
Rosebery Mine
Plan of Underground Workings
Scale 40 ft to 1 in
Reference
Rises
Shafts and winzes
Filling
Chief Surveyor
Sheet No 1
Work done from to shown in red
Sheet No 2
West Coast Works
Plan of Rosebery Mine
Electrolytic Zinc Co. of Australasia Ltd
Rosebery
X3
X3R-1