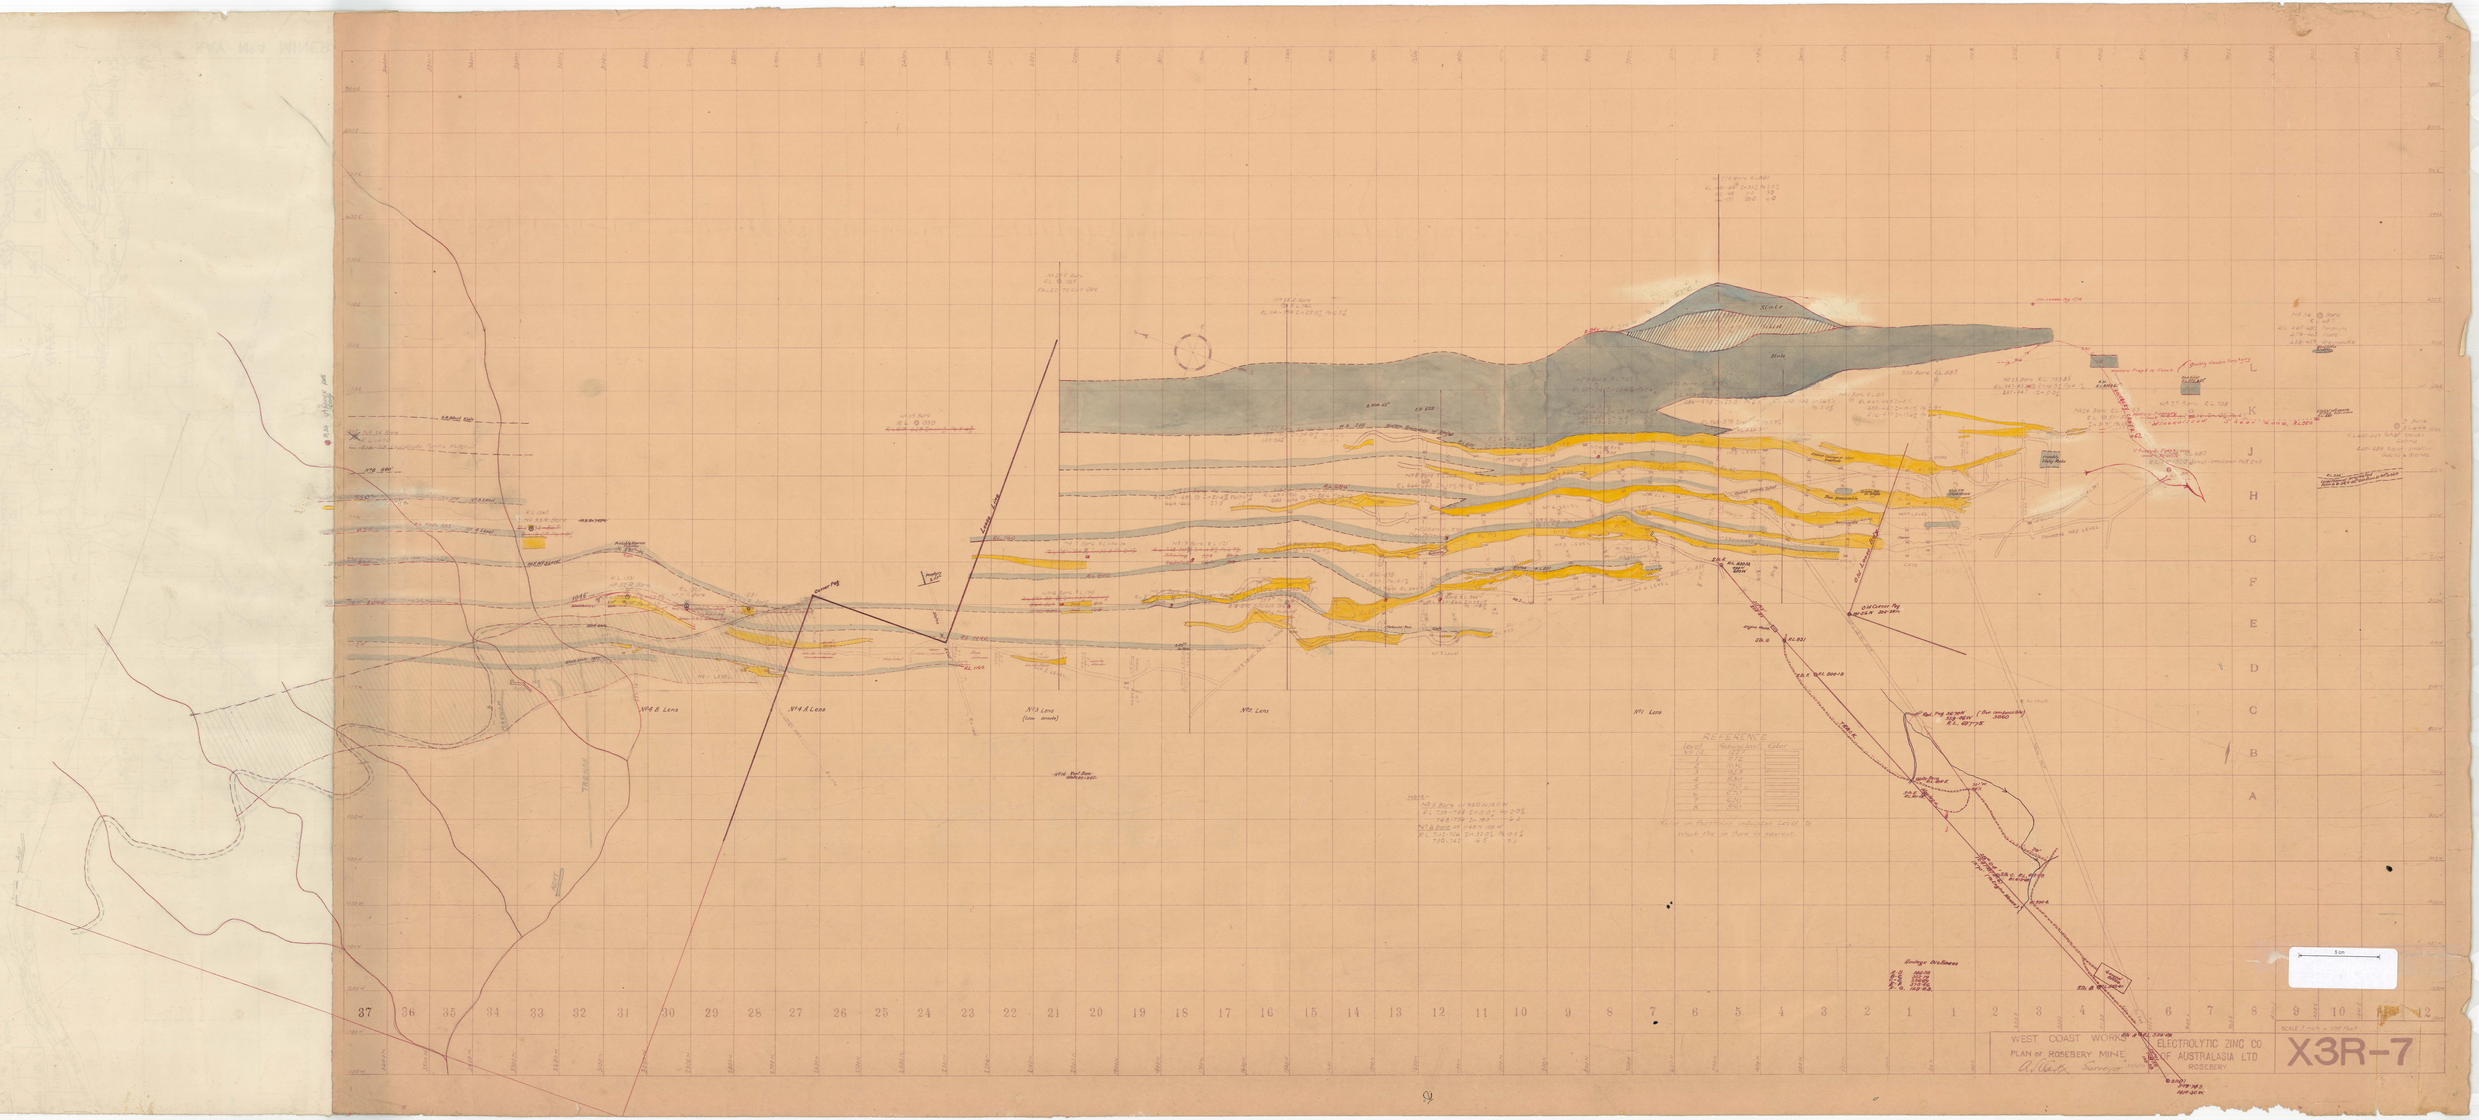
WEST COAST WORKS
PLAN of ROSEBERY MINE
ELECTROLYTIC ZINC CO
OF AUSTRALASIA LTD
ROSEBERY
X3R-7
N°4 B Lens
N°4 A Lens
N°3 Lens
(low grade)
N°2 Lens
N°1 Lens
REFERENCE
Level
Symbol
Colour
Keep on Portside indicates Level 0
South to go Rore to Level
Hardings Drillraises
Surveyor
Scale
37 36 35 34 33 32 31 30 29 28 27 26 25 24 23 22 21 20 19 18 17 16 15 14 13 12 11 10 9 8 7 6 5 4 3 2 1 1 2 3 4 5 6 7 8 9 10 11 12
L K J H G F E D C B A