

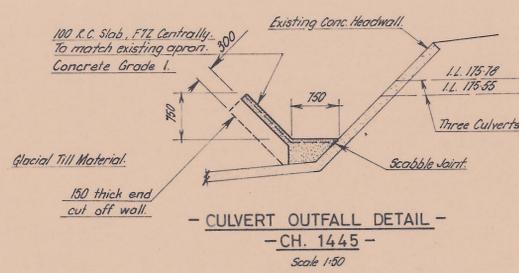
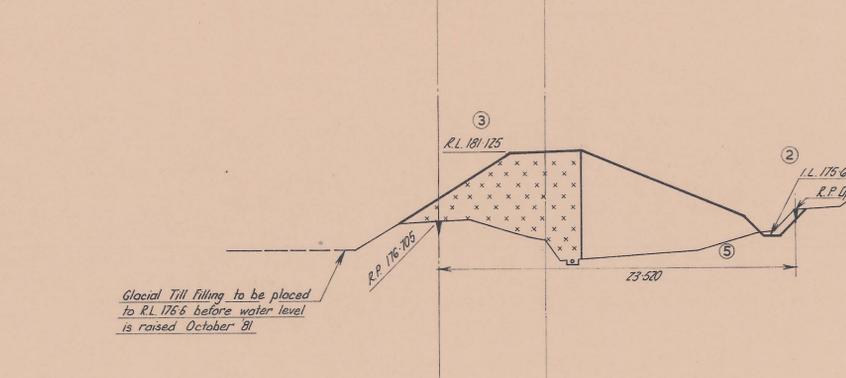
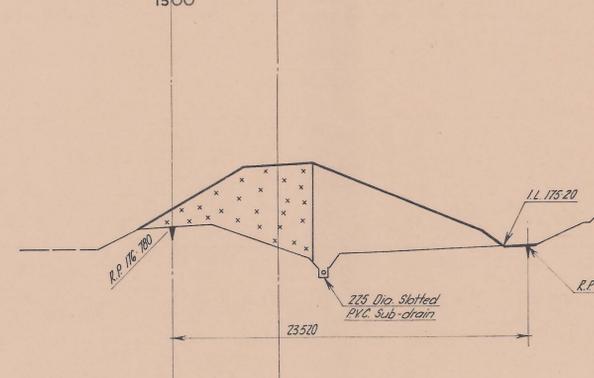
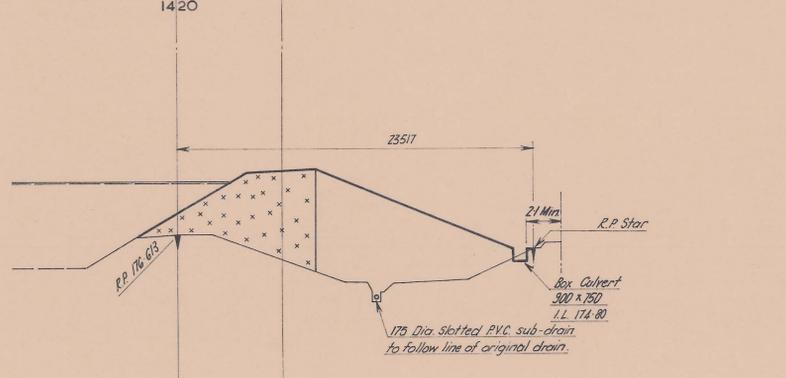
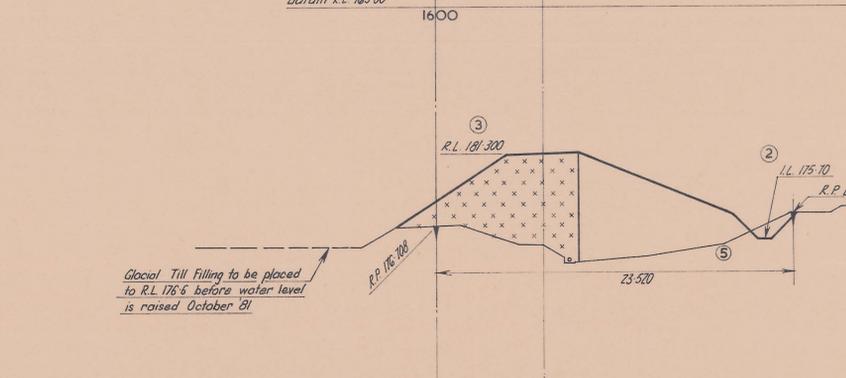
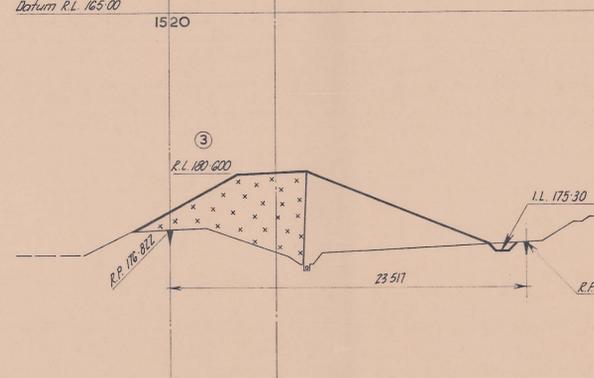
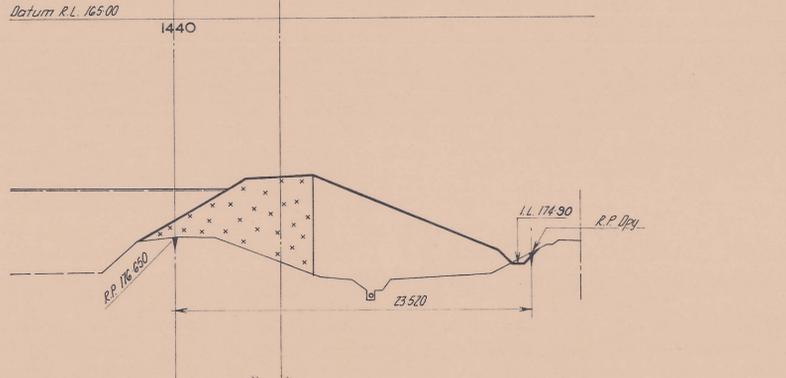
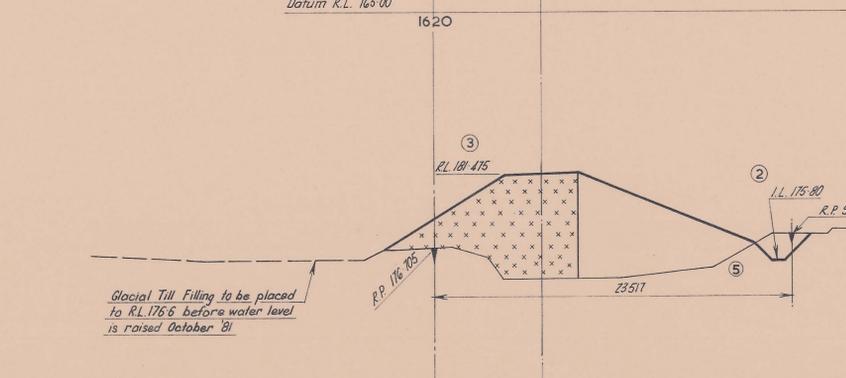
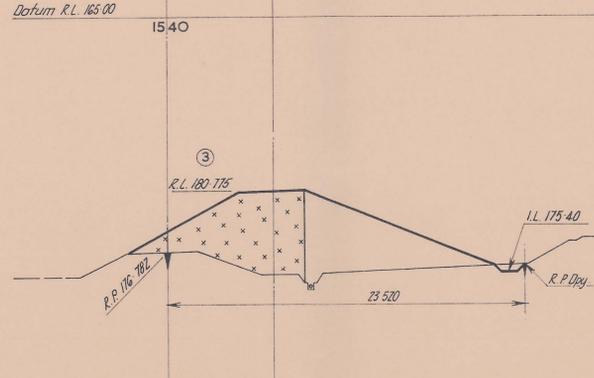
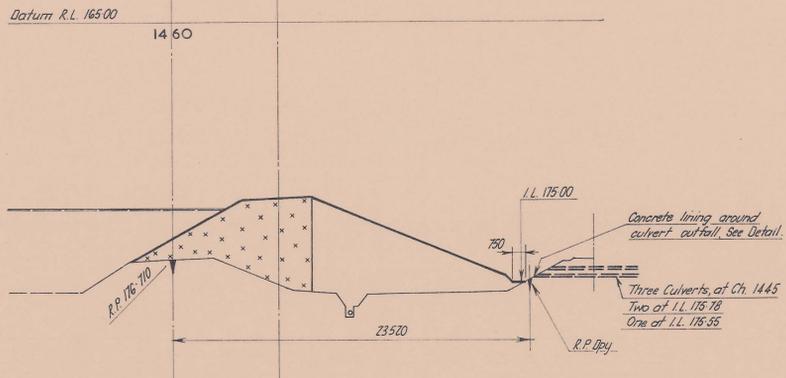



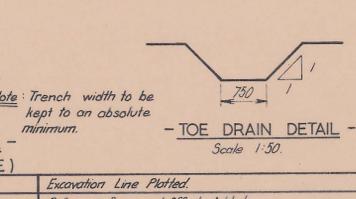

- LEGEND**
- Glacial Till - ZONE 2 Material
 - Glacial Till - ZONE 3 Material in new construction
 - Glacial Till Filling - ZONE 2 Material

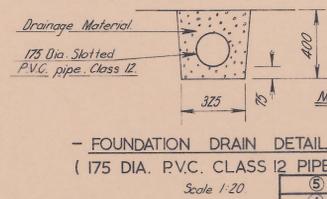

Datum for Levels: Australian Height Datum

RM.FOSTER & ASSOCIATES. DEVONPORT
CONSULTING CHARTERED ENGINEERS BURNIE
HOBART

ELECTROLYTIC ZINC CO. OF ASIA LTD. ROSEBERY

BOBADIL RESIDUE DAM — STAGE 2

CROSS SECTIONS — CHAINAGE 1400 — 1620

SCALE 1:200

APPROVED: *R.M. Foster*

DRAWN: D.S.A.
TRACED: G.R.J.
CHECKED: G.R.J.

DATE: 21/1/81

DRAWING No. **R/G 3214**

SHEET 12/5

K.R. MICHELL AUTHORISED SURVEYOR
INC. URBAN PLANNERS & SURVEYORS
LAND AND ENGINEERING SURVEYS

REVISION No.	DESCRIPTION	DATE	REVISION No.	DESCRIPTION	DATE
5	Excavation Line Plotted.	23-11-81	4	Reference Pegs and Offsets Added.	29-9-81
4	Reference Pegs and Offsets Added.	29-9-81	3	Crest Transition Levels Added Ch 1500 - Ch 1620	7-7-81
3	Crest Transition Levels Added Ch 1500 - Ch 1620	7-7-81	2	Toe Drain Invert Levels Added.	22-6-81
2	Toe Drain Invert Levels Added.	22-6-81	1	Dam Realigned From Ch 1560	12-6-81
1	Dam Realigned From Ch 1560	12-6-81			