




Long Proj<sup>o</sup> 4 to 3 Levels

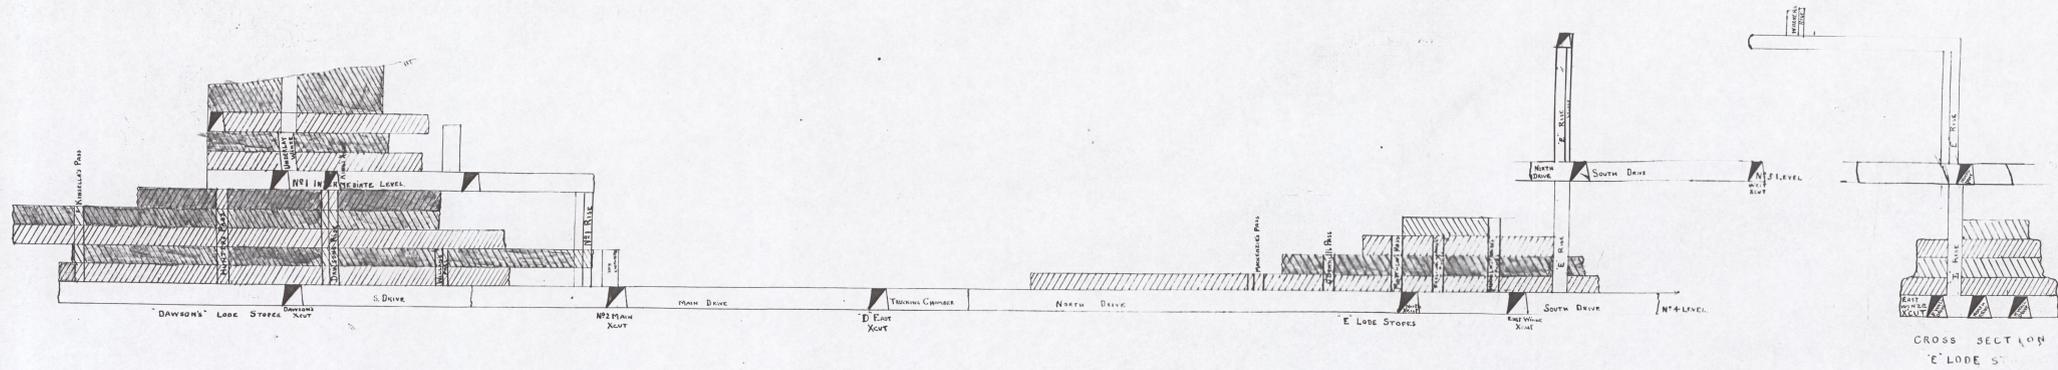

CROSS SECTION 'E' LOADE STOPS

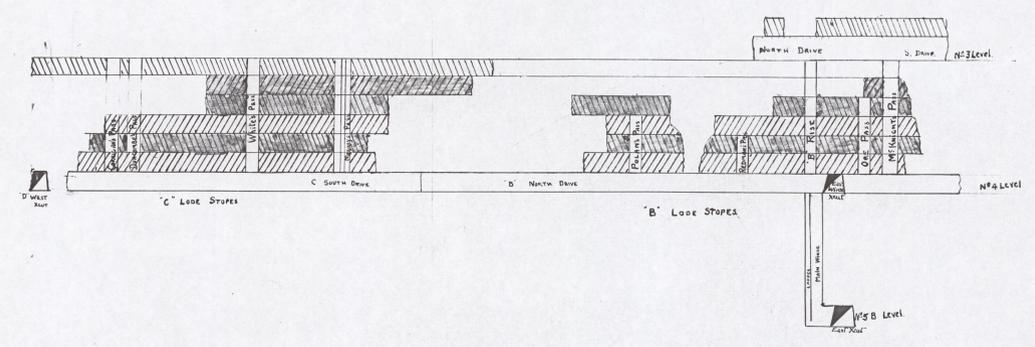


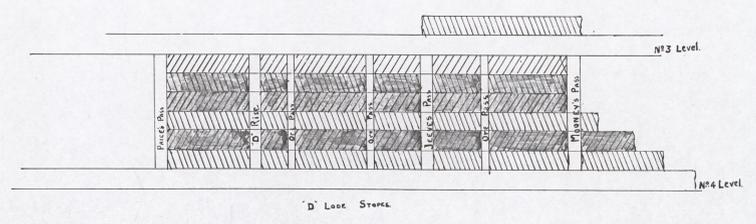

— THE HERCULES C. AND S. M. C<sup>o</sup> —



LONGITUDINAL AND CROSS SECTIONS OF STOPS