


P lode  
 70,000 T ore below 6L  
 2.1% Pb, 8.5% Zn, 0.3% Cu  
 0.9 oz. Ag, 0.6 oz. Au, 6.7% Fe

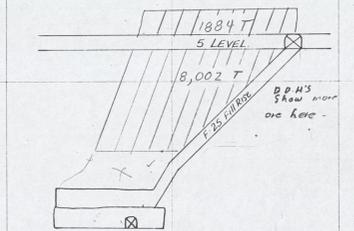

J Lode F/W (J6)

Some drilling to be done here soon.

129 T in 6 level back @ 816-847W  
 R lode below 6L - 3,728 T + 3,169 T  
 To be drilled soon

BROUGHT TO DATE: As at 6/72  
 MINE SURVEYOR: [Signature]  
 MINE MANAGER: [Signature]

HERCULES MINE  
 LONGITUDINAL PROJECTIONS  
 MINES DEPT PLAN

12-3-57

LONGITUDINAL PROJECTIONS

1" = 40'

0055-1  
 721