


LONGITUDINAL PROJECTION L WEST & M LODES

0055-
723

Longit L west & M lodes.

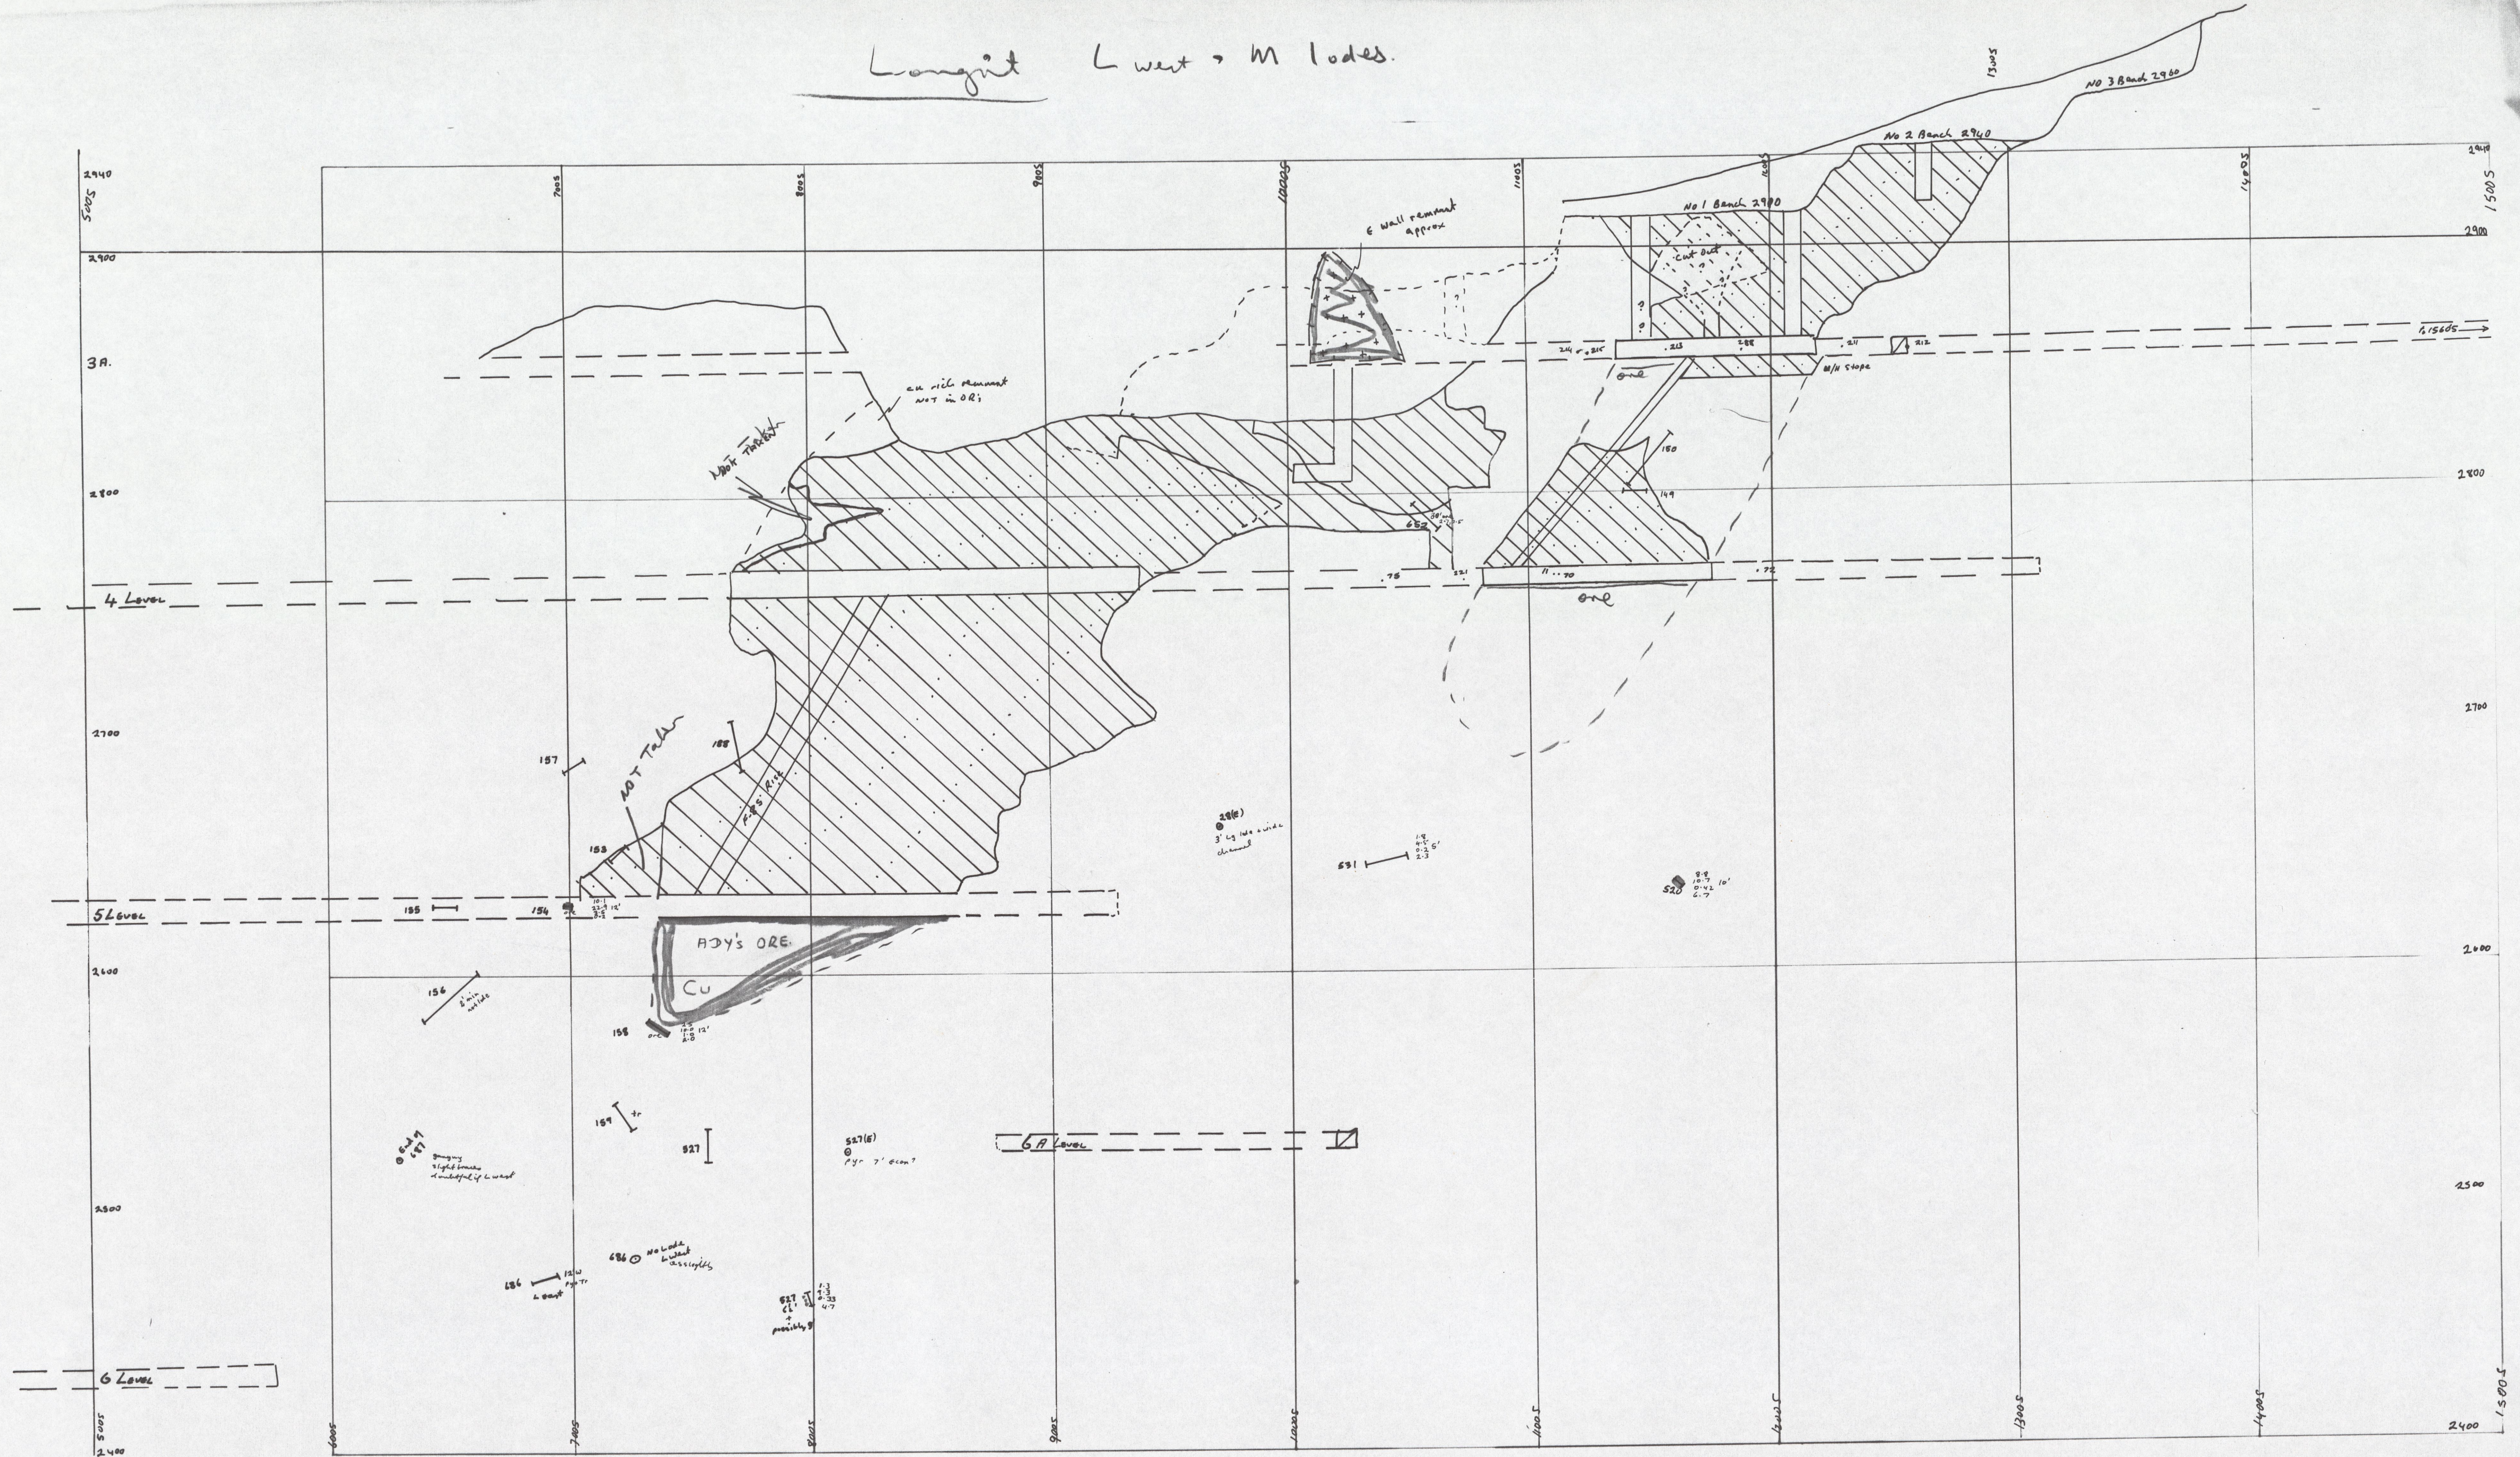

5 cm