


0055-744

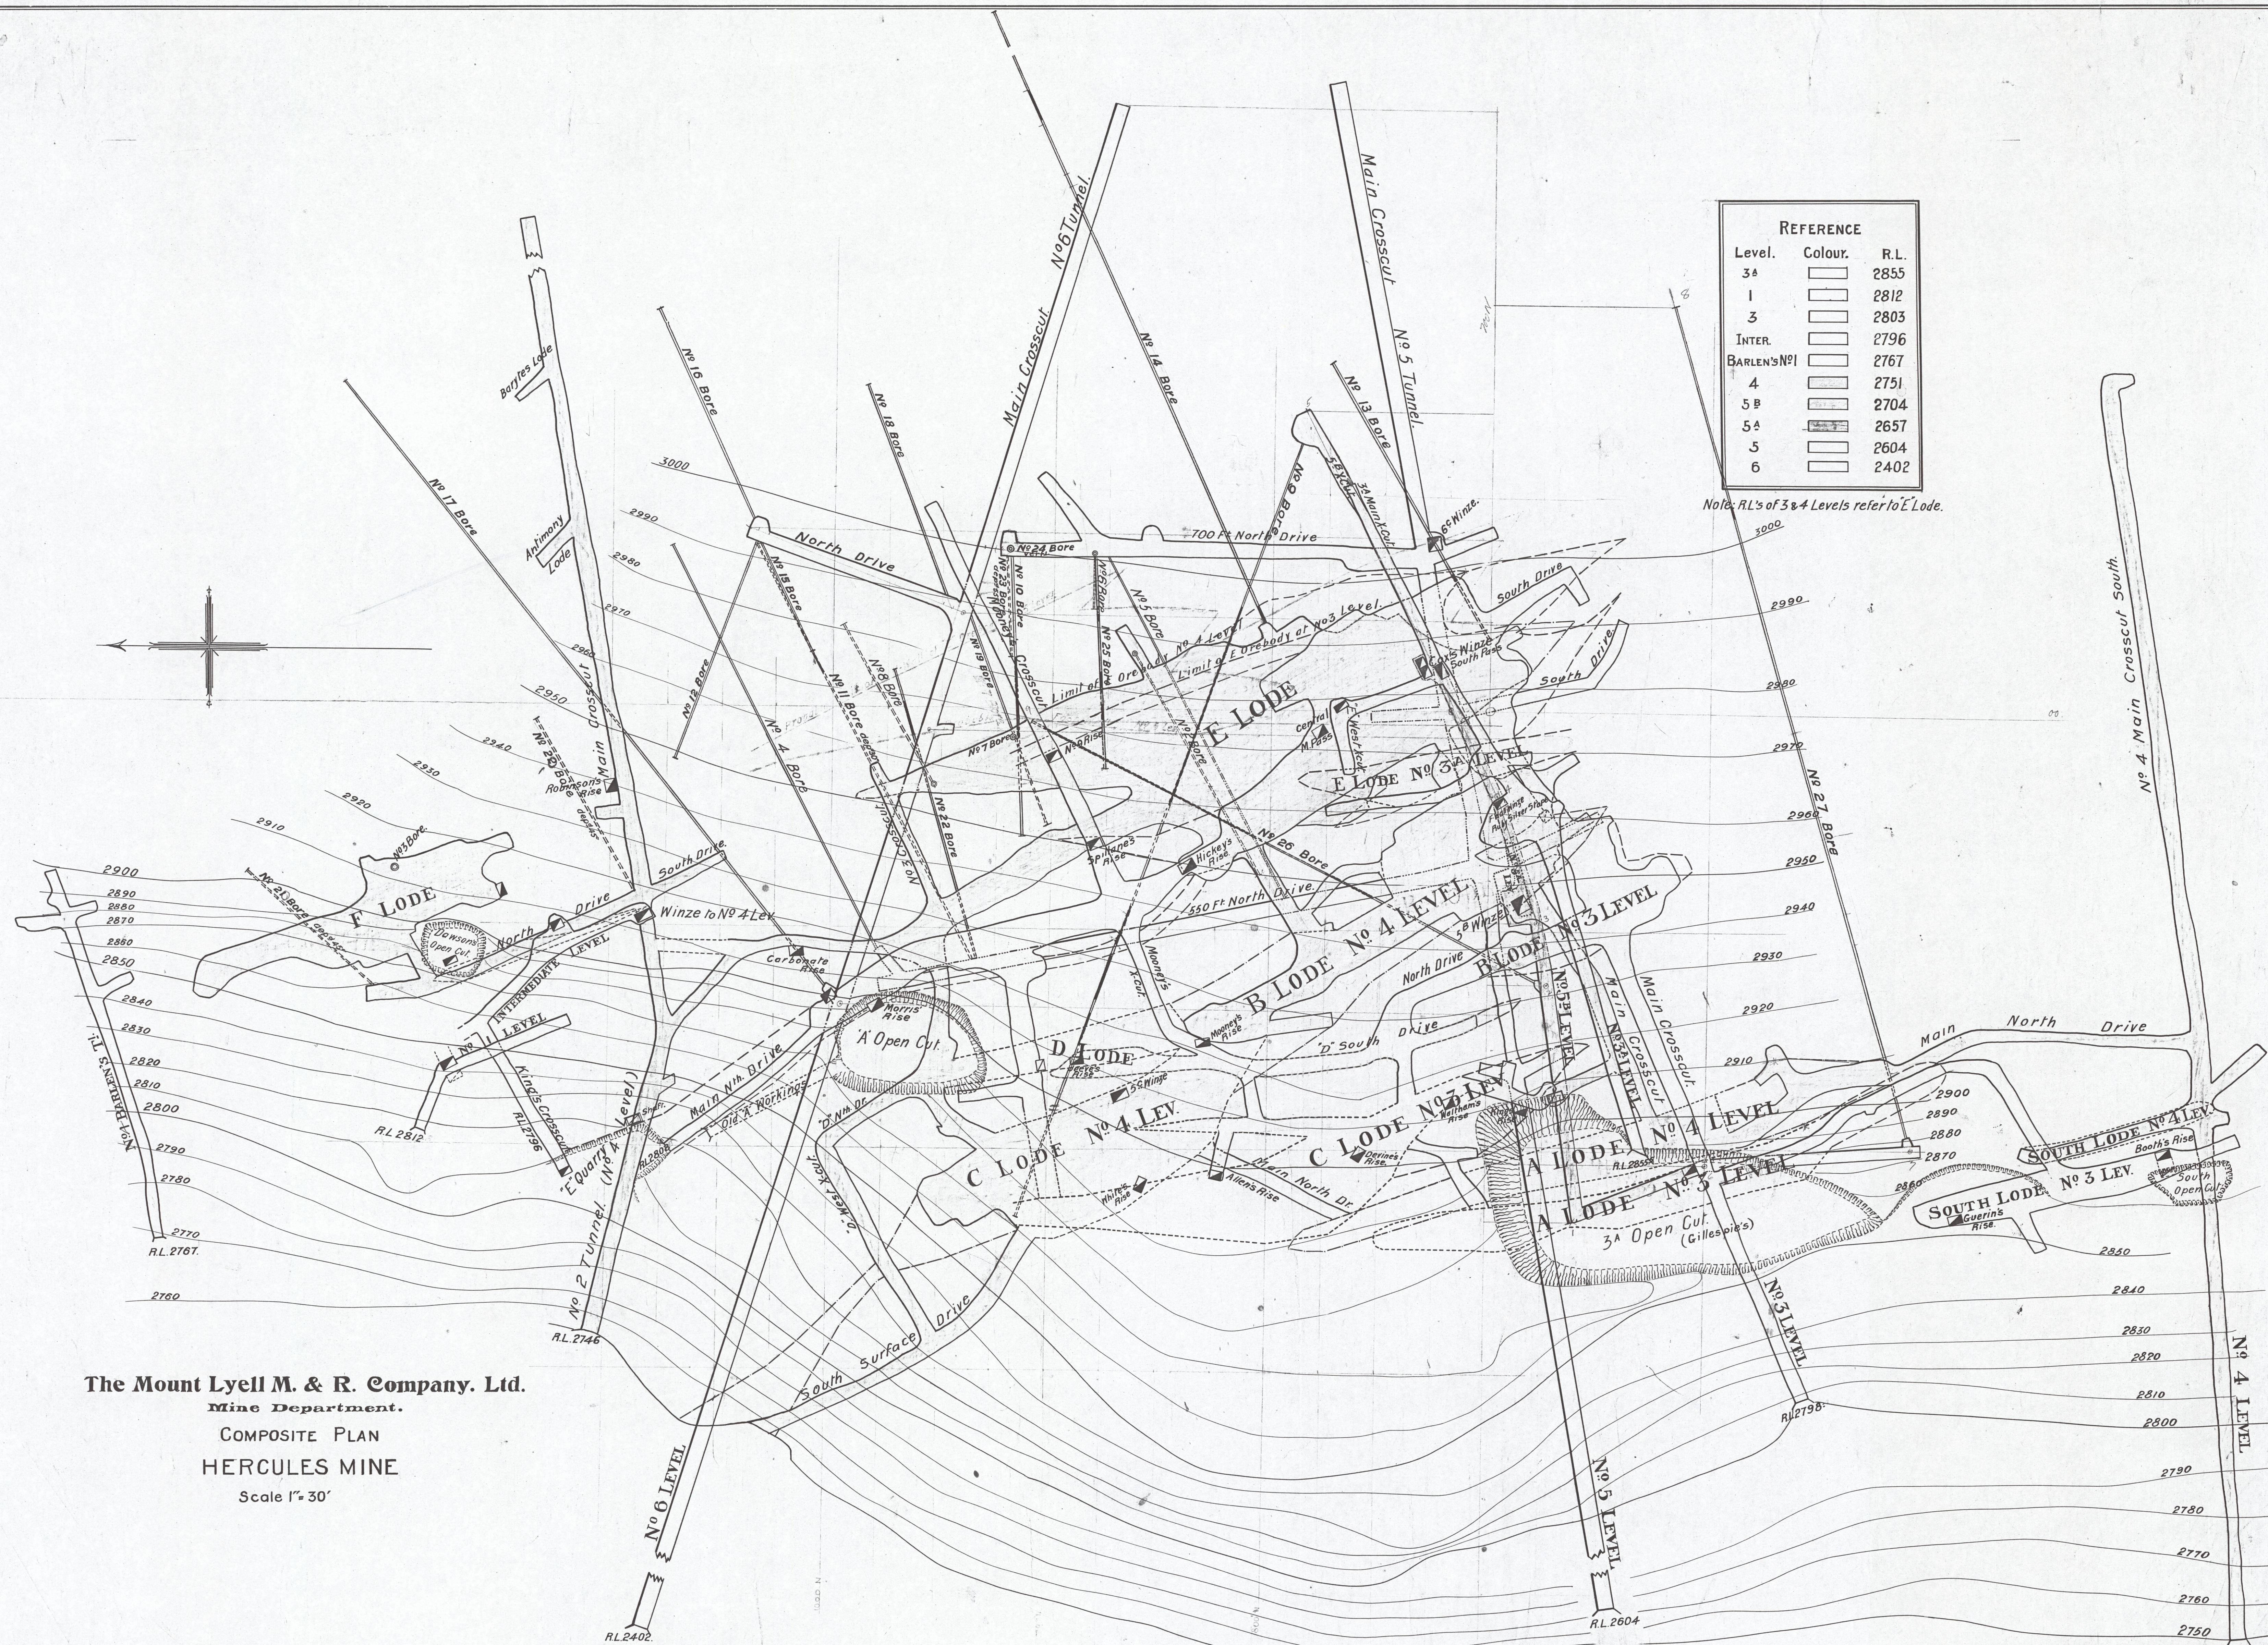

REFERENCE		
Level.	Colour.	R.L.
3A		2855
1		2812
3		2803
INTER.		2796
BARLEN'S NO 1		2767
4		2751
5B		2704
5A		2657
5		2604
6		2402

Note: R.L.'s of 3 & 4 Levels refer to E Lode.

The Mount Lyell M. & R. Company. Ltd.
Mine Department.
COMPOSITE PLAN
HERCULES MINE
Scale 1" = 30'

All relevant information
referred to new
survey plan, Sept 1960
This drawing is not required
to be kept by survey office.

X2-63

R.L. 27453

B7