



Bore Holes
H32 + H33

0055-804

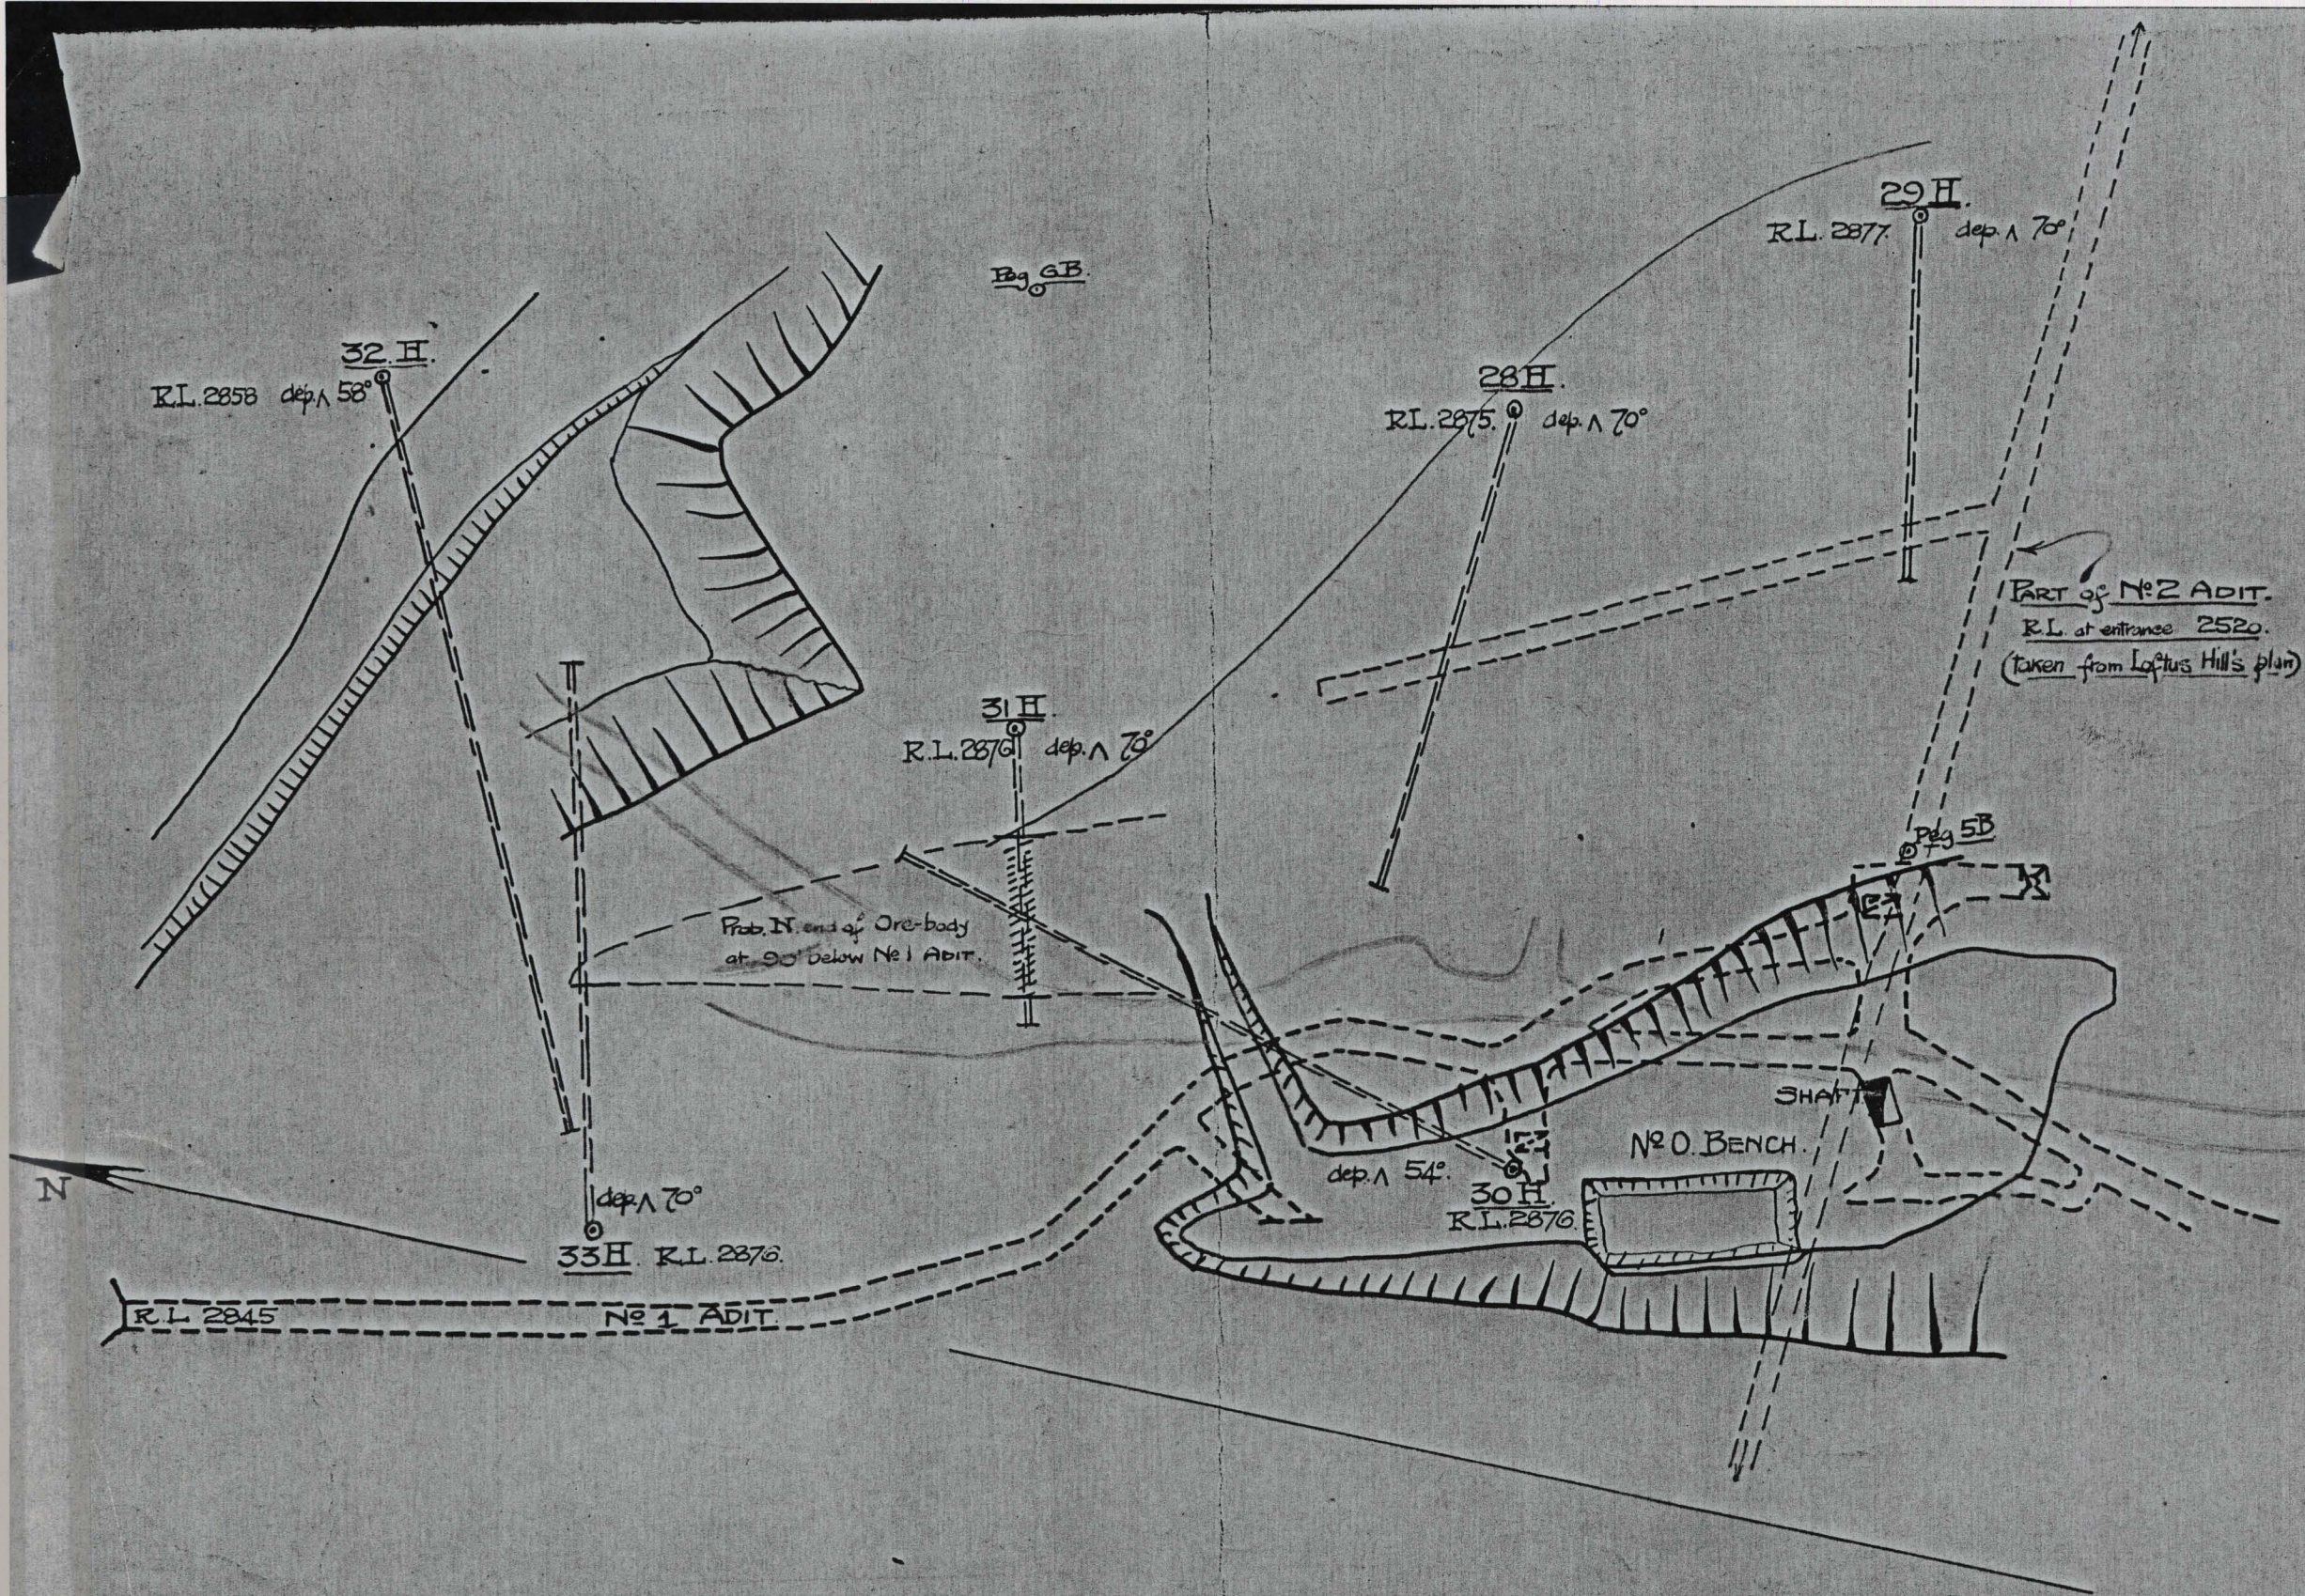

E. Z. C.
PLAN AND SECTIONS
OF MC READ DIAMOND DRILLING.
 Scales: for Plan: 40 ft. to inch.
 for Sections: 100 ft. to inch.

A.V.V.
24/7/37

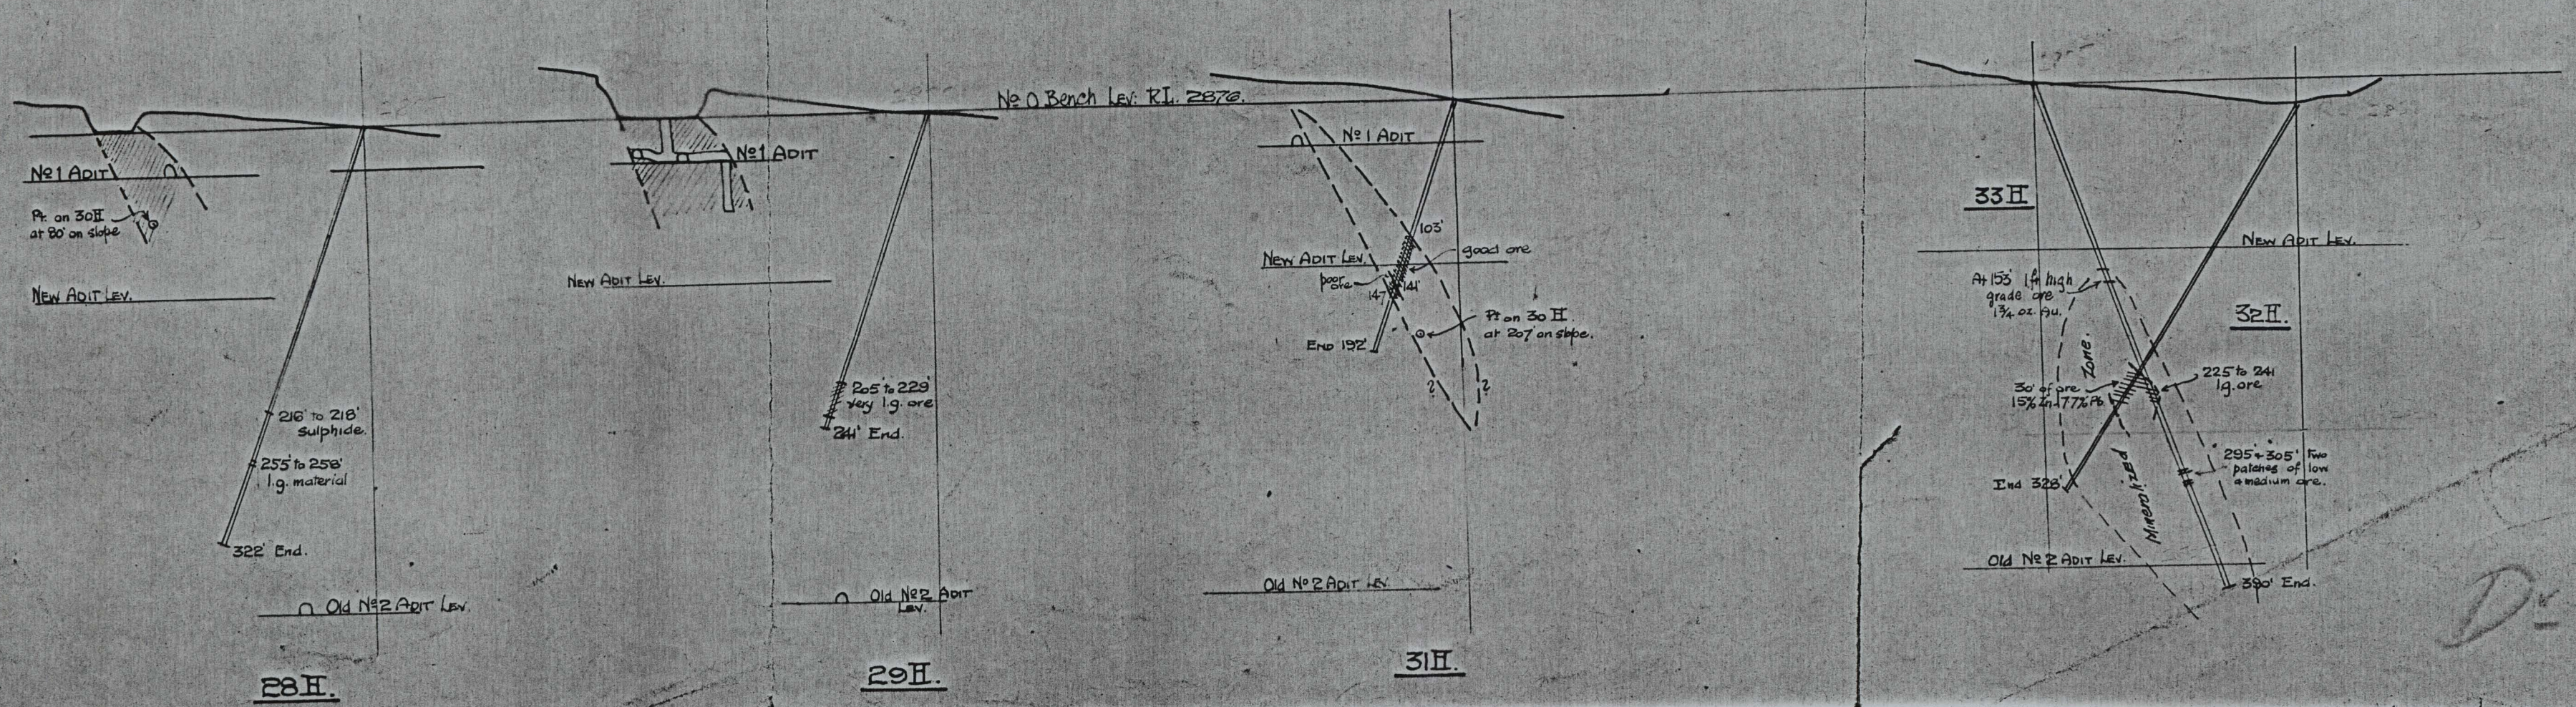

D-38

5 cm