0055-
811

JLK
Sill & Scram

ELECTROLYTIC ZINC COMPANY OF AUSTRALASIA LIMITED

WEST COAST MINES DEPT.

	By	Date
Drawn	S.W.H.	
Traced		
Checked		
Approved		

HERCULES J & K LODE SILLS & SCRAM

SCALE 1:250 FILE

DESIGN S.W.H. DRAWING No.

SURVEY S.W.H.

Revisions	No.	By	Date	Details	App.

Revisions	No.	By	Date	Details	App.
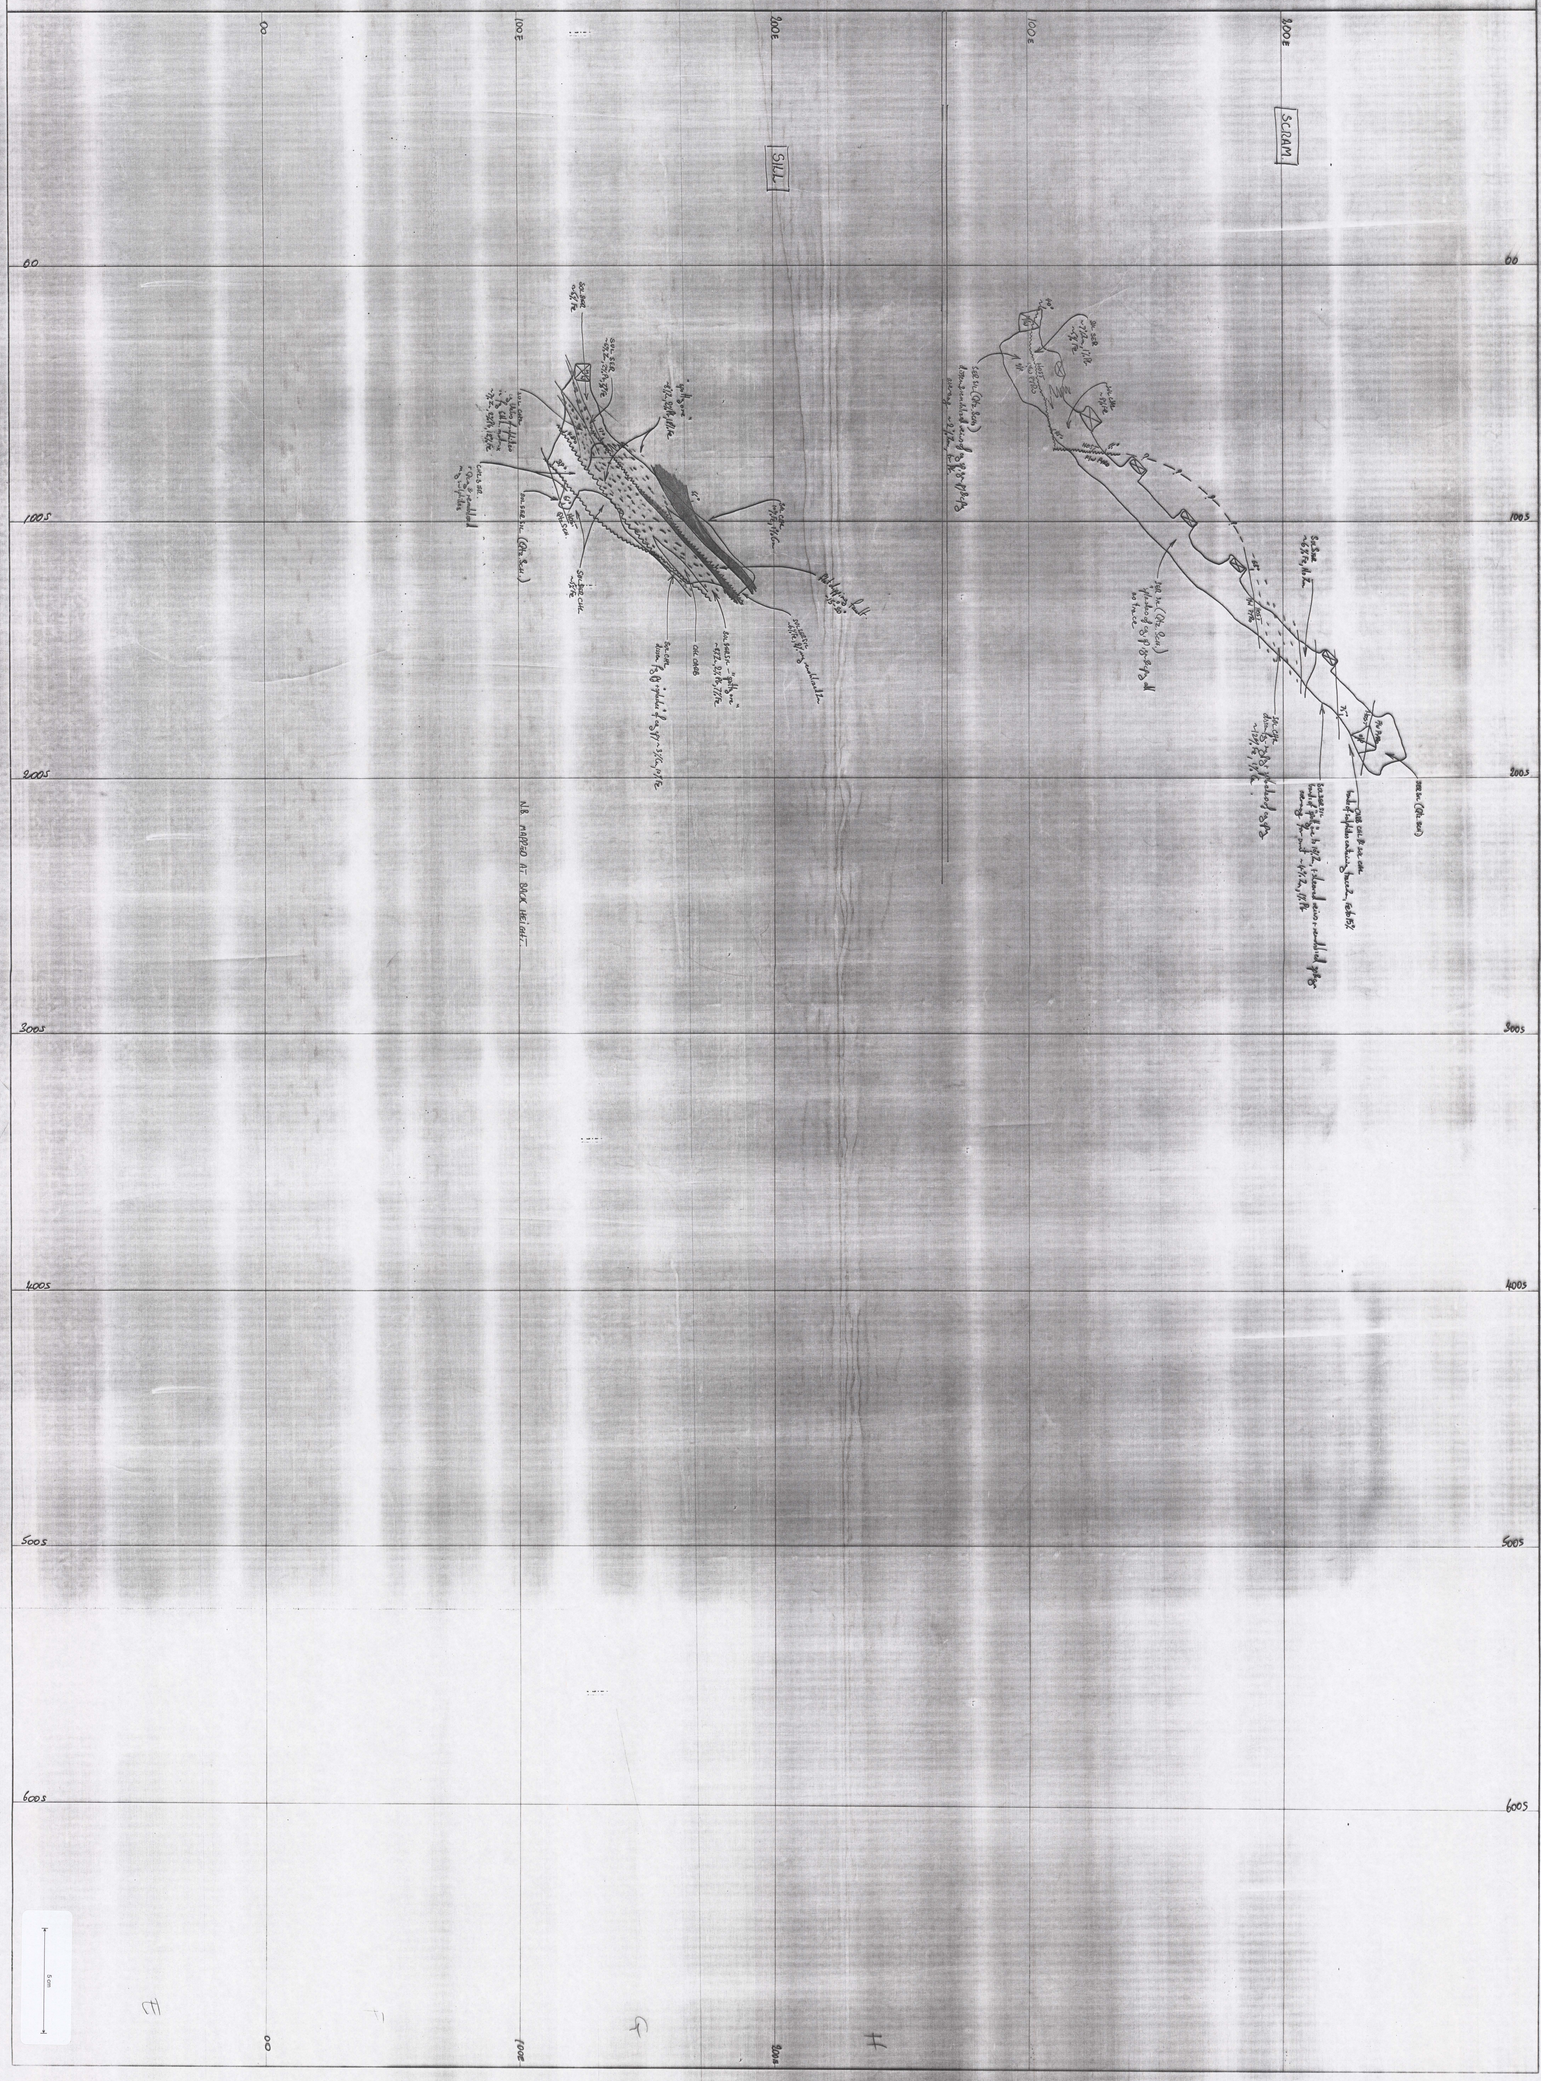
References	No.