


0055-853

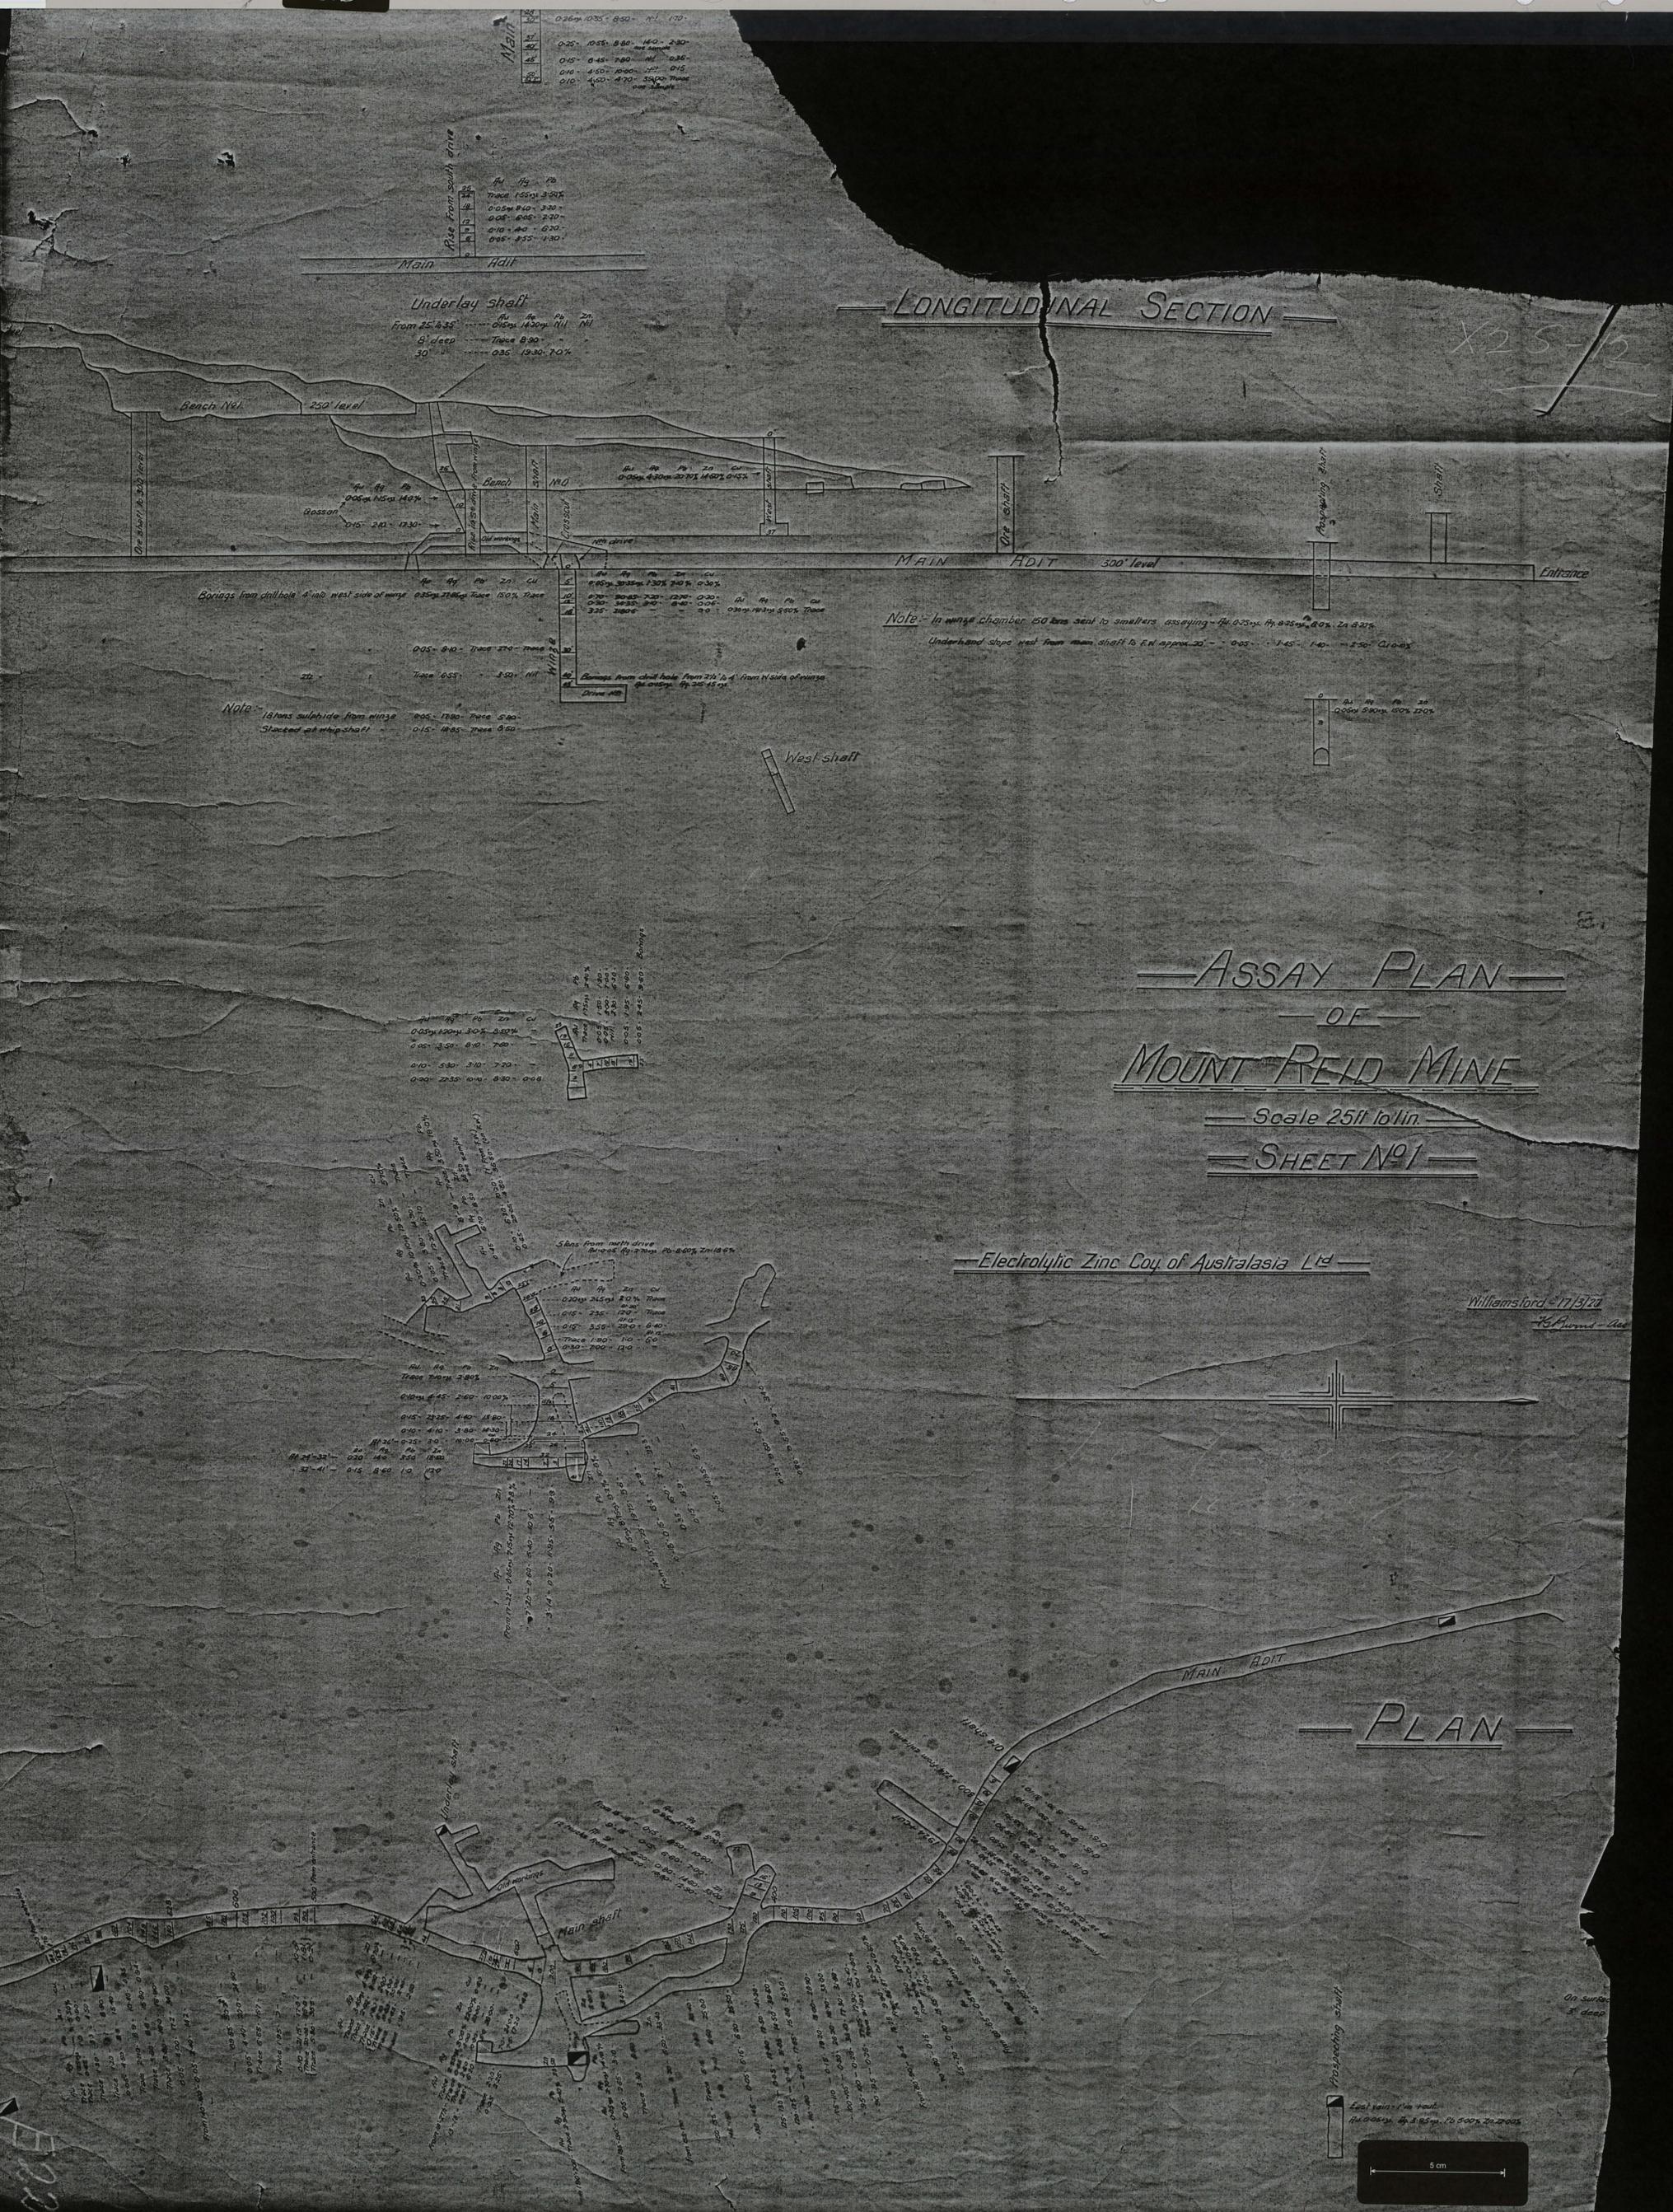

LONGITUDINAL SECTION

ASSAY PLAN  
 OF  
 MOUNT REID MINE  
 Scale 25ft to in.  
 SHEET No 1

Electrolytic Zinc Coy of Australasia Ltd

Williamsford 17/5/20

PLAN

