



3 Level Dev.
1915.

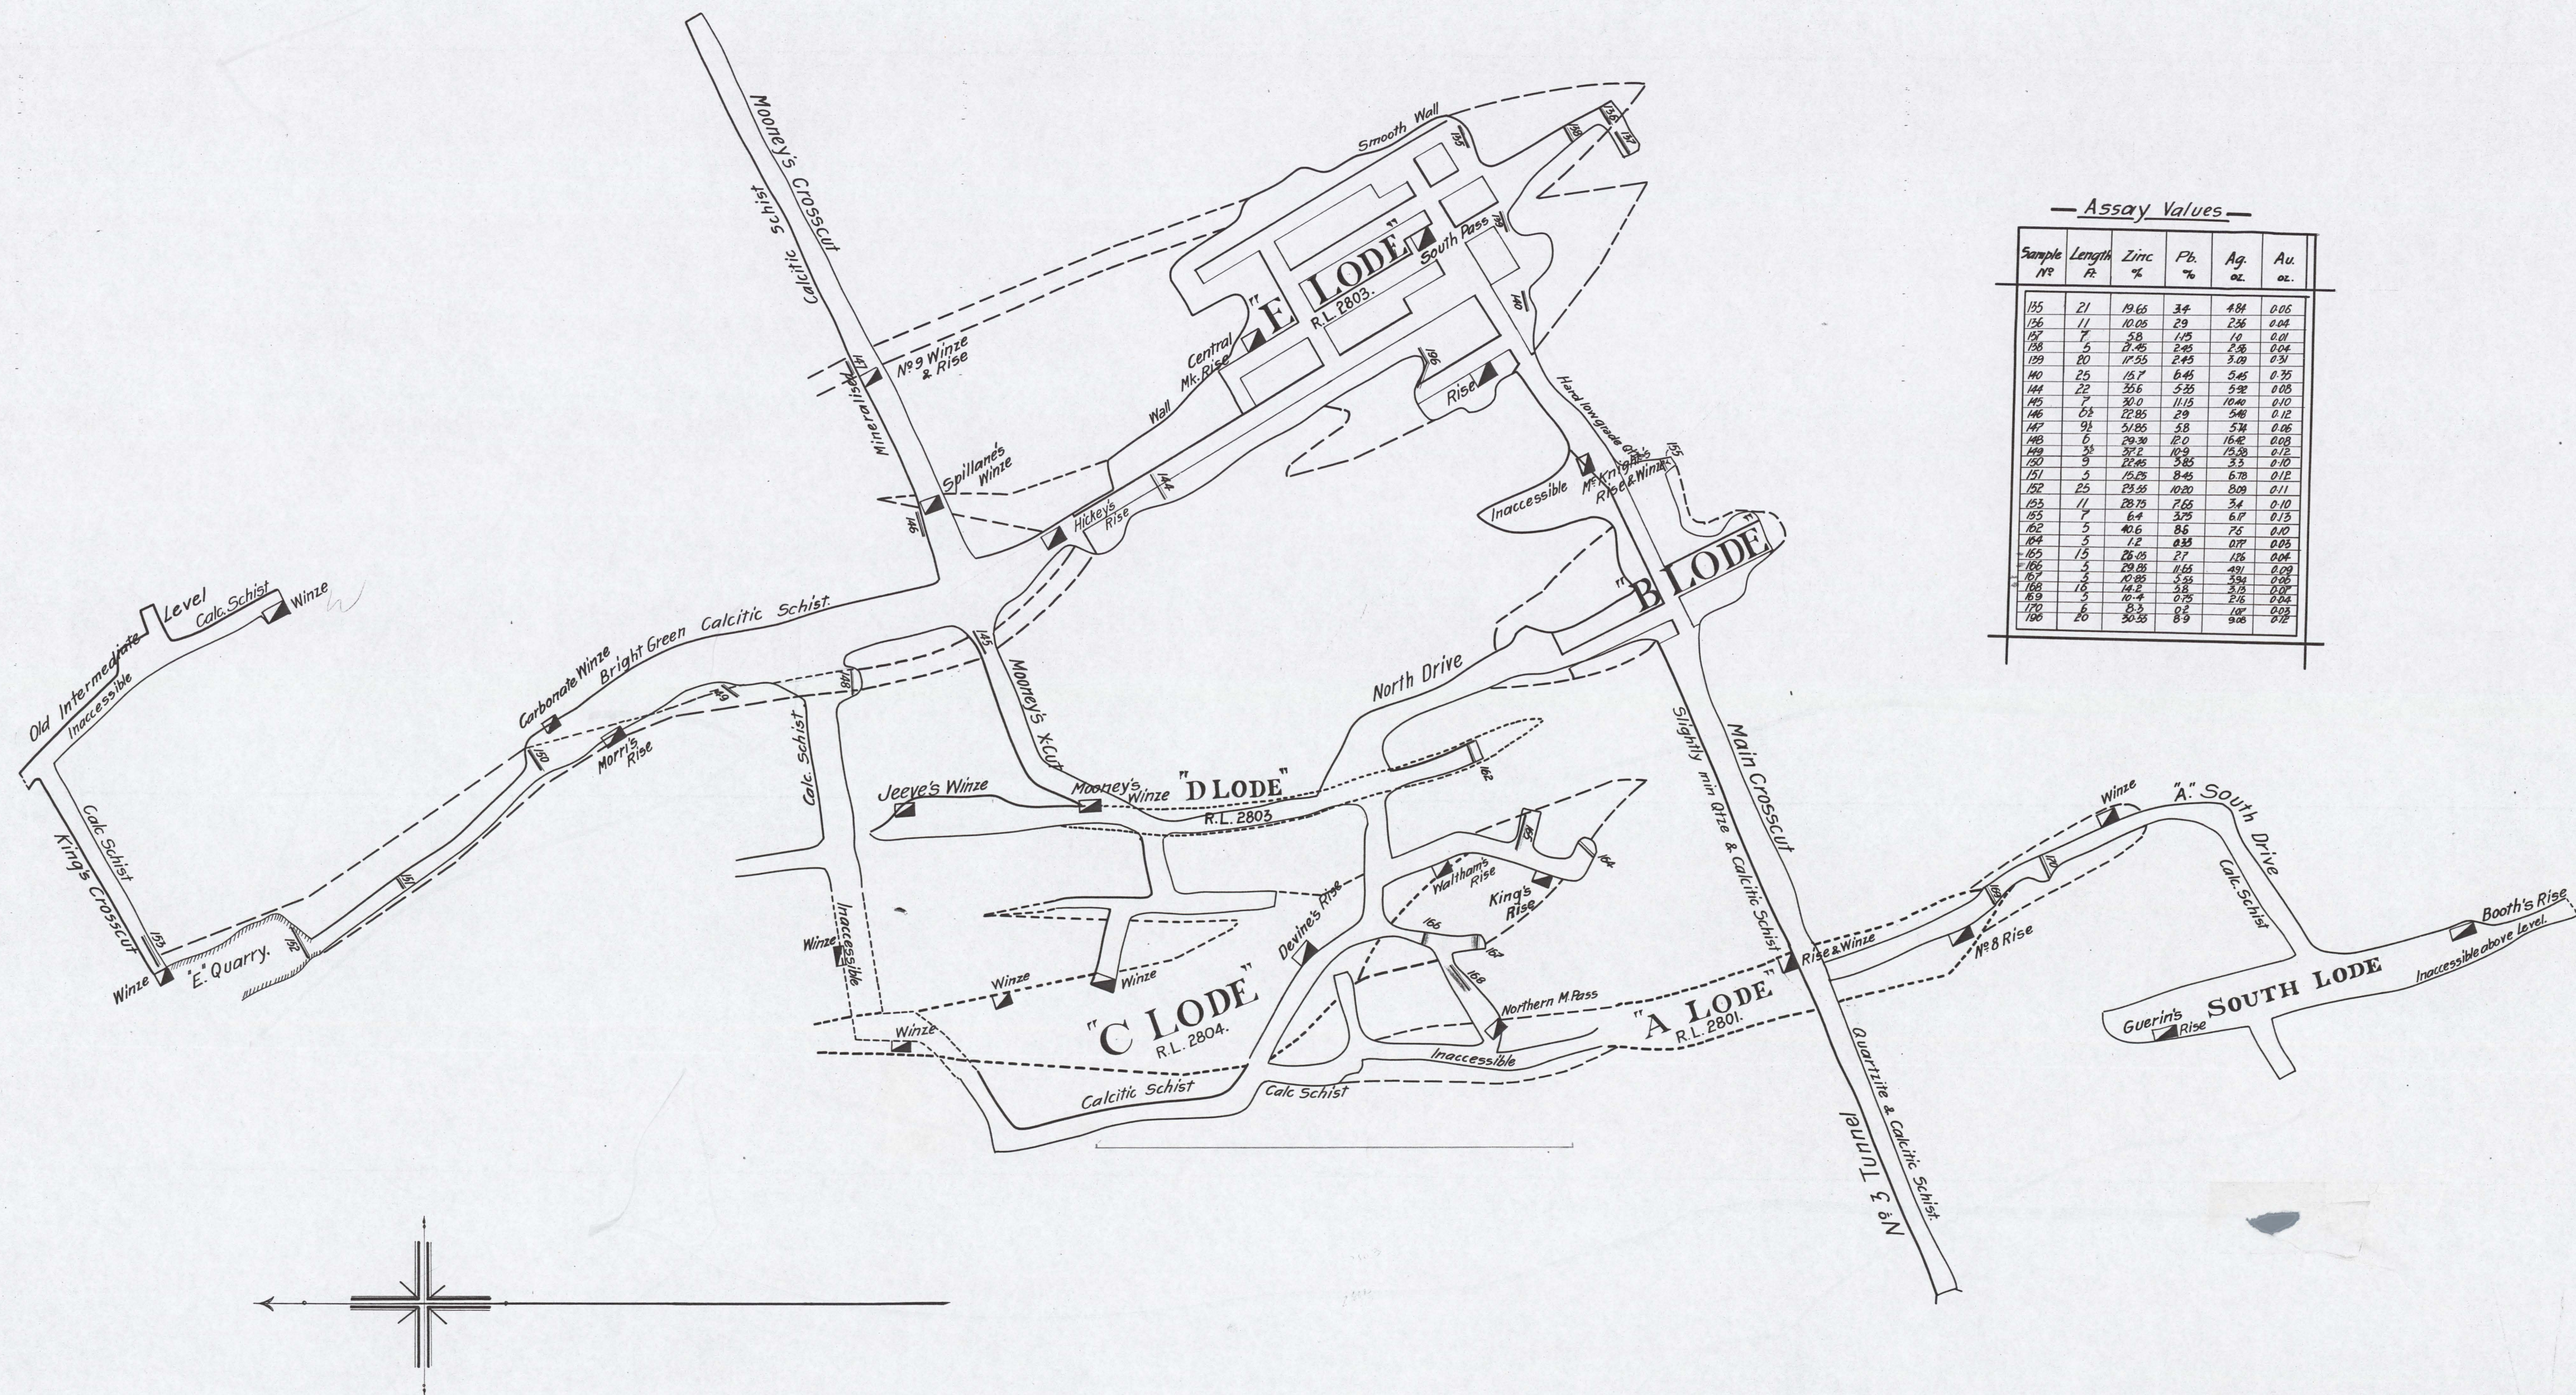

— Assay Values —

Sample No.	Length ft.	Zinc %	Pb. %	Ag. oz.	Au. oz.
135	21	19.65	3.4	4.81	0.05
136	11	10.25	2.9	2.26	0.04
137	7	5.8	1.5	1.9	0.01
138	5	17.45	2.45	5.46	0.04
139	20	17.25	2.45	3.89	0.5
140	25	15.7	6.45	5.45	0.35
141	25	35.6	5.35	5.32	0.05
142	7	30.0	11.15	10.46	0.10
143	51	12.85	2.9	5.46	0.12
144	91	51.95	3.8	5.31	0.06
145	5	25.35	6.0	16.4	0.03
146	55	52.2	10.9	15.25	0.12
147	3	12.45	5.85	2.5	0.10
148	5	12.25	9.45	6.75	0.12
149	25	23.55	10.20	3.09	0.11
150	11	28.75	7.65	3.4	0.10
151	7	6.4	3.75	6.7	0.13
152	5	40.6	8.6	7.5	0.10
153	2	1.2	0.35	0.77	0.05
154	15	25.55	2.7	1.8	0.04
155	5	29.85	11.65	4.9	0.09
156	5	10.85	5.35	5.93	0.06
157	10	16.2	3.3	5.2	0.07
158	5	16.4	0.75	2.6	0.04
159	6	30.4	0.5	1.05	0.03
160	20	30.35	8.9	9.05	0.12

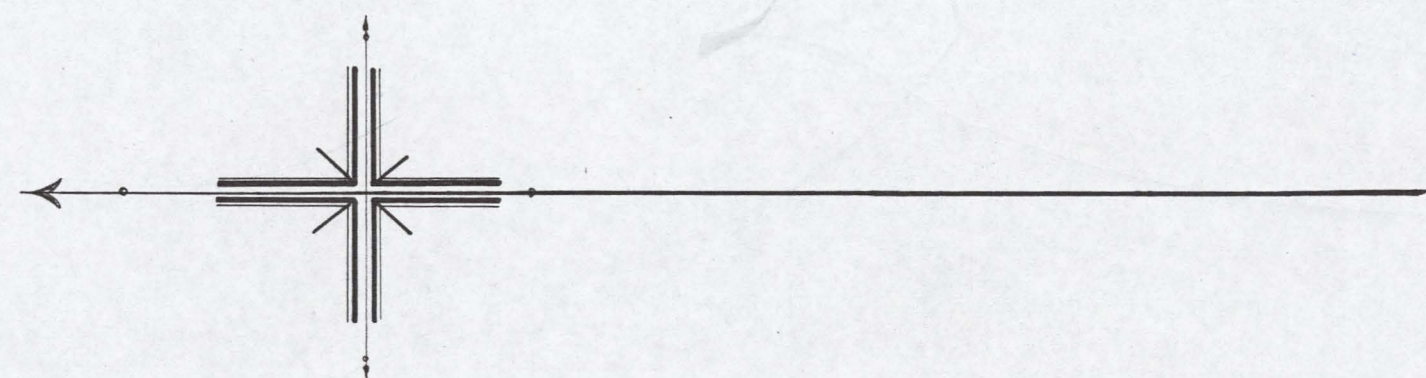

45-72 m

The Mount Lyell M. & R. Company, Ltd.
Mine Department.

DETAIL-PLAN. NO 3 LEVEL HERCULES MINE.

SCALE. 1" = 30'.

5 cm