




No 10 SECTION

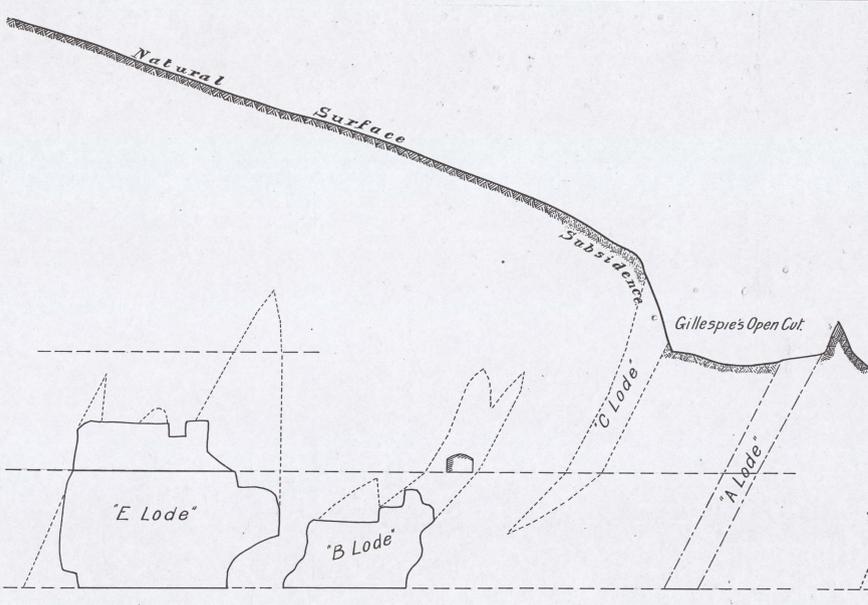


No 11 SECTION

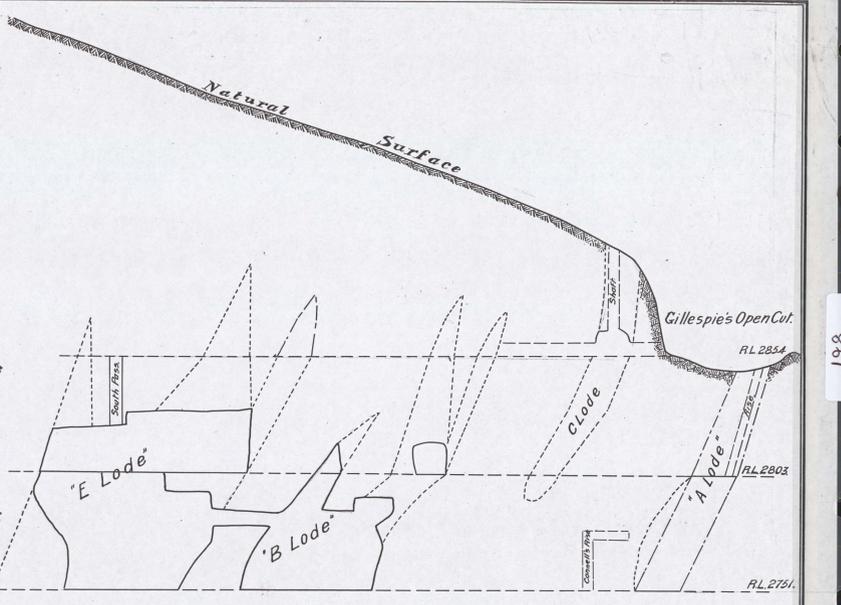


No 12 SECTION

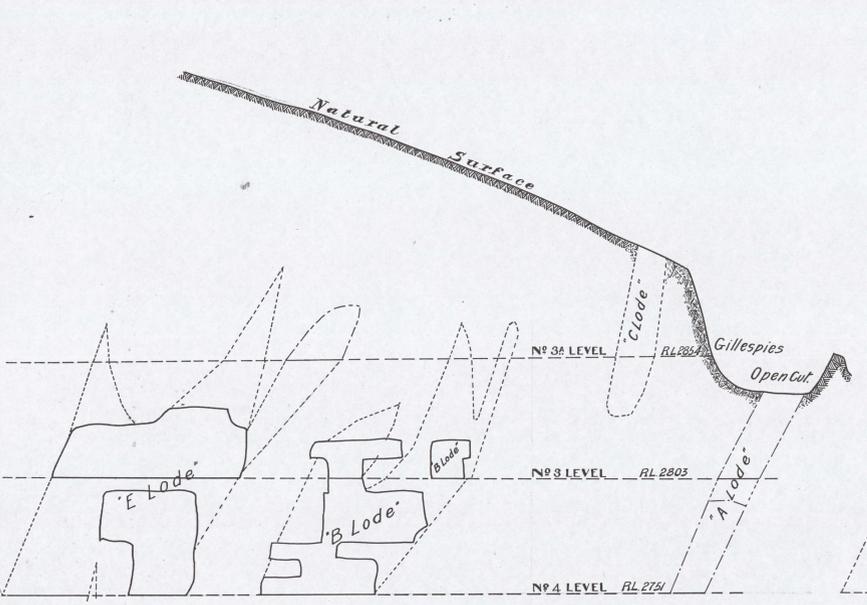

No 13 SECTION

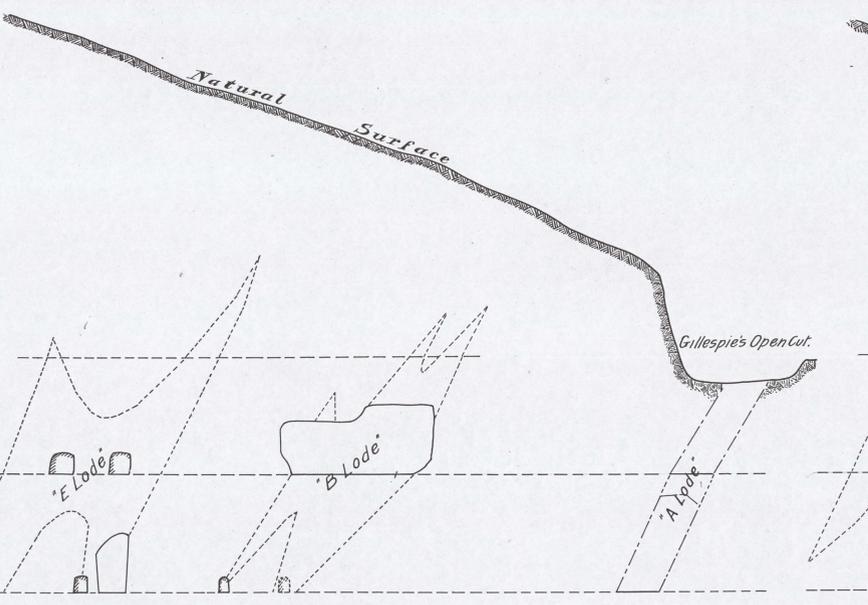


No 14 SECTION

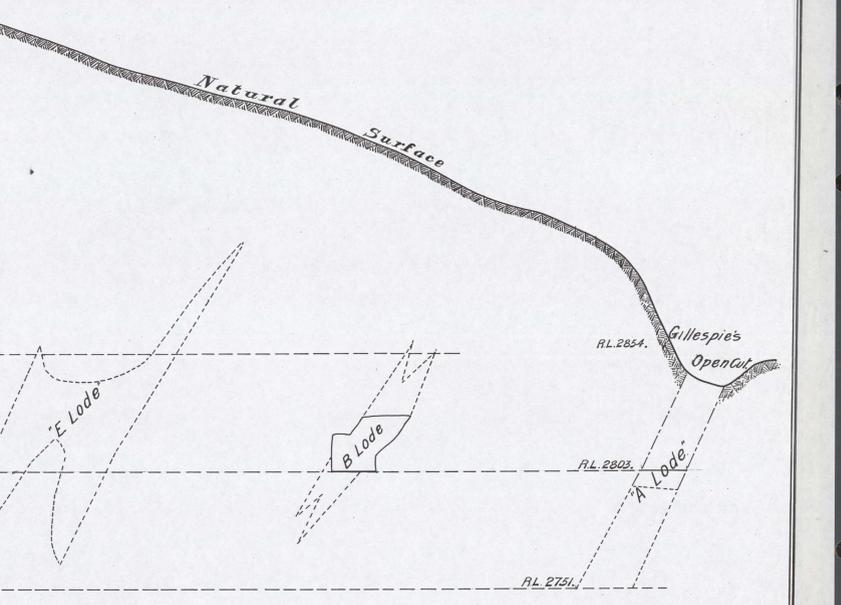

No 15 SECTION

The Mount Lyell M. & R. Company. Ltd.
 Mine Department.
 SECTIONS THROUGH OREBODIES - HERCULES MINE.
 SCALE 1" = 30'.

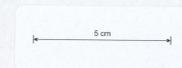

ELECTROLYTIC ZINC CO. OF ASIA LTD.	
MINES DEPT. ROSEBERRY, T.A.E.	
SCALE	
DATE	HG-115

198
 5500

Upper
 X-section