



Bore Holes  
H35 + H36

0055-866

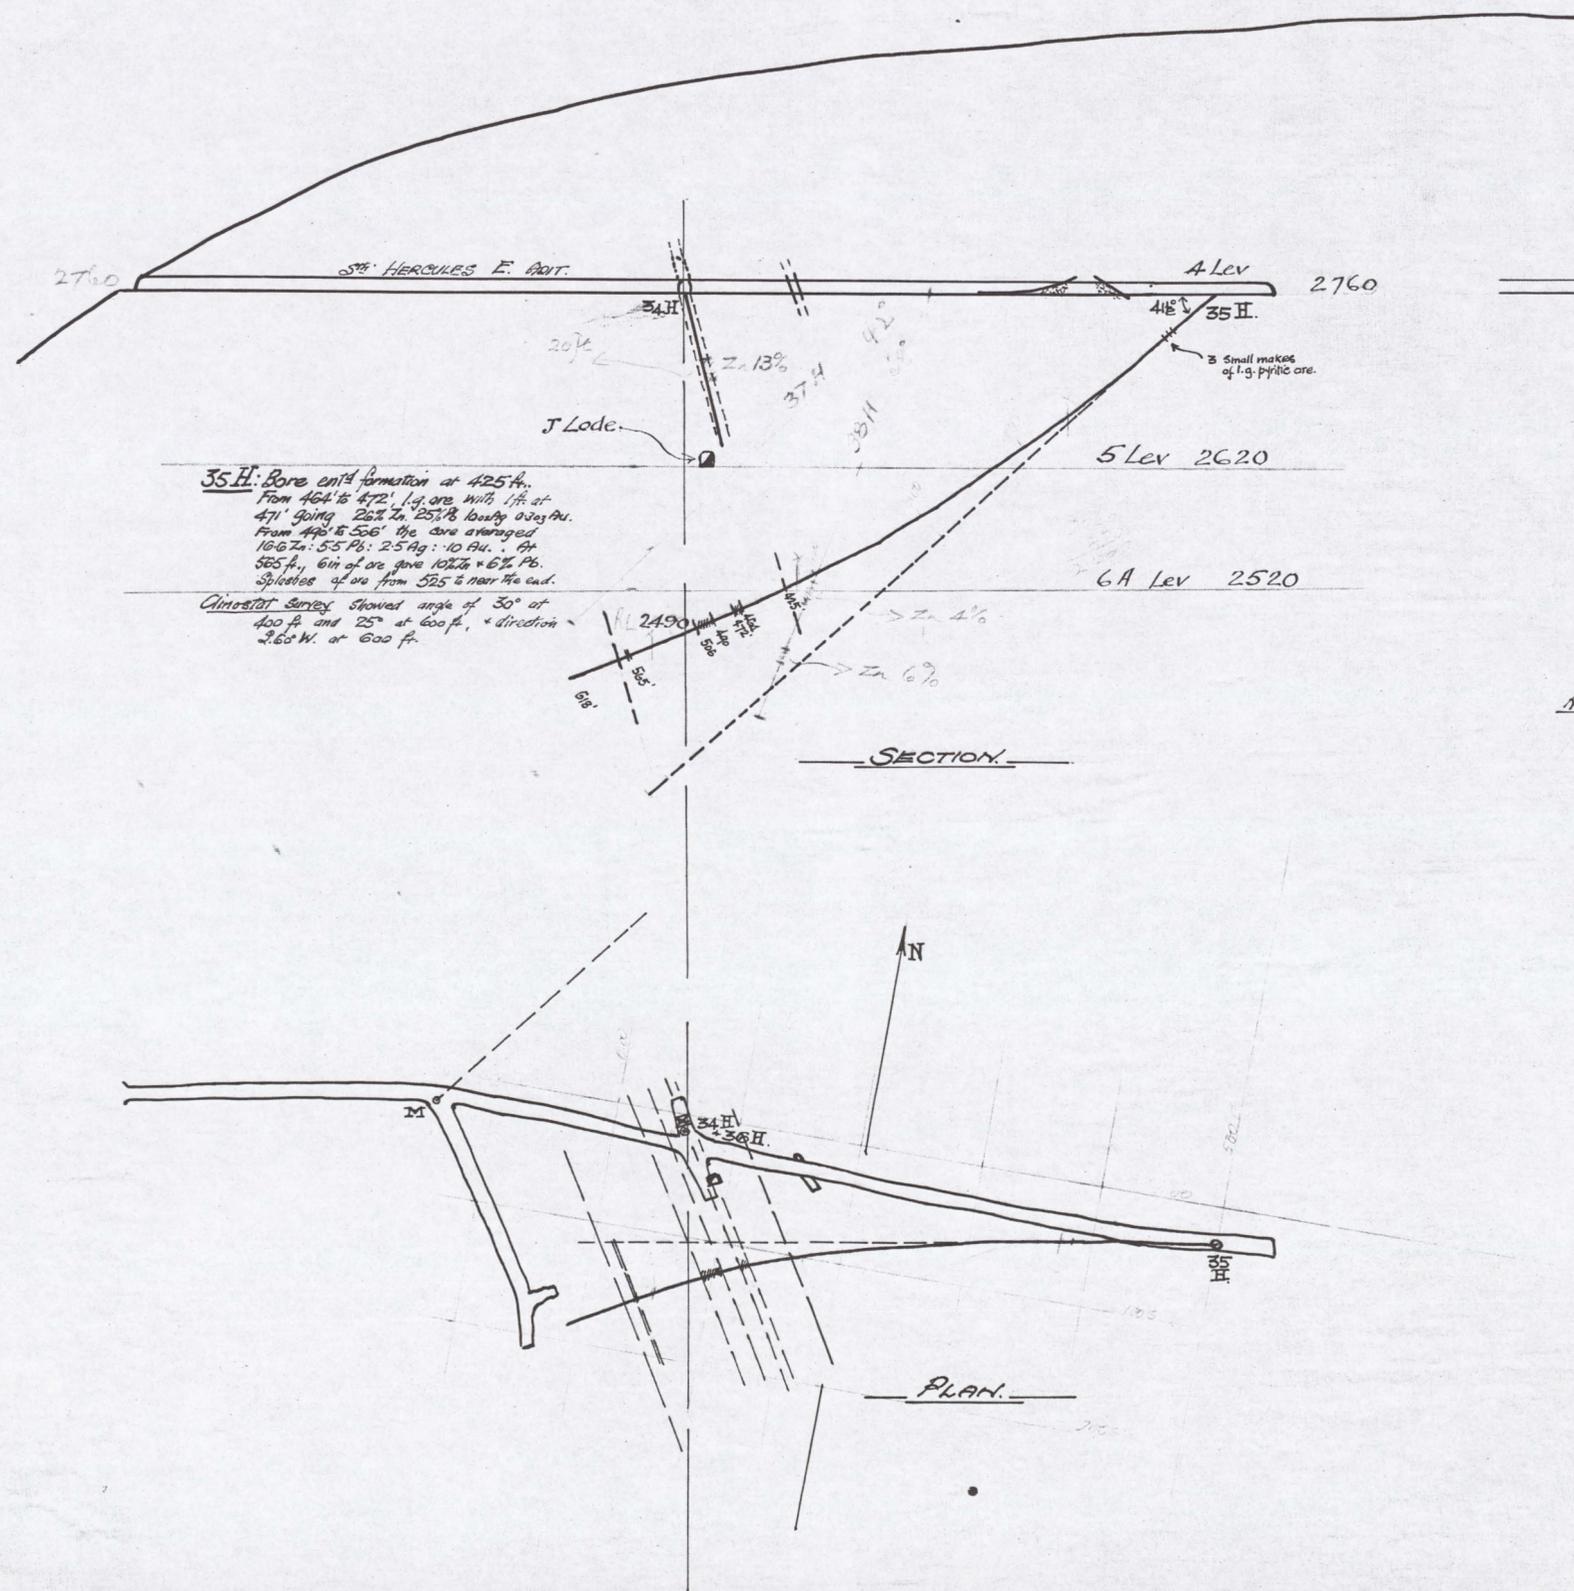

**35H:** Bore cut formation at 425 ft.  
From 464 to 472' 1 g. ore with 1 ft. at  
From 490 to 506' the ore averaged  
10.6 Zn, 5.5 Pb, 2.5 Ag, 10 Au. At  
505 ft., 6 in. of ore gave 10.2 Zn + 6% Pb.  
Spikes of ore from 525 to near the end.  
Clinostat survey showed angle of 30° at  
400 ft. and 25° at 600 ft., + direction  
2.60 W. at 600 ft.

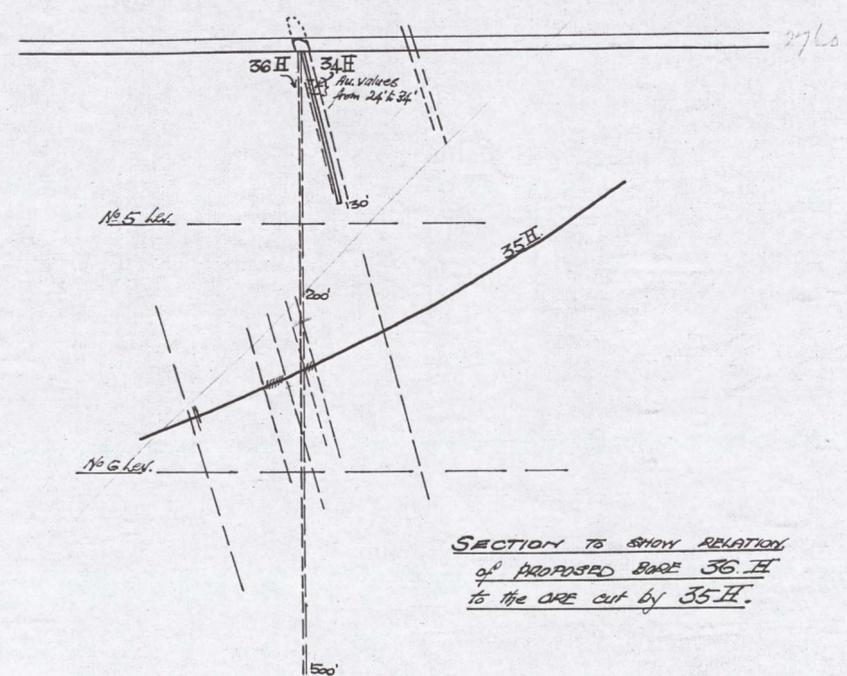

SECTION TO SHOW RELATION  
OF PROPOSED BORE 36H  
TO THE ORE CUT BY 35H.

**E.Z.C.**  
PLAN SHOWING RESULTS OF 35H  
AND POSSIBILITIES OF BORE 36H.  
SCALE: 100 ft. to inch.

A.W.  
1/17/26



X2D-7