


E. Z. C.
PLAN & SECTION TO SHOW
POSITIONS of 37H. & 38H.
Scale 100ft. to inch.

H. H. H.

X2-D8.

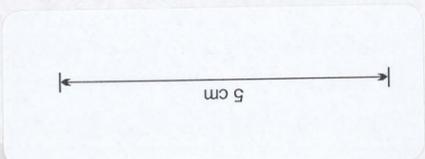

869
 0055-

Bore Holes
 H34 & H35