

100' Level

1000' Level

ROYAL THARSIS MINE
1100' Level

1300' Level


700' Level

850' Level

1100' Level

925' Level

1200' Level

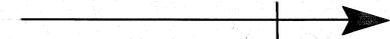

The Mount Lyell Mining & Railway Co., Ltd.

Mine Department.
NORTH LYELL MINE
UNDERGROUND WORKINGS 1929
SCALE 1 INCH = 30 FEET

[Signature] General Manager
[Signature] Mine Superintendent

5 feet

