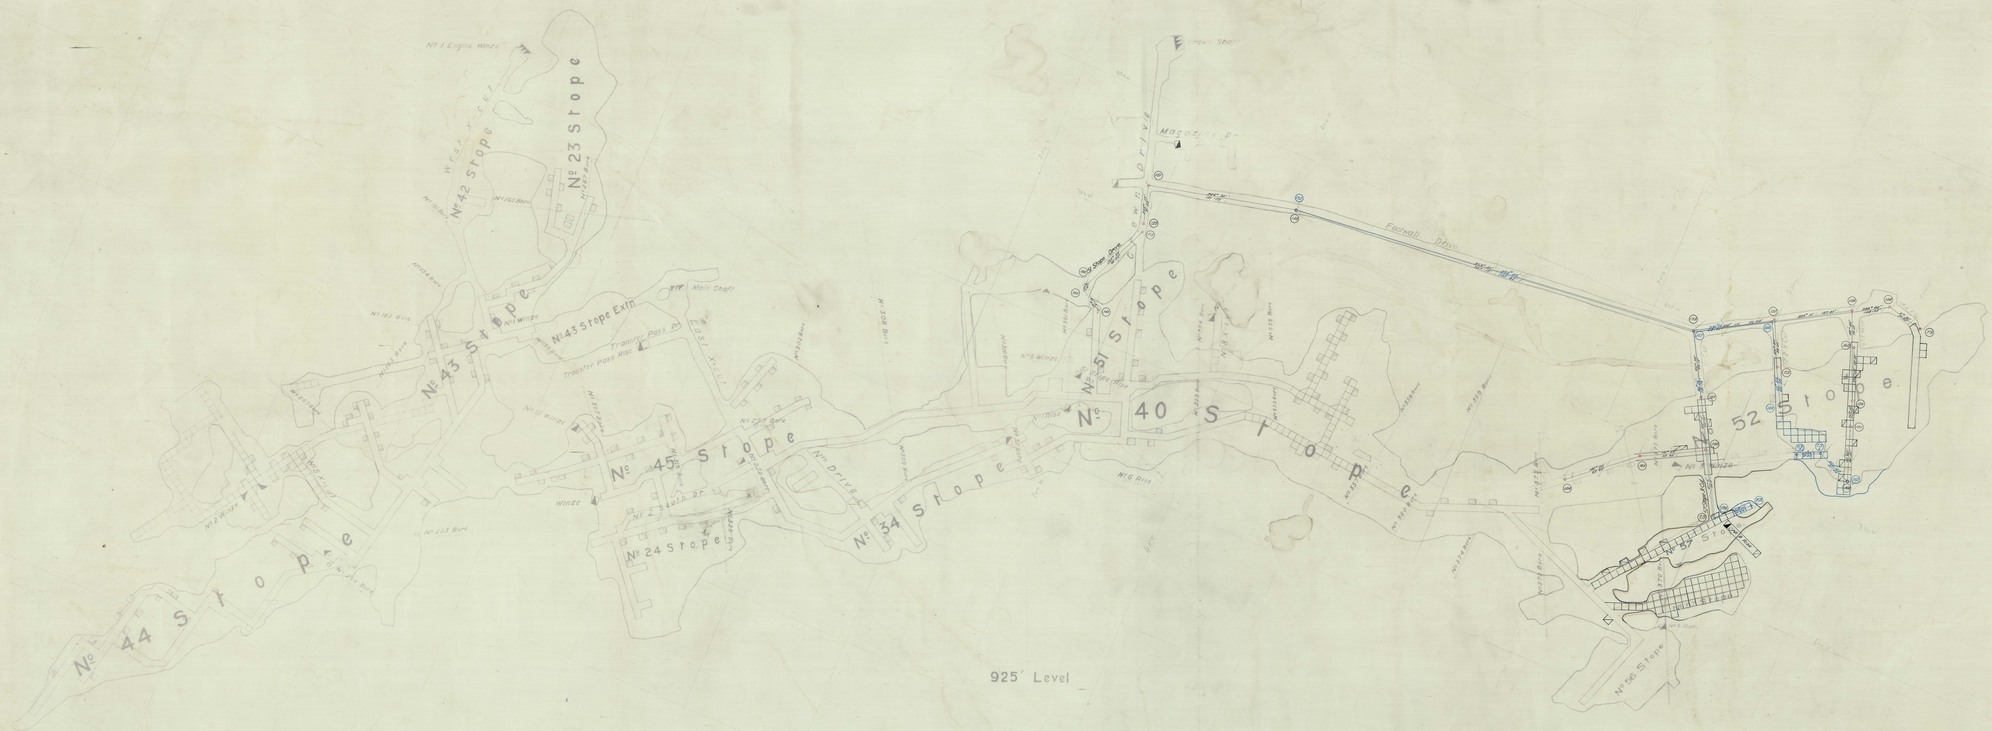

5 cm

56/15

The Mount Lyell Mining & Railway Co., Ltd.

Mine Department.

DETAIL PLAN - UNDERGROUND WORKINGS

NORTH LYELL MINE.

SCALE 1 INCH = 30 FEET

1935 WORK SHEWN BLUE.

31 - 12 - 35

31 - 12 - 36

General Manager.

Mine Superintendent.