


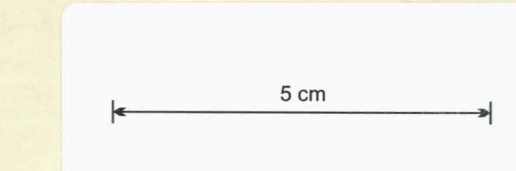

The Mount Lyell Mining & Railway Co., Ltd.
Mine Department.
DETAIL PLAN - UNDERGROUND WORKINGS.
NORTH LYELL MINE.
SCALE 1 INCH = 30 FEET.
1935 WORK SHEWN BLUE.
1936 WORK SHEWN GREEN.



[Signature] General Manager
[Signature] Mine Superintendent

56/16

