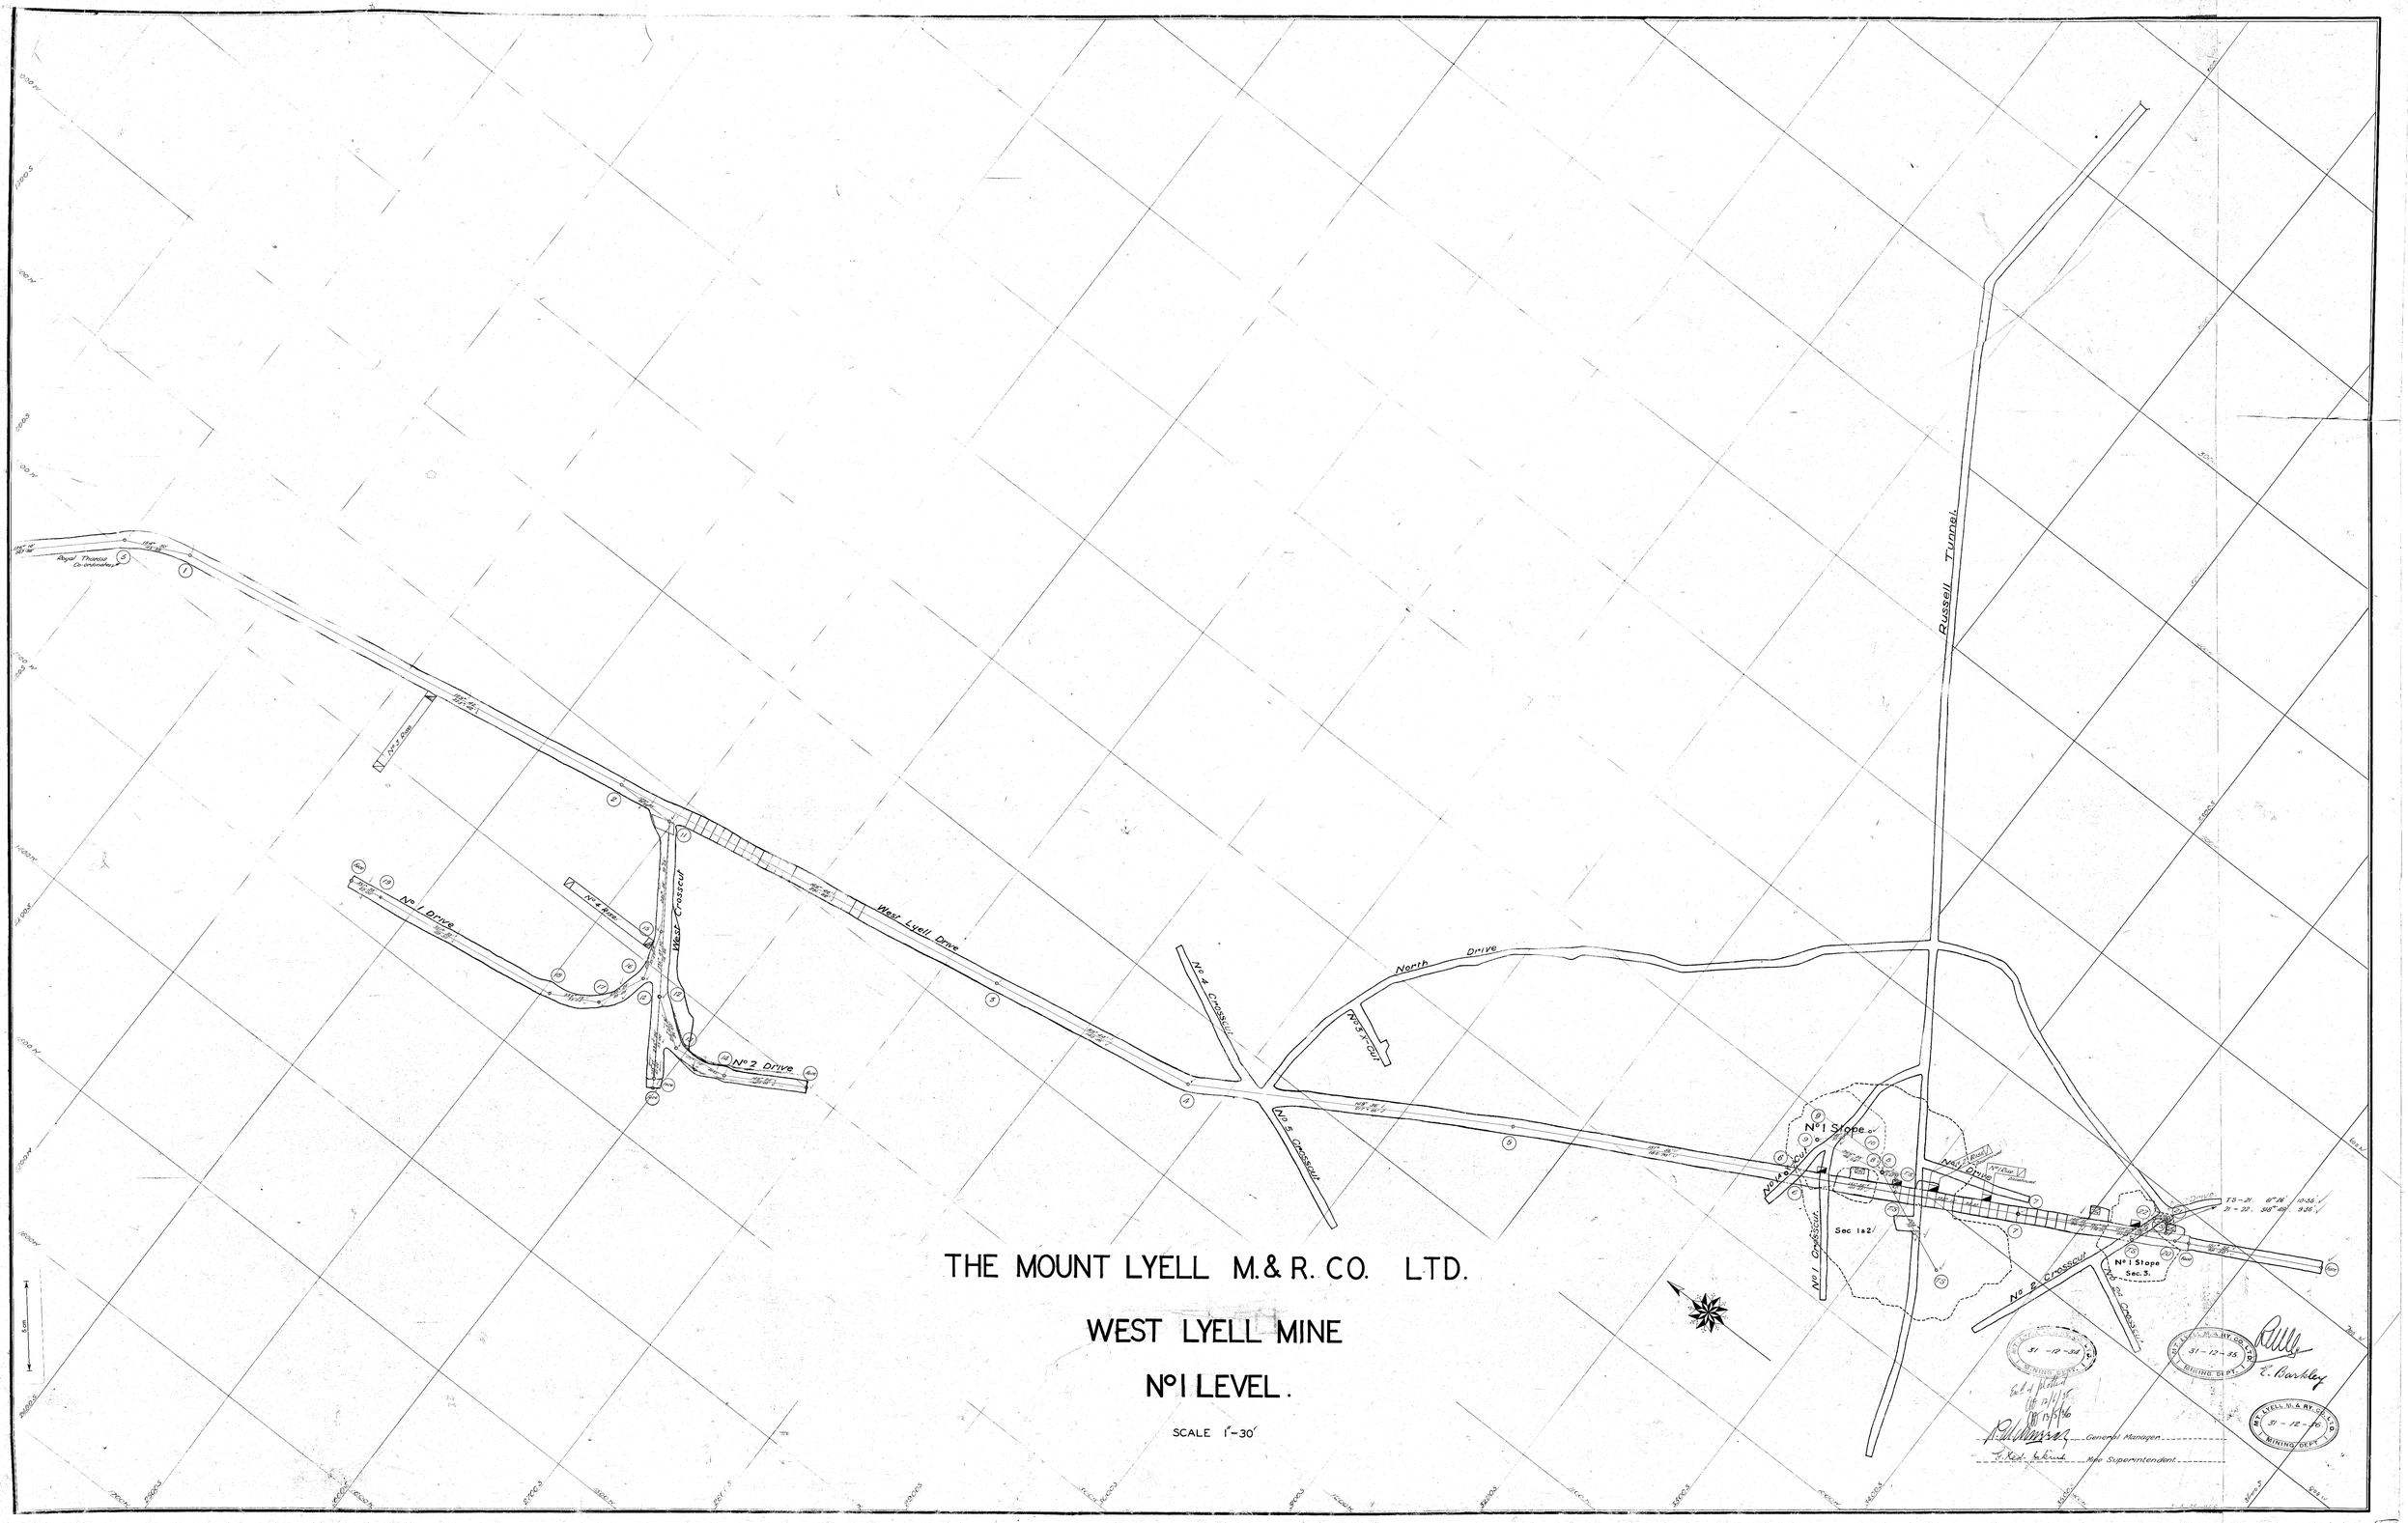
Royal Thanes Co-ordinates
Nº 1 Drive
Nº 2 Drive
Nº 3 Drive
West Crosscut
West Lyell Drive
Nº 4 Crosscut
Nº 5 Crosscut
North Drive
Nº 1 Stope
Nº 1 Crosscut
Nº 2 Crosscut
Nº 3 Crosscut
Sec 1 & 2
Nº 1 Stope
Sec. 3.
Russell Tunnel
THE MOUNT LYELL M. & R. CO. LTD.
WEST LYELL MINE
Nº 1 LEVEL.
SCALE 1"=30'
31-12-35
MINING DEPT.
General Manager
Mine Superintendent