




**THE MOUNT LYELL M. & R. CO. LTD.**

**LYELL COMSTOCK MINE.**

**No 2 LEVEL.**

SCALE = 1 INCH = 30 FEET

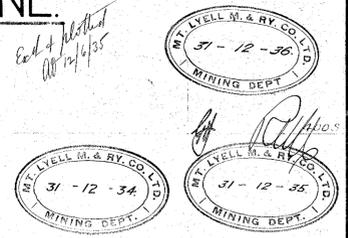

*R. W. ...* General Manager  
*S. Red ...* Mine Superintendent

56-30



700W 600W 500W 400W 300W 200W 100W 00W

200N  
100N  
00  
100S  
200S  
300S  
400S

200N  
100N  
00  
100S  
200S  
300S  
400S  
700W  
600W  
500W  
400W  
300W  
200W  
100W  
00W