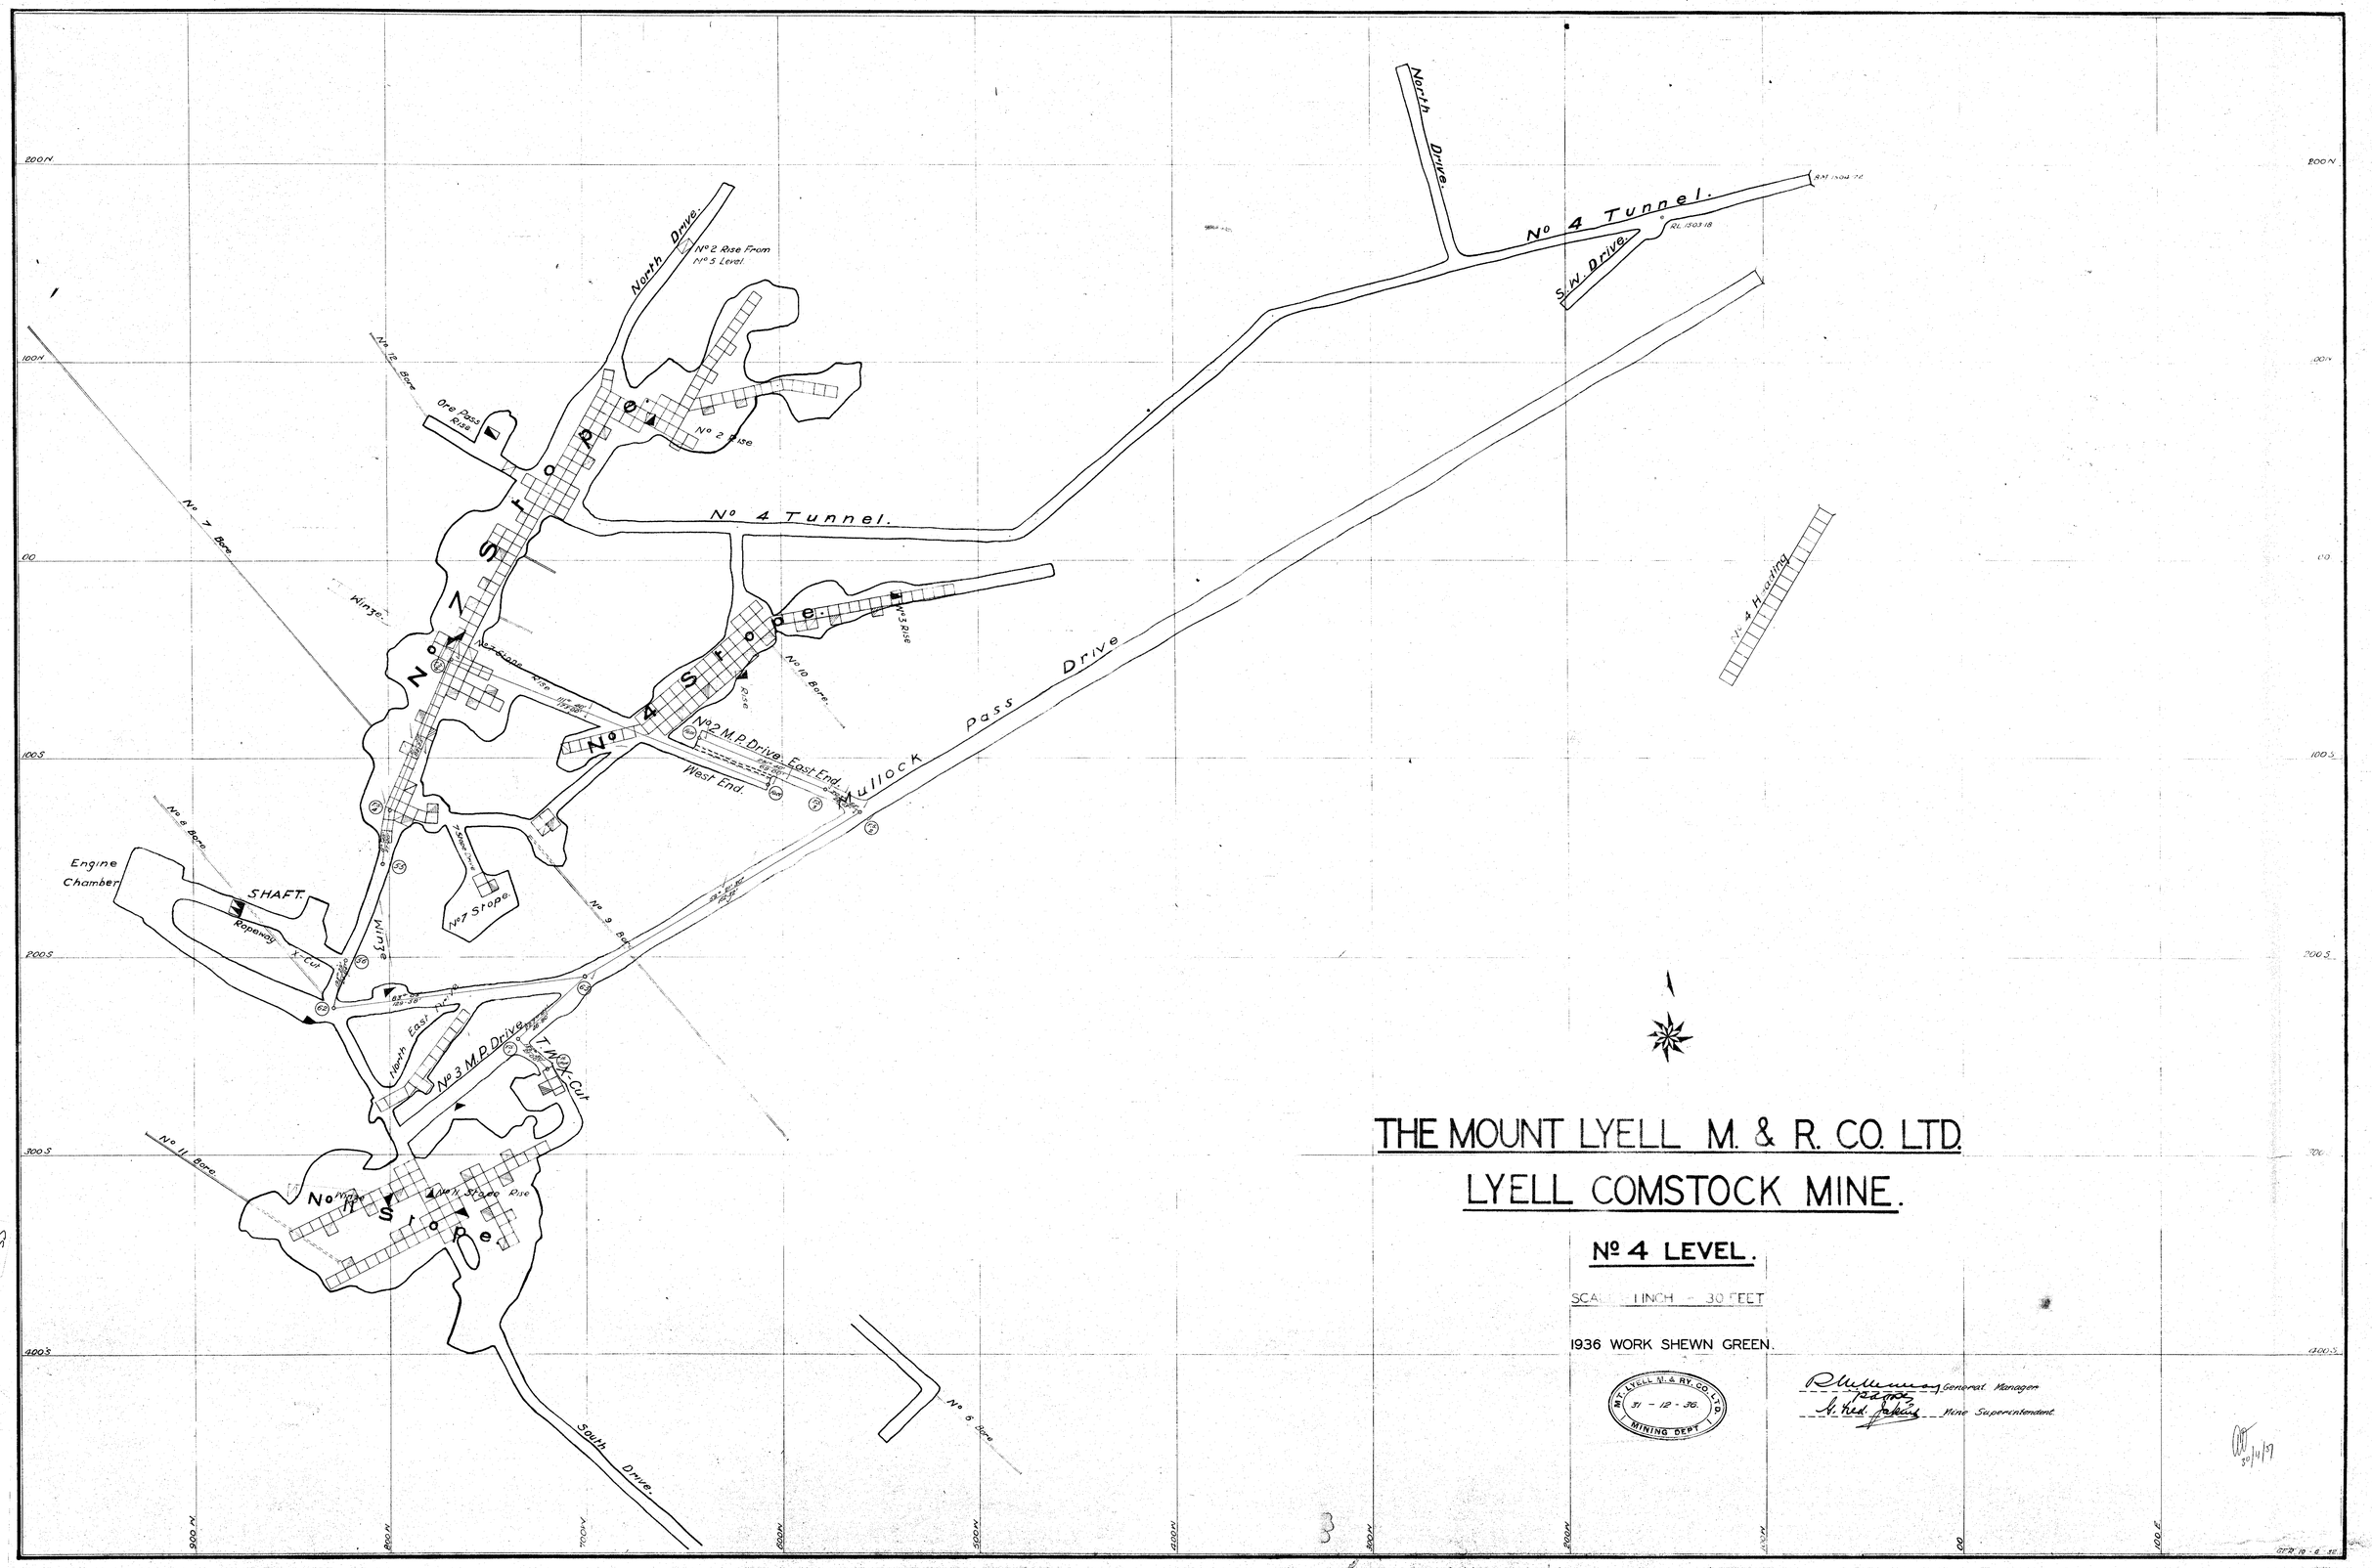
THE MOUNT LYELL M. & R. CO. LTD.
LYELL COMSTOCK MINE.
No 4 LEVEL.
SCALE 1 INCH = 30 FEET
1936 WORK SHEWN GREEN.
MT. LYELL M. & RY. CO. LTD.
31 - 12 - 36.
MINING DEPT.
General Manager
Mine Superintendent
No 4 Tunnel.
North Drive.
S.W. Drive.
No 2 Rise From No 5 Level
No 2 Rise
No 4 Stope
No 3 Rise
No 10 Bore
No 2 M.P. Drive East End
West End.
Mullock pass Drive
No 4 Hoating
No 7 Bore
No 12 Bore
Ore Pass Rise
Wings
No 8 Bore
Engine Chamber
SHAFT.
Ropeway
X-Cut
No 7 Stope
No 9 Bore
No 3 M.P. Drive
T.W. X-Cut
No 11 Bore
No 1 Stope
No 6 Bore
South Drive.
200 N
100 N
00
100 S
200 S
300 S
400 S
900 W
800 W
700 W
600 W
500 W
400 W
300 W
200 W
100 W
00
100 E