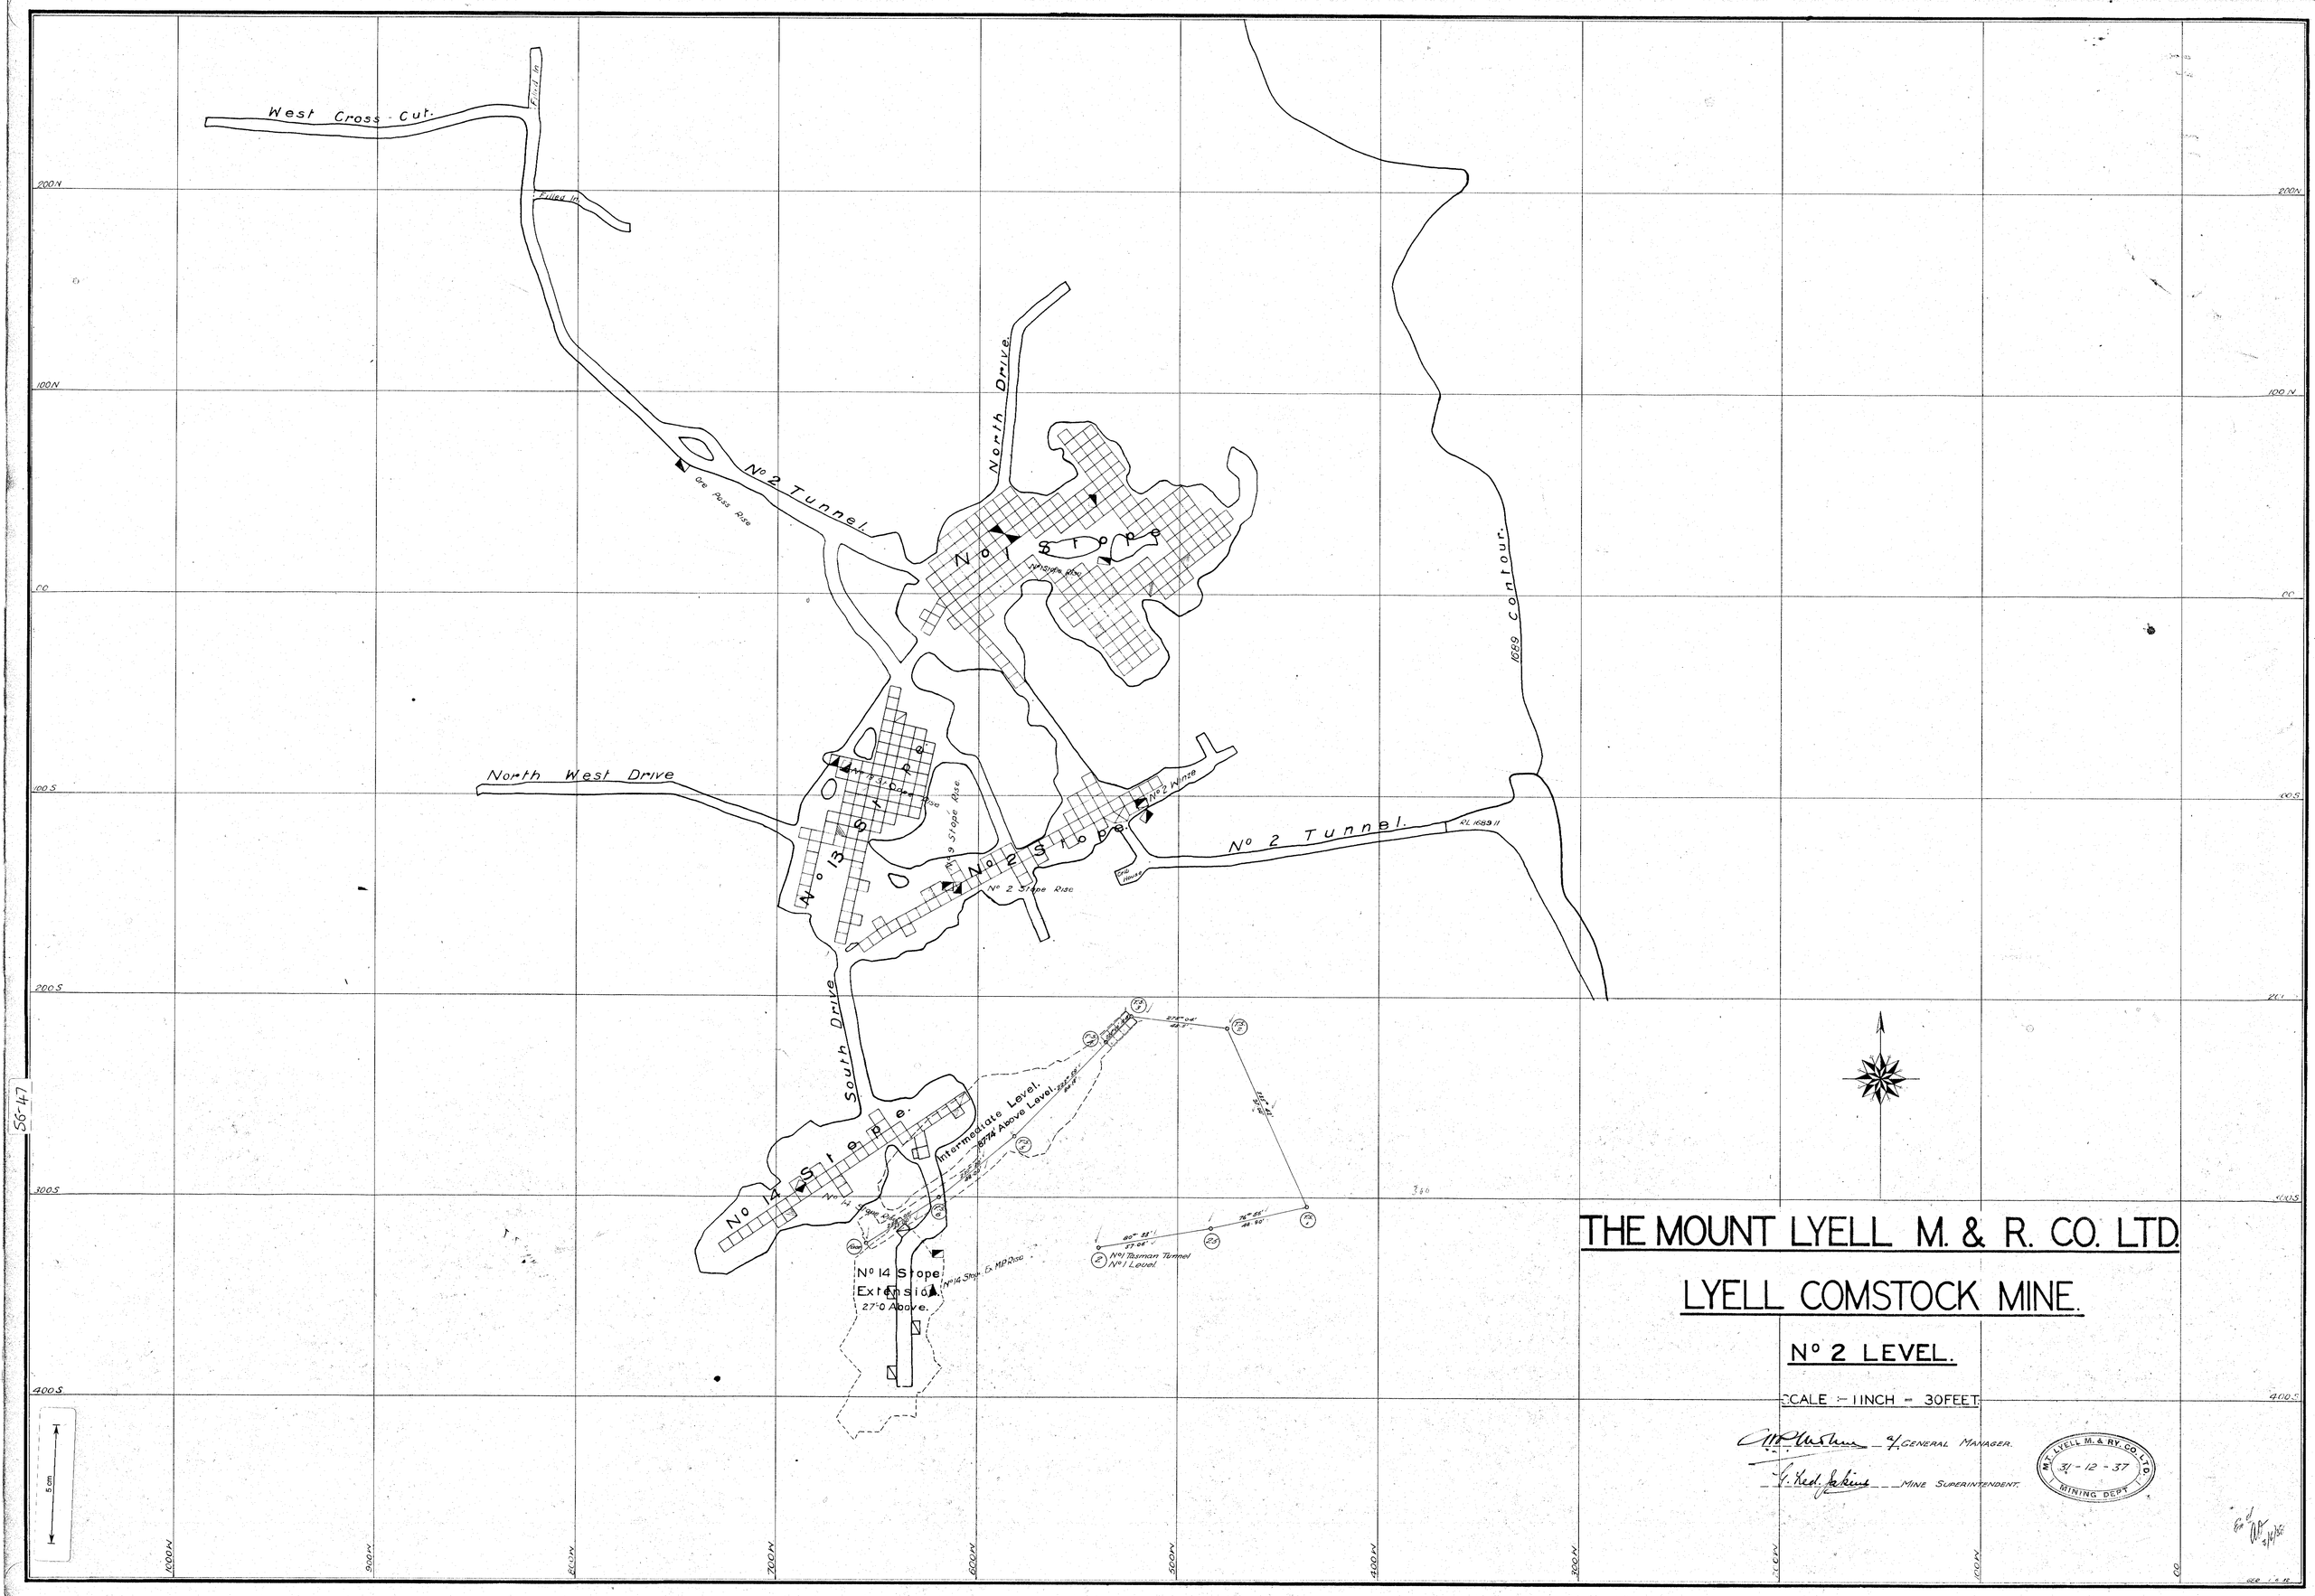

THE MOUNT LYELL M. & R. CO. LTD.

LYELL COMSTOCK MINE.

No 2 LEVEL.

SCALE :- 1 INCH = 30 FEET.

C. H. P. Mathers — G. GENERAL MANAGER.

F. Ked. Jenkins — MINE SUPERINTENDENT.

MT. LYELL M. & RY. CO. LTD. 31-12-37 MINING DEPT.

47-95