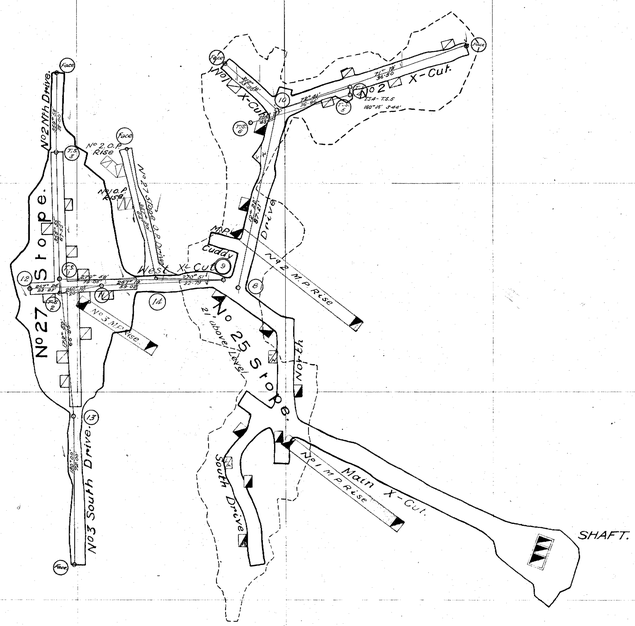

THE MOUNT LYELL M. & R. CO. LTD.

LYELL COMSTOCK MINE.

No 9 LEVEL.

SCALE :- 1 INCH = 30 FEET.

D. H. Murray per W.T. General Manager

C. Rd. Jenkins Mine Superintendent

MT. LYELL M. & RY. CO. LTD. 31 DEC 1939 MINING DEPT.

R. H. Murray General Manager

E. B. Wakeley Mine Superintendent

MT. LYELL M. & RY. CO. LTD. 31 DEC 1939 MINING DEPT.

Established Oct 1/1930 Oct 3/1944

S6-S1