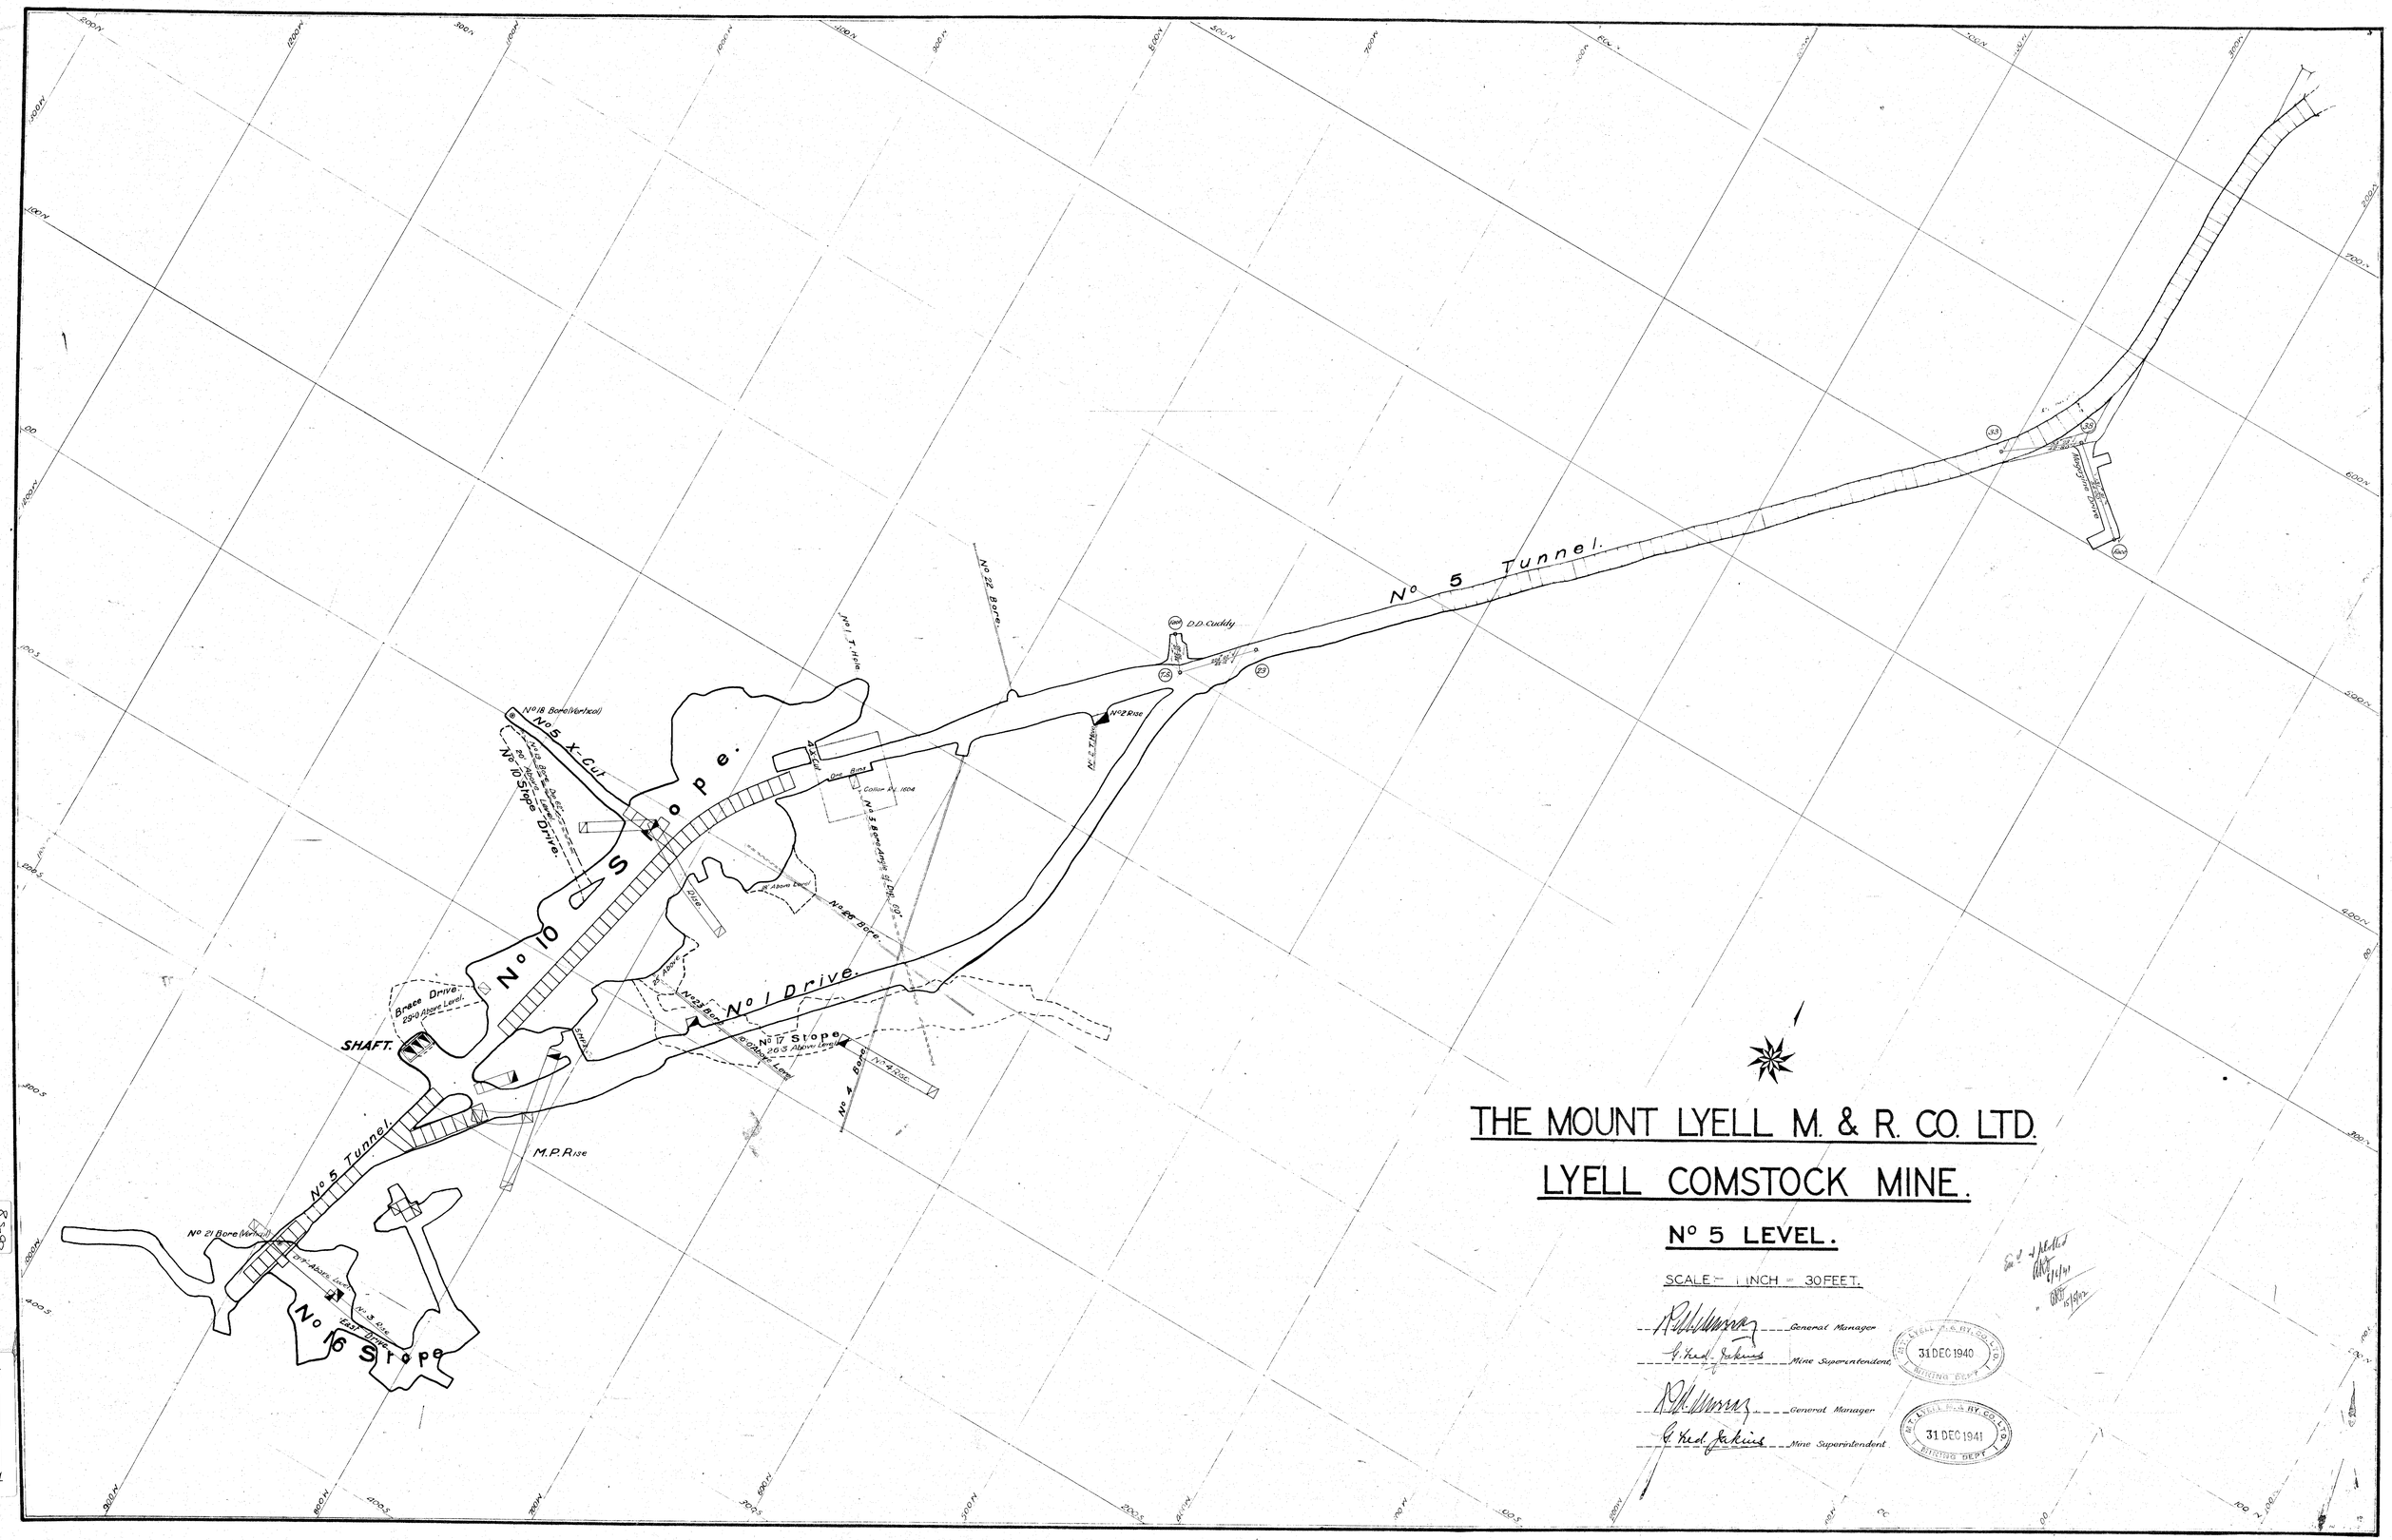
No 5 Tunnel.
D.D. Cuddy
No 22 Bore.
No 1 T-Hole
No 2 Rise
No 18 Bore (vertical)
No 5 X-Cut
No 10 Stope Drive.
No 10 Stope
Brace Drive.
290 Above Level.
SHAFT.
No 5 Tunnel.
No 21 Bore (vertical)
No 3 Rise
No 16 Stope
M.P. Rise
No 1 Drive.
No 17 Stope
No 4 Bore
No 4 Rise
No 23 Bore
No 26 Bore
Collar El. 1604
Main Drive
THE MOUNT LYELL M. & R. CO. LTD.
LYELL COMSTOCK MINE.
No 5 LEVEL.
SCALE - 1 INCH = 30 FEET.
General Manager
Mine Superintendent.
General Manager
Mine Superintendent
31 DEC 1940
31 DEC 1941
MINING DEPT.