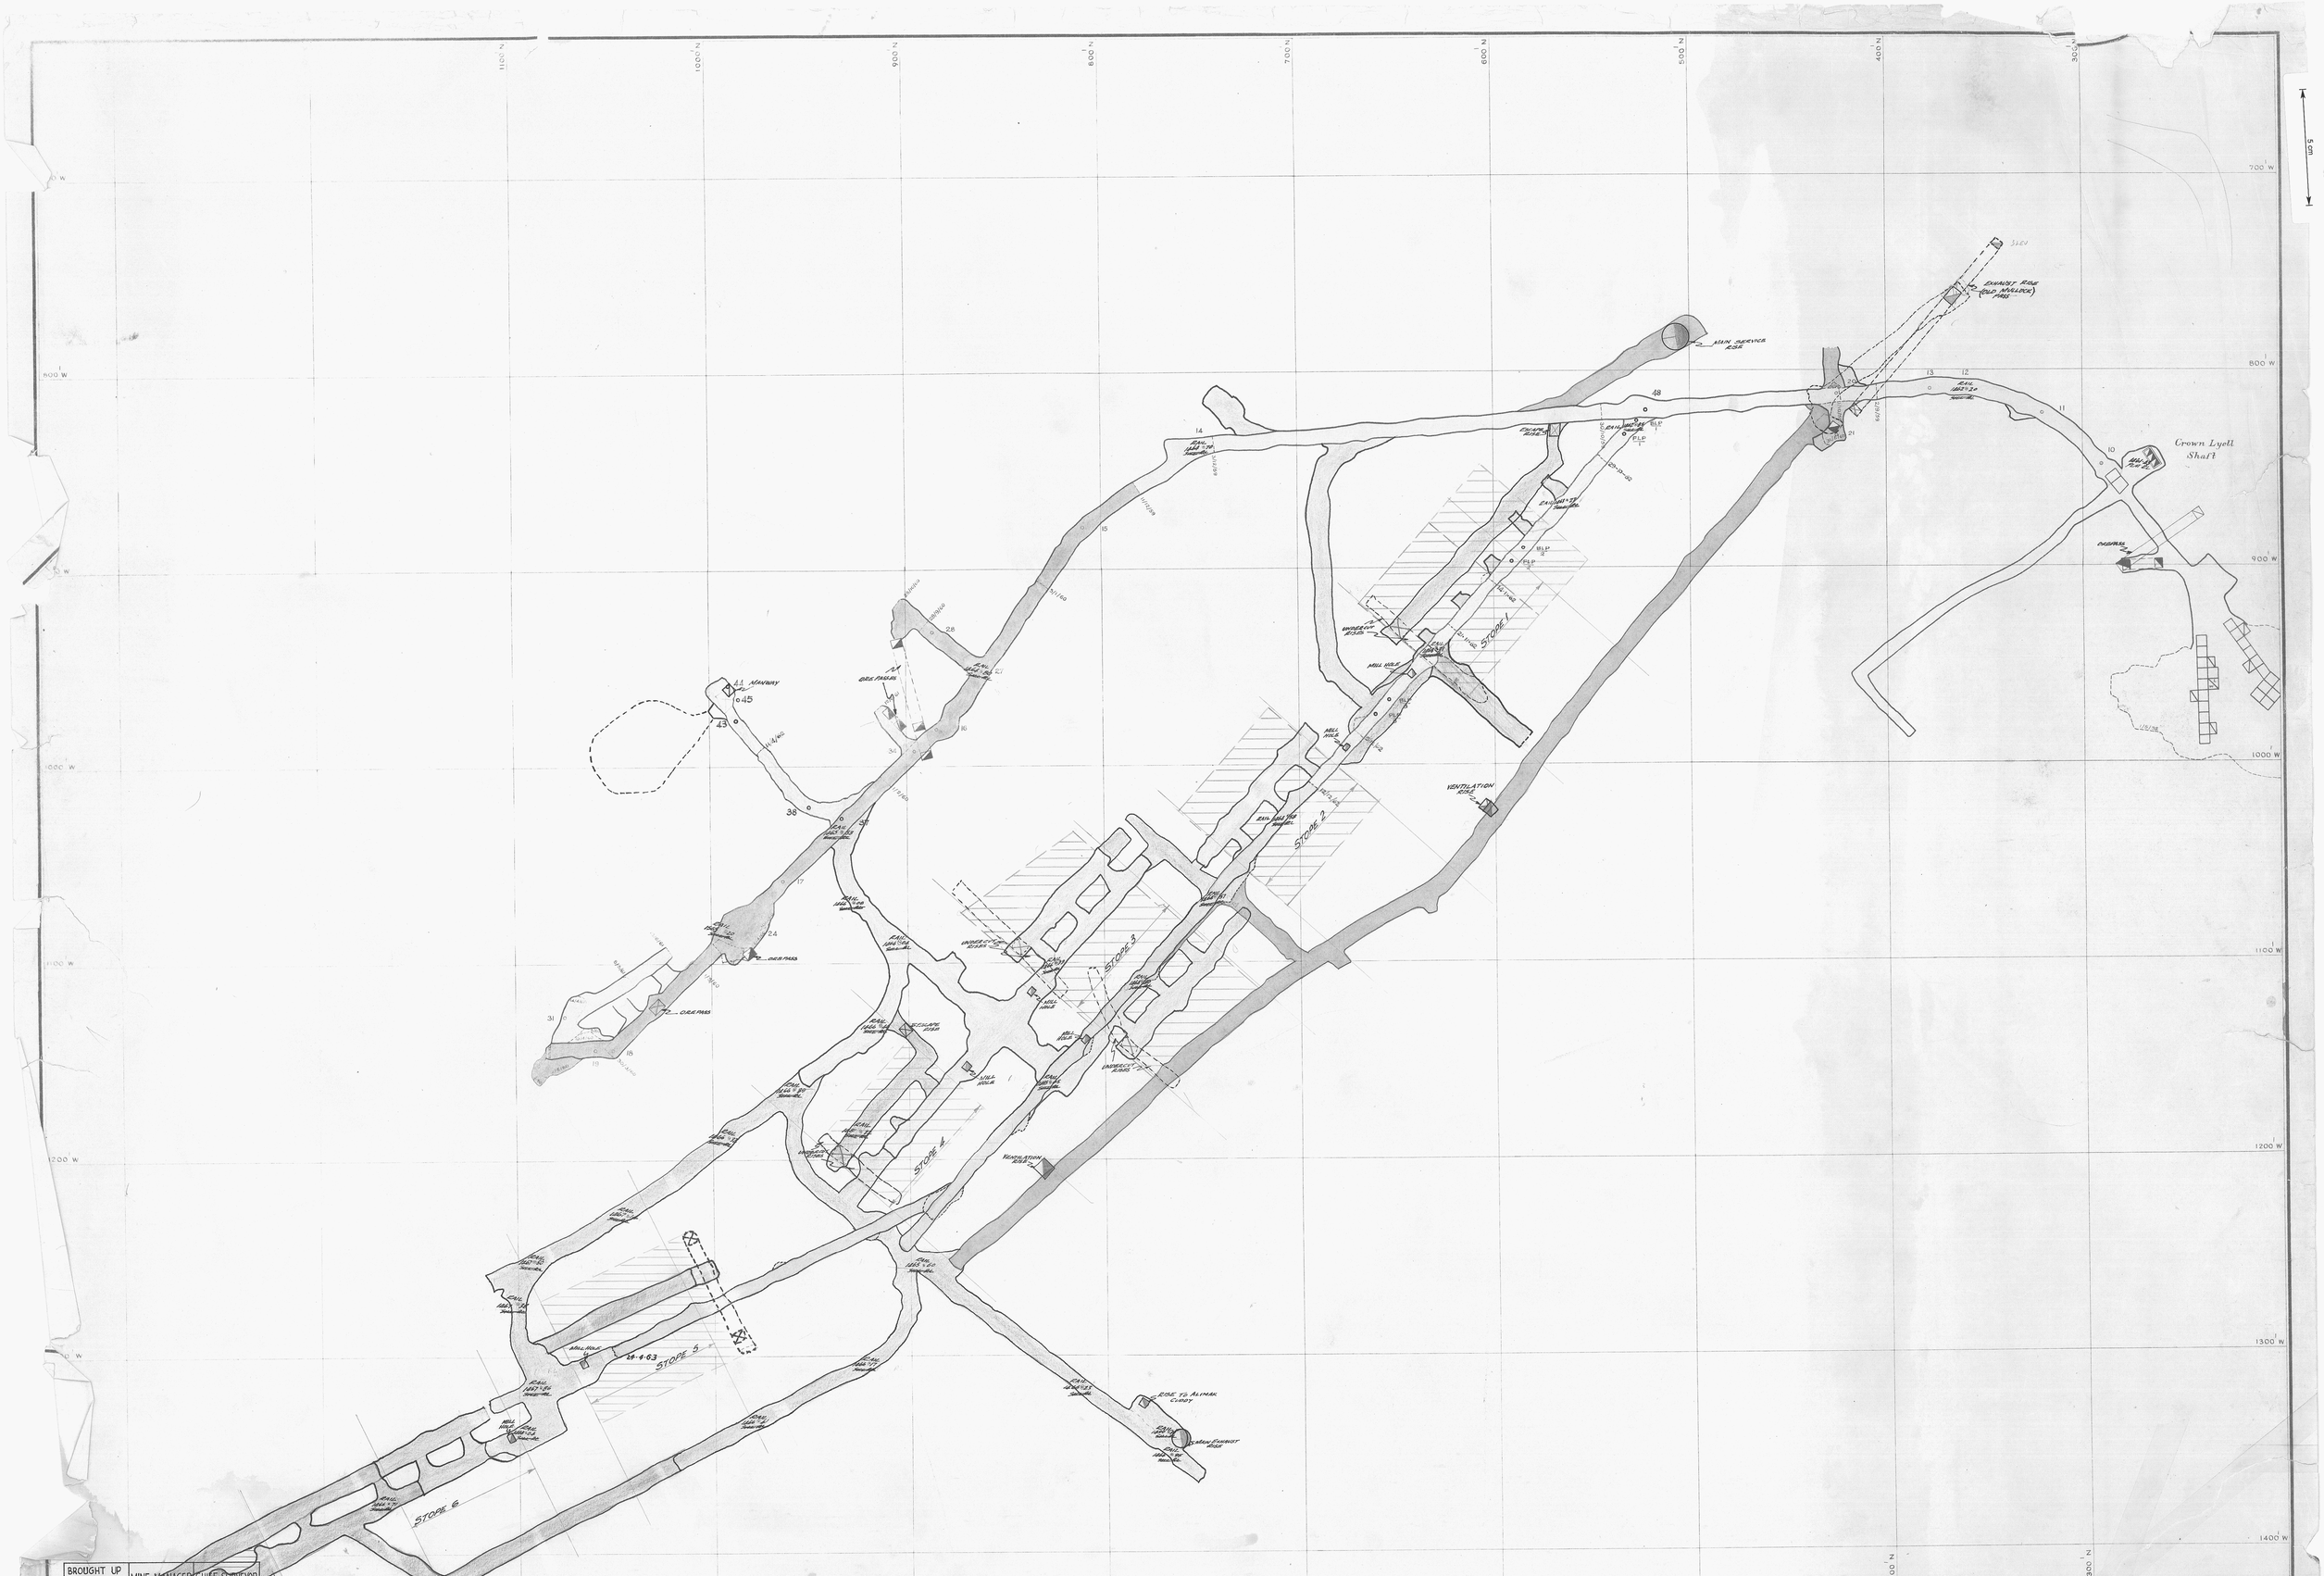

BROUGHT UP TO DATE	MINE MANAGER	CHIEF SURVEYOR				
31/12/6			31-12-72			
31-12-63						
13-12-63						
31-12-64						
31-12-65						
31/12/66						

MOUNT LYELL M.&R. COY. LTD.			Drawn by		APPROVED
MINE DEPARTMENT			Traced by		Mine Supt.
Survey by	Date 23rd Aug'61	Scale 1" = 30 ft.	Checked by		Chief Surv.

CROWN LYELL MINE
No 4 LEVEL SILL PLAN
SHEET 142

DRAWING NO.

BS-3