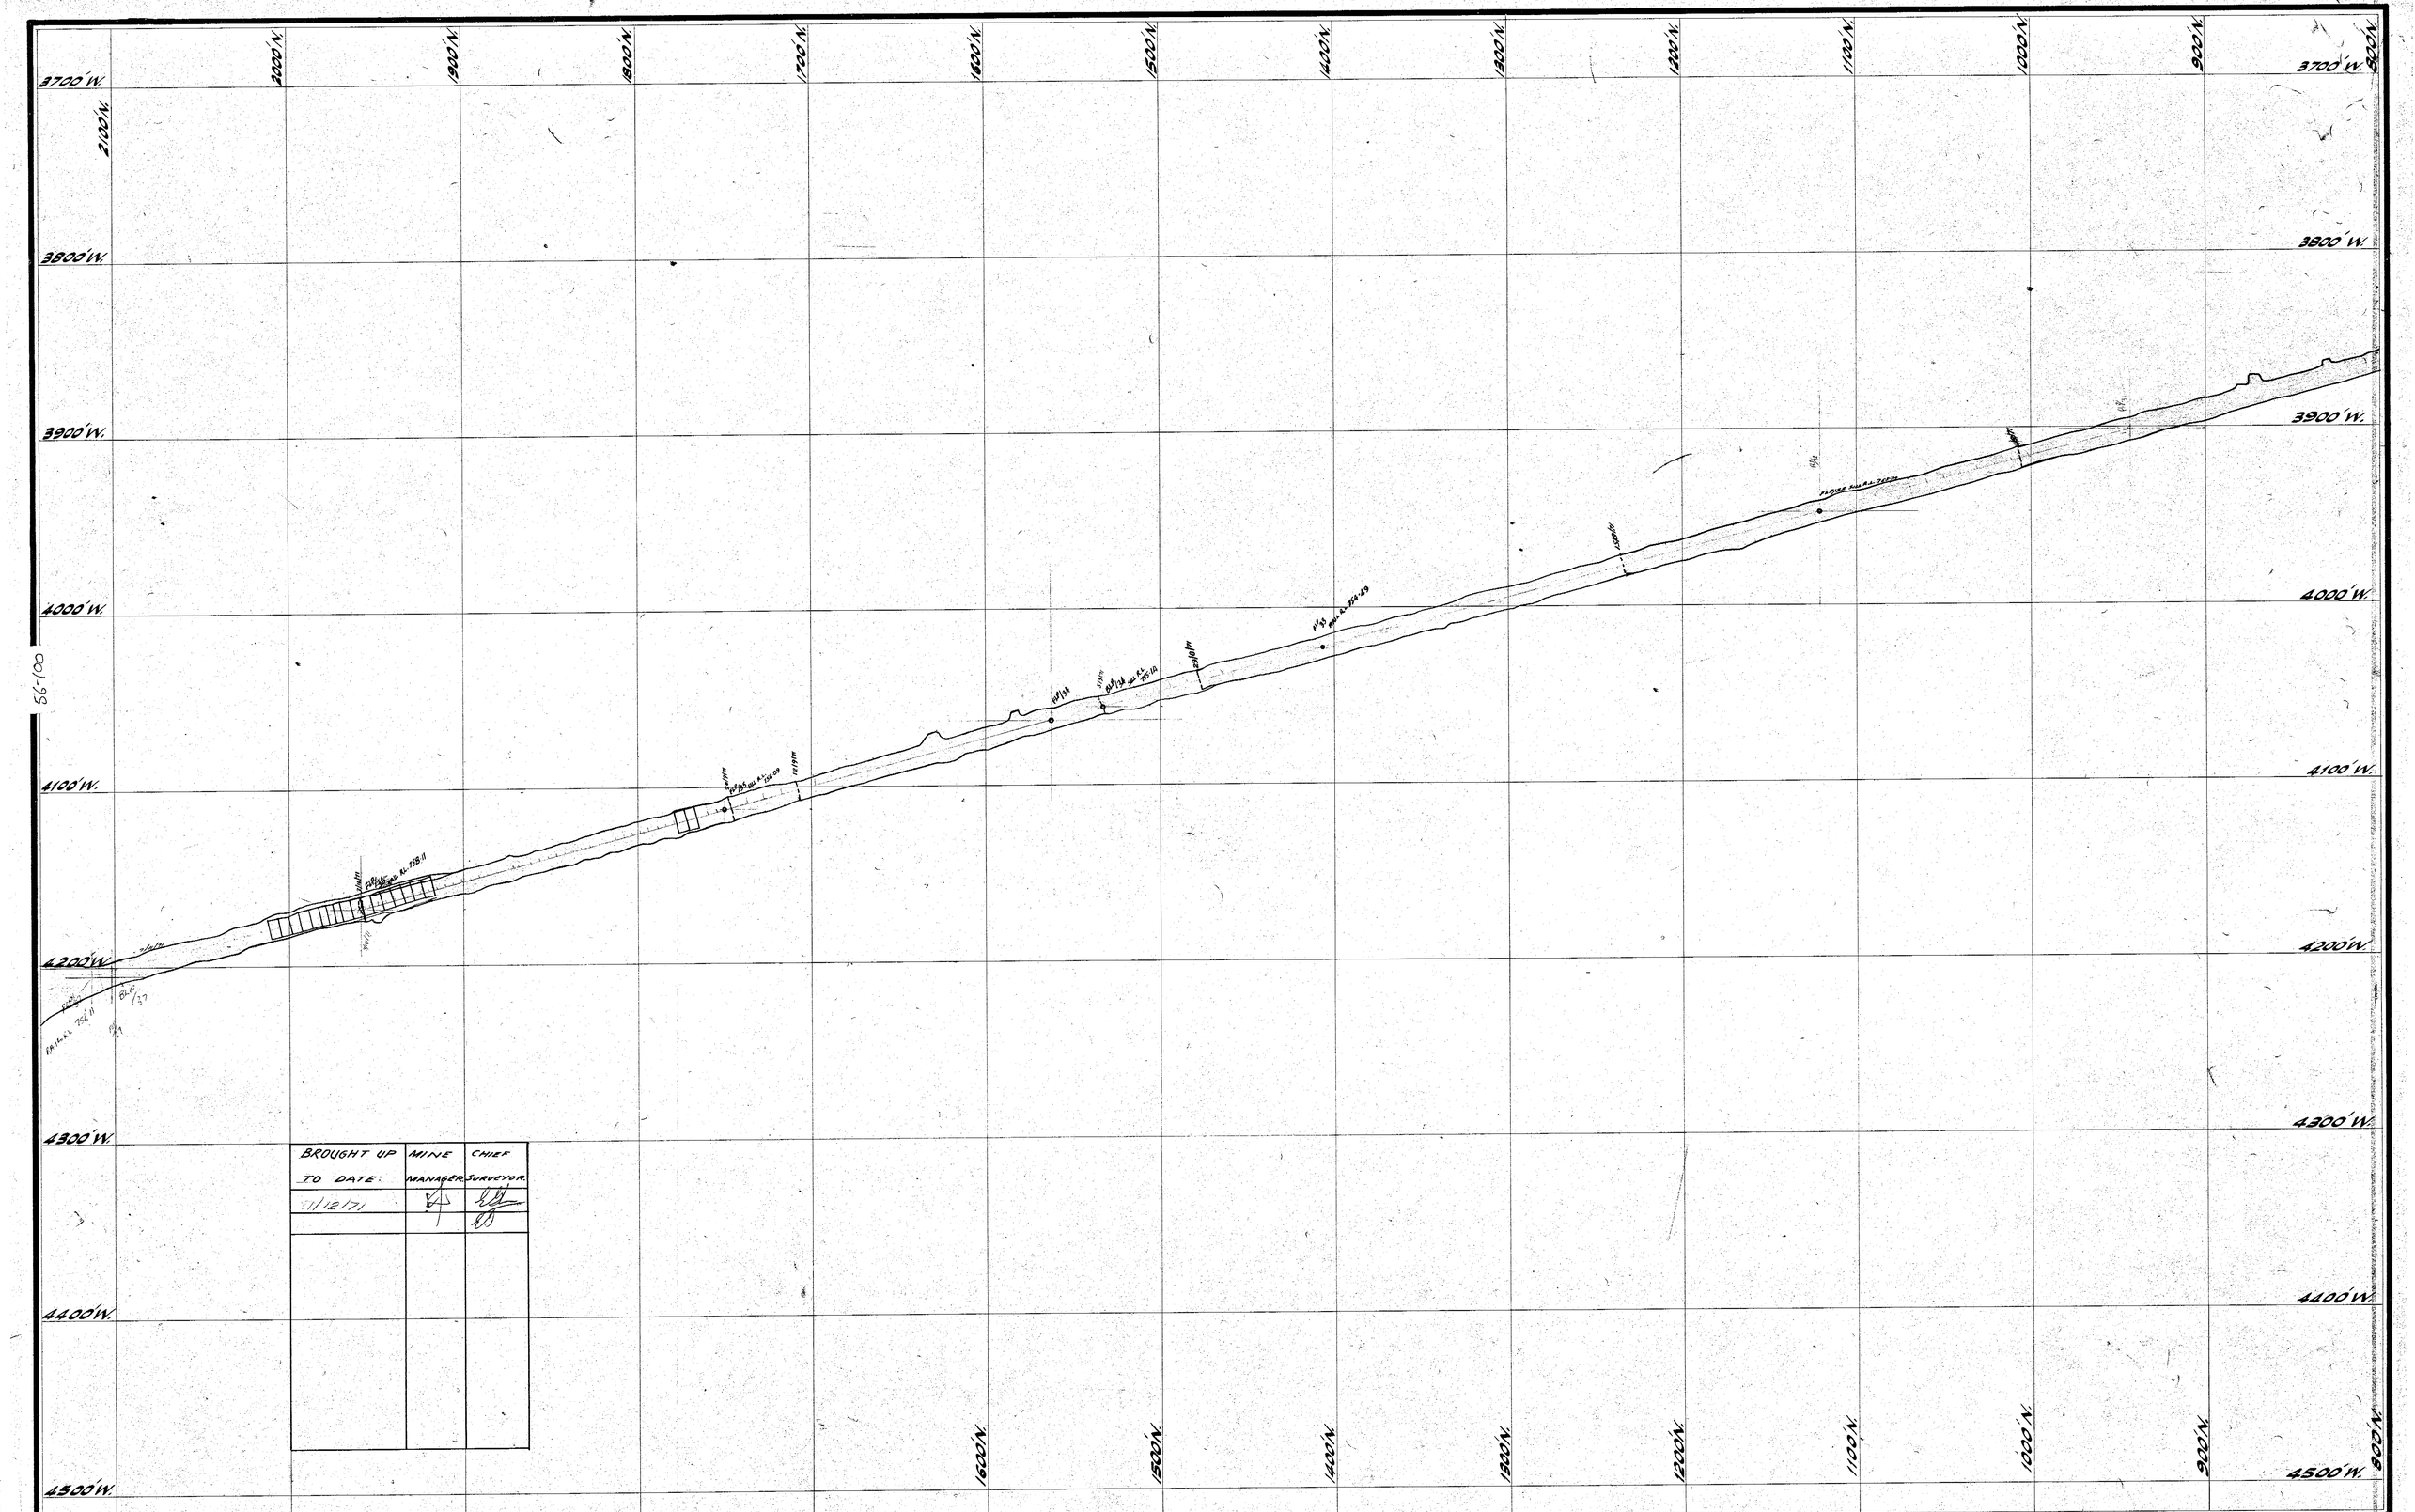

Nº	DATE	APPD	AMENDMENT

MOUNT LYELL M. & R. CO. LTD.
MINE DEPARTMENT

CAPE HORN MINE
10760 LEV SILL PLAN

Scale:	Surveyed:	APPROVED	DRAWING Nº
Date:	Designed:	U/G Mgr.	AI-7
	Drawn:	C/M Eng.	
	Traced:	C/Survr.	
	Checked:	C/Geol:	SHEET Nº 2
	Checked:	Mine Supt.	Indexed Drawer Nº