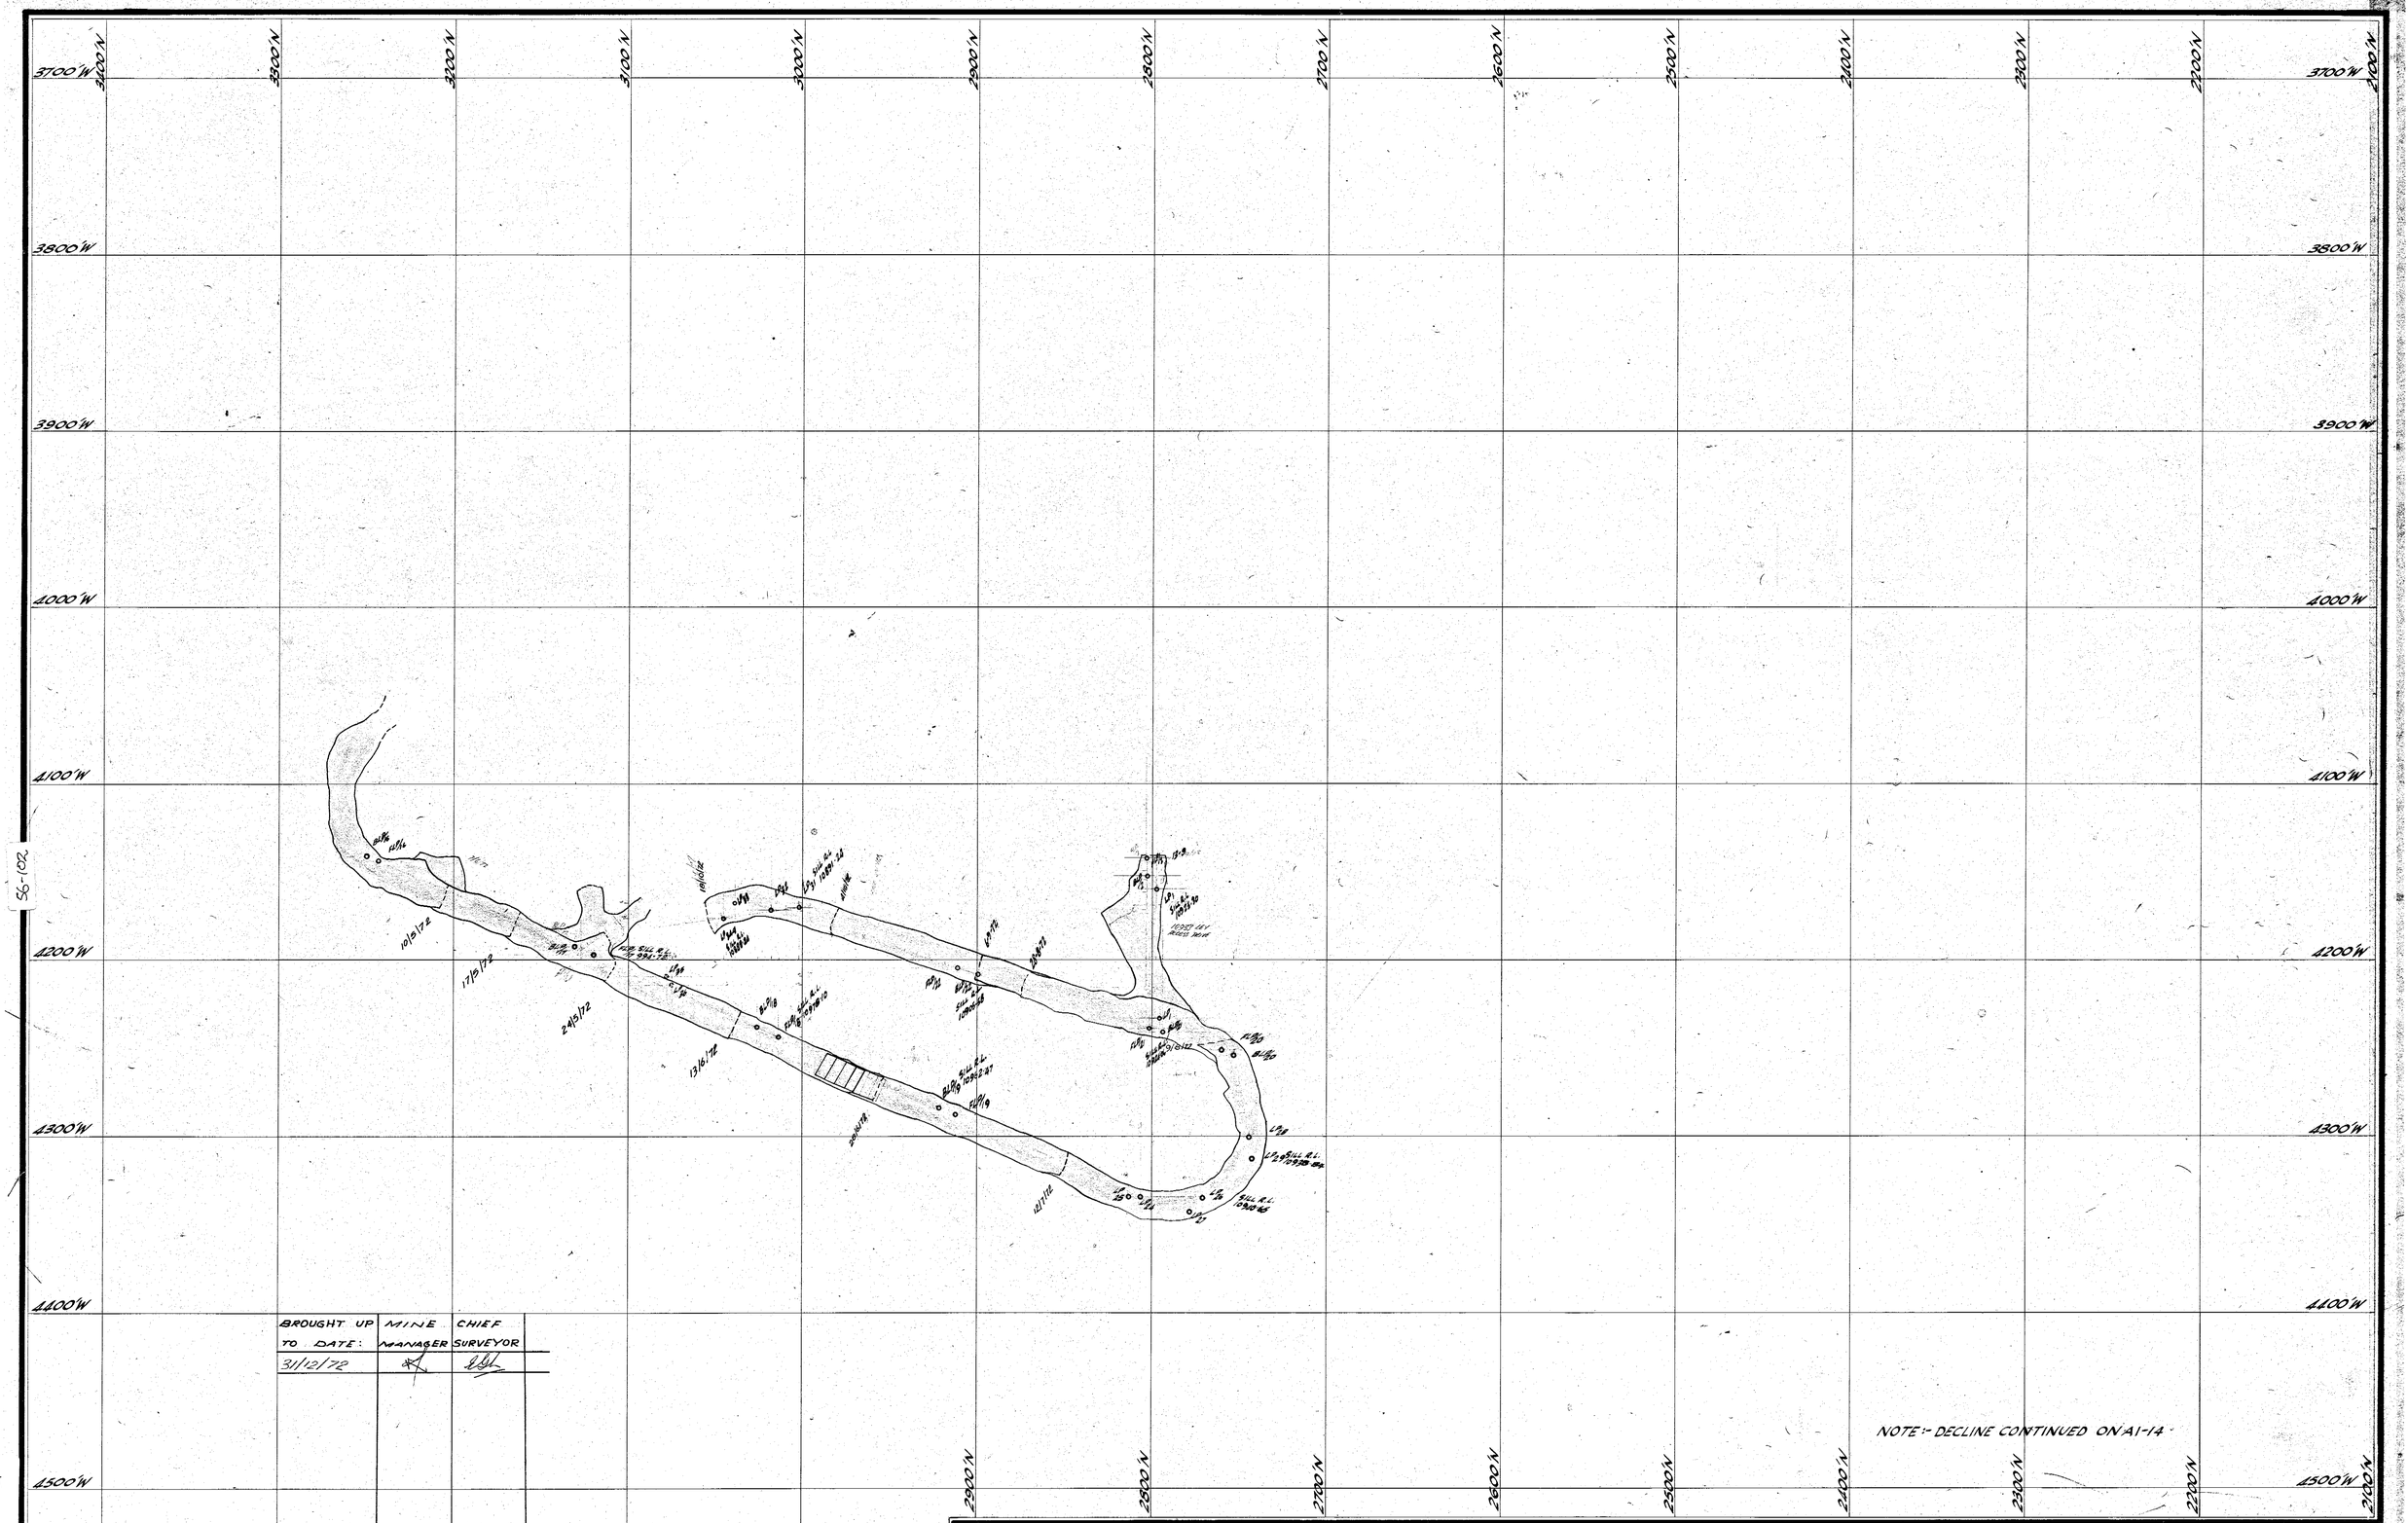

BROUGHT UP TO DATE:	MINE MANAGER	CHIEF SURVEYOR
31/12/72		

Nº	DATE	APPD	AMENDMENT

MOUNT LYELL M. & R. CO. LTD.
MINE DEPARTMENT

CAPE HORN MINE DECLINE TO 10933 ACCESS DRIVE

Scale: 1:500
Date:

		APPROVED
Surveyed:		
Designed:	U/G Mgr.	
Drawn:	C/M Eng.	
Traced:	C/Survr.	
Checked:	C/Geol:	
Checked:	Mine Supt	

DRAWING Nº A1 – 13

SHEET Nº 1

Indexed
Drawer Nº

5 cm

56-102