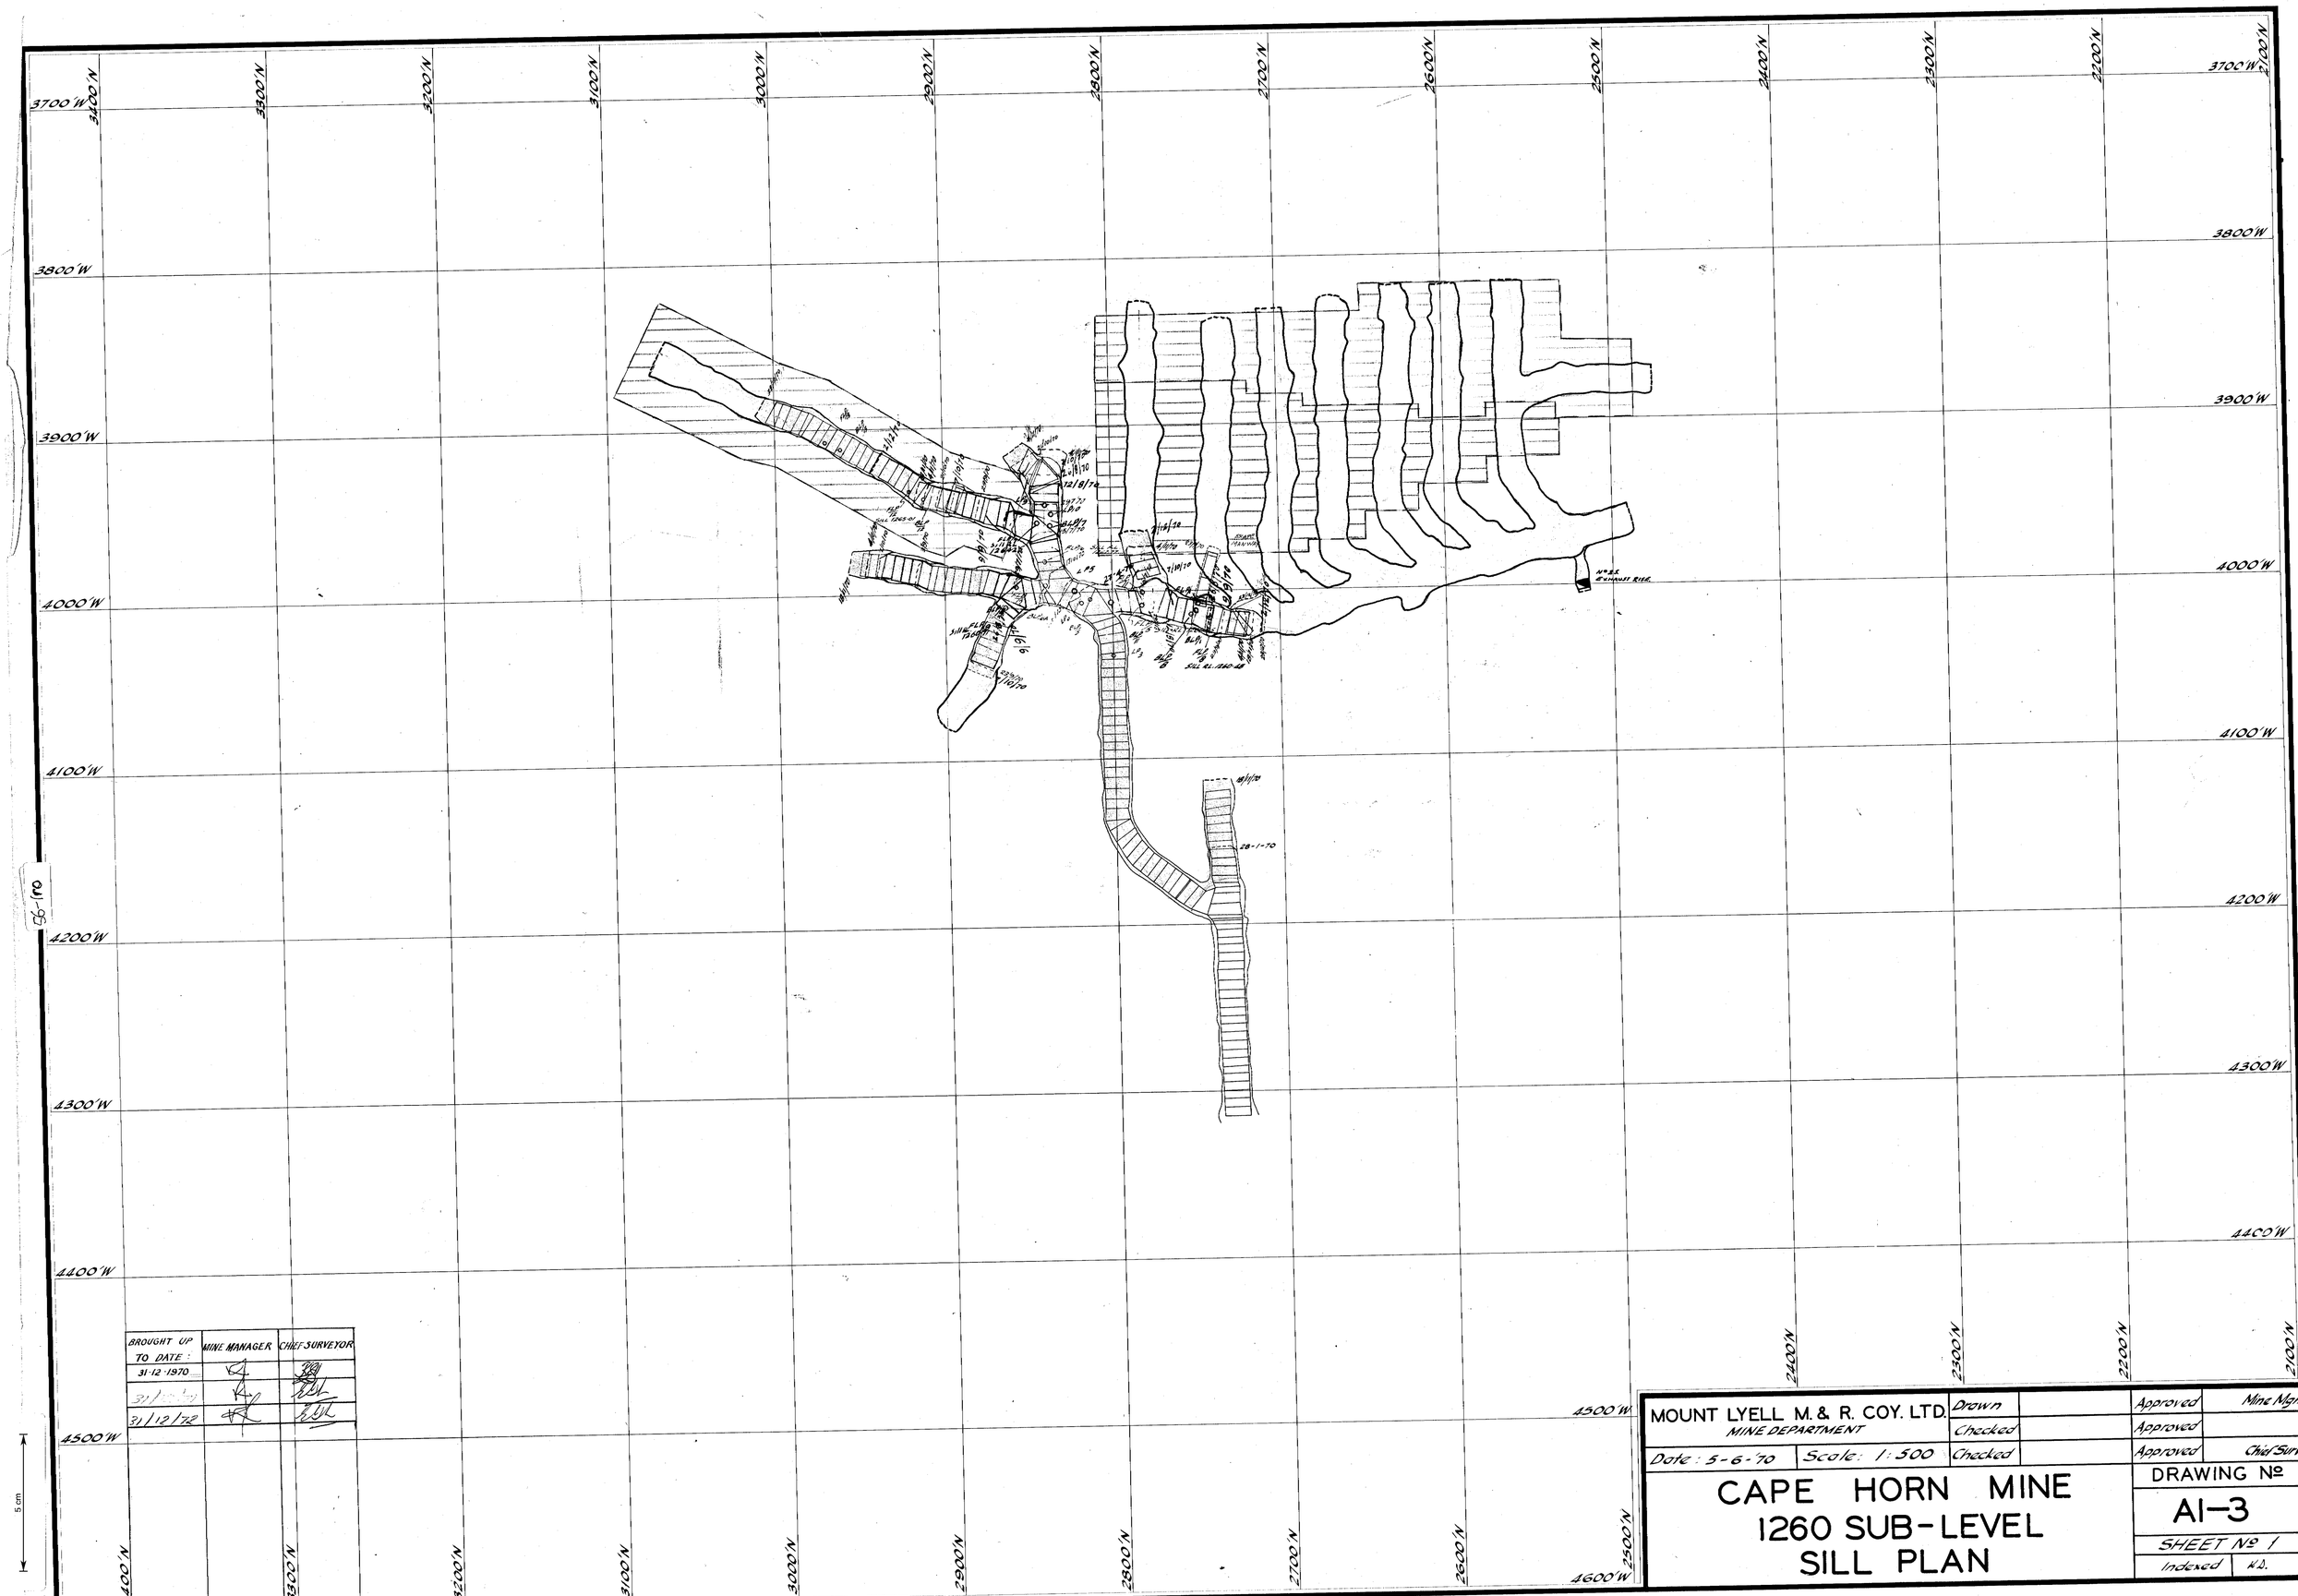
3400'N
3300'N
3200'N
3100'N
3000'N
2900'N
2800'N
2700'N
2600'N
2500'N
2400'N
2300'N
2200'N
2100'N
3700'W
3800'W
3900'W
4000'W
4100'W
4200'W
4300'W
4400'W
4500'W
4600'W
28-1-70
BROUGHT UP TO DATE :
MINE MANAGER
CHIEF SURVEYOR
31-12-1970
31/12/72
MOUNT LYELL M. & R. COY. LTD.
MINE DEPARTMENT
Drawn
Checked
Approved
Mine Mgr.
Date : 5-6-70
Scale: 1:500
Checked
Approved
Chief Surv.
CAPE HORN MINE
1260 SUB-LEVEL
SILL PLAN
DRAWING No
A1-3
SHEET No 1
Indexed
K.D.
5 cm