56-120

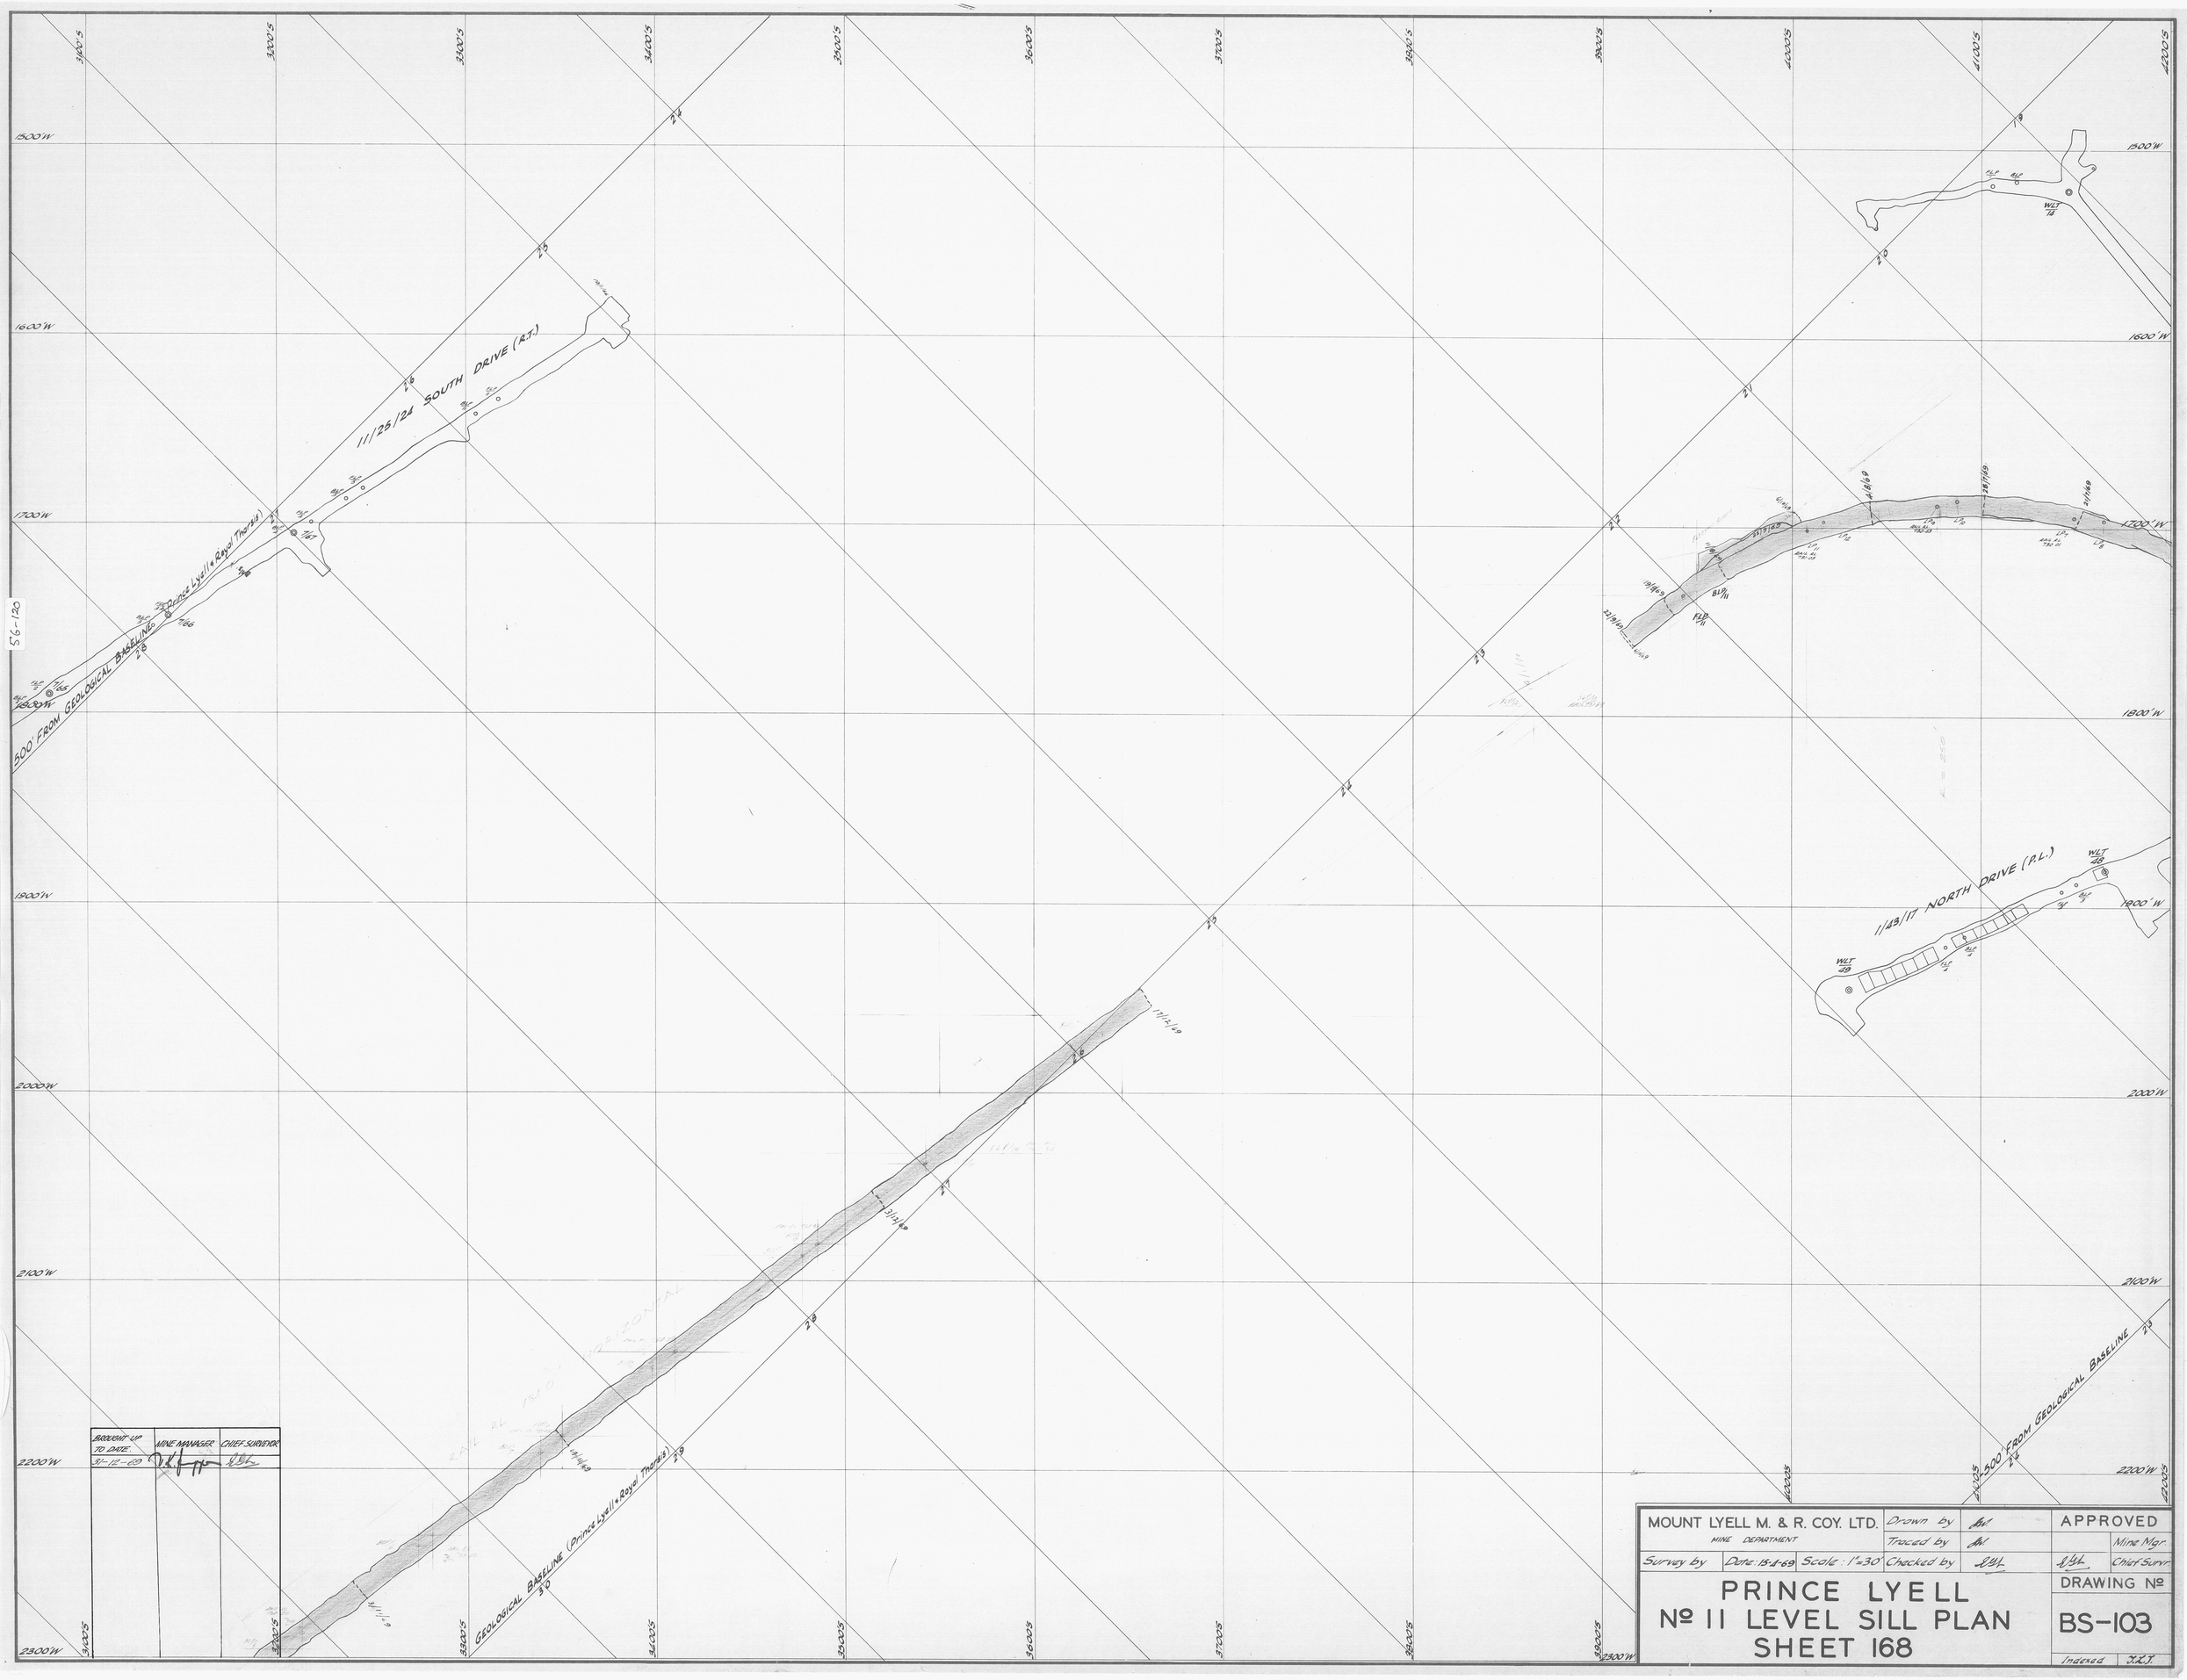
11/25/24 SOUTH DRIVE (R.T.)
500' FROM GEOLOGICAL BASELINE
Prince Lyell & Royal Thorne
GEOLOGICAL BASELINE (Prince Lyell & Royal Thorne)
11/43/17 NORTH DRIVE (R.L.)
500' FROM GEOLOGICAL BASELINE
WLT 18
WLT 48
WLT 49
1500'W
1600'W
1700'W
1800'W
1900'W
2000'W
2100'W
2200'W
2300'W
3100'S
3200'S
3300'S
3400'S
3500'S
3600'S
3700'S
3800'S
3900'S
4000'S
4100'S
4200'S
BROUGHT UP TO DATE: 31-12-69
MINE MANAGER
CHIEF SURVEYOR
MOUNT LYELL M. & R. COY. LTD.
MINE DEPARTMENT
Drawn by
Traced by
Checked by
Survey by
Date: 15-1-69
Scale: 1"=30'
APPROVED
Mine Mgr.
Chief Surv.
PRINCE LYELL
№ 11 LEVEL SILL PLAN
SHEET 168
DRAWING №
BS-103
Indexed
