The Mount Lyell Mining & Railway Co., Ltd.

Mine Department

SHEET No 1

General Manager

Mine Superintendent

FIELD NOTES OF UNDERGROUND WORKINGS UP TO **31-12-30**
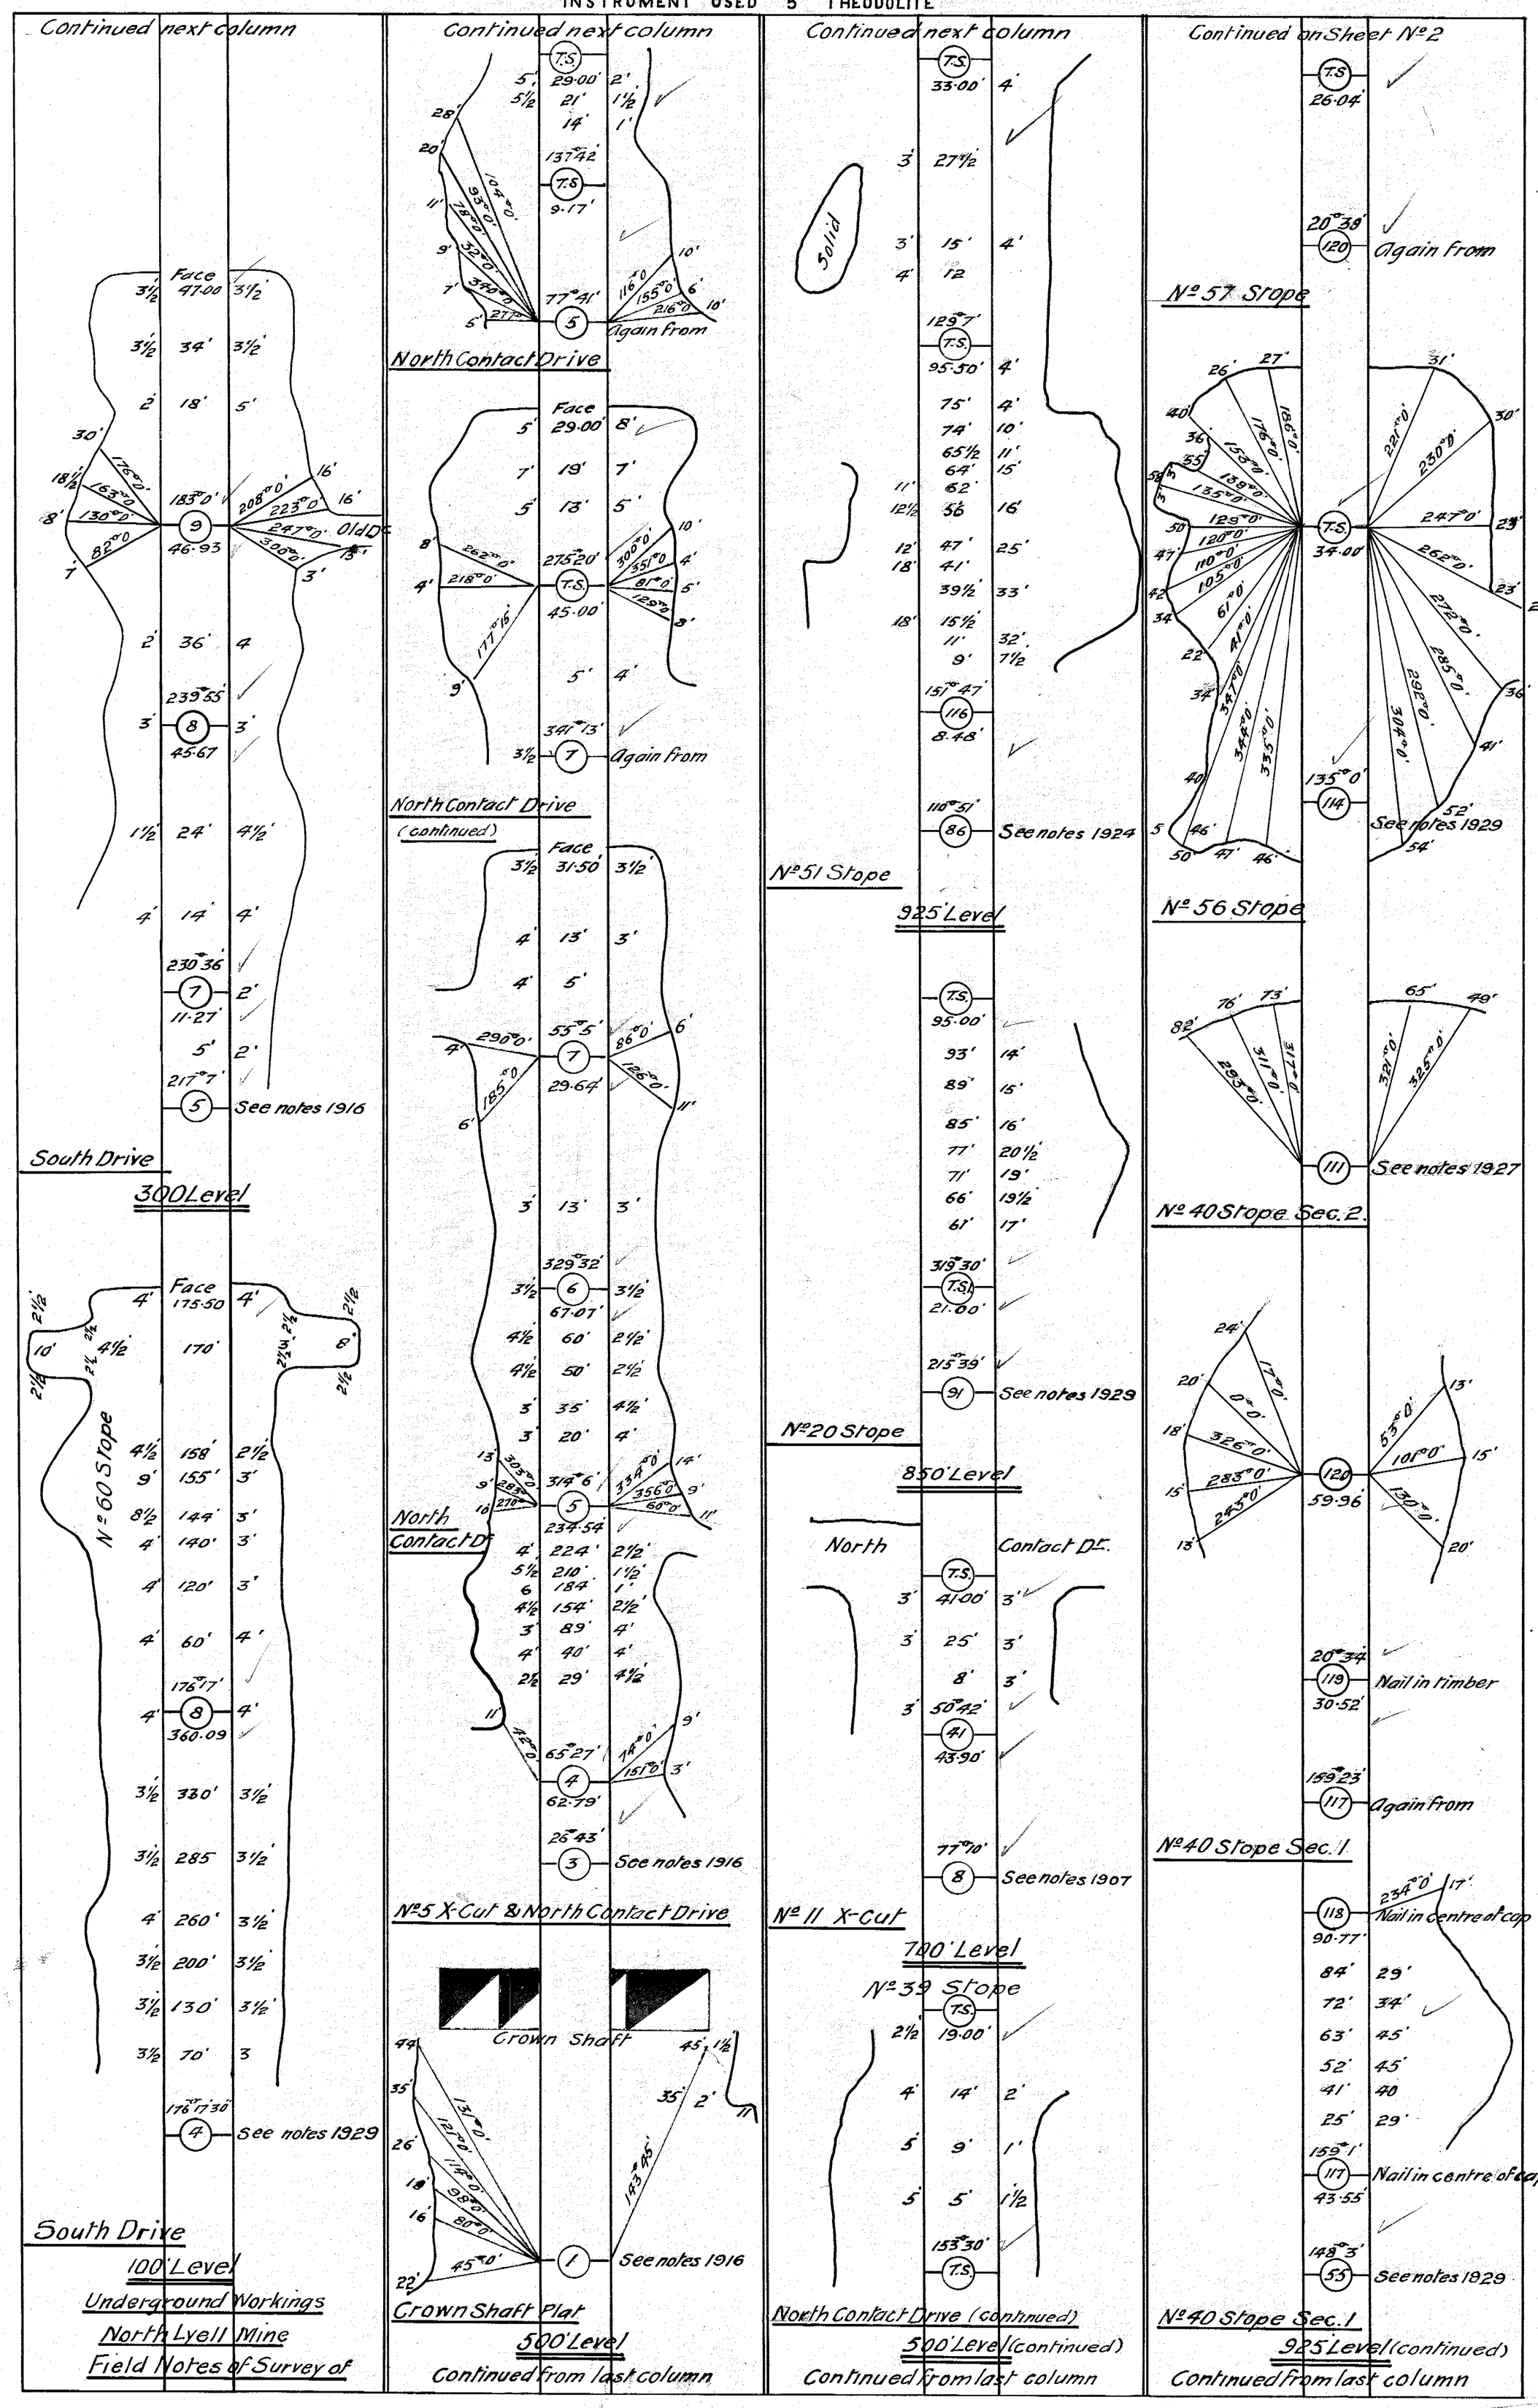
INSTRUMENT USED 5" THEODOLITE