# The Mount Lyell Mining & Railway Co., Ltd.

**Mine Department**

**SHEET No 3**

R. H. Murray : General Manager
G. Fred. Jakins : Mine Superintendent

FIELD NOTES OF UNDERGROUND WORKINGS UP TO **31-12-30**
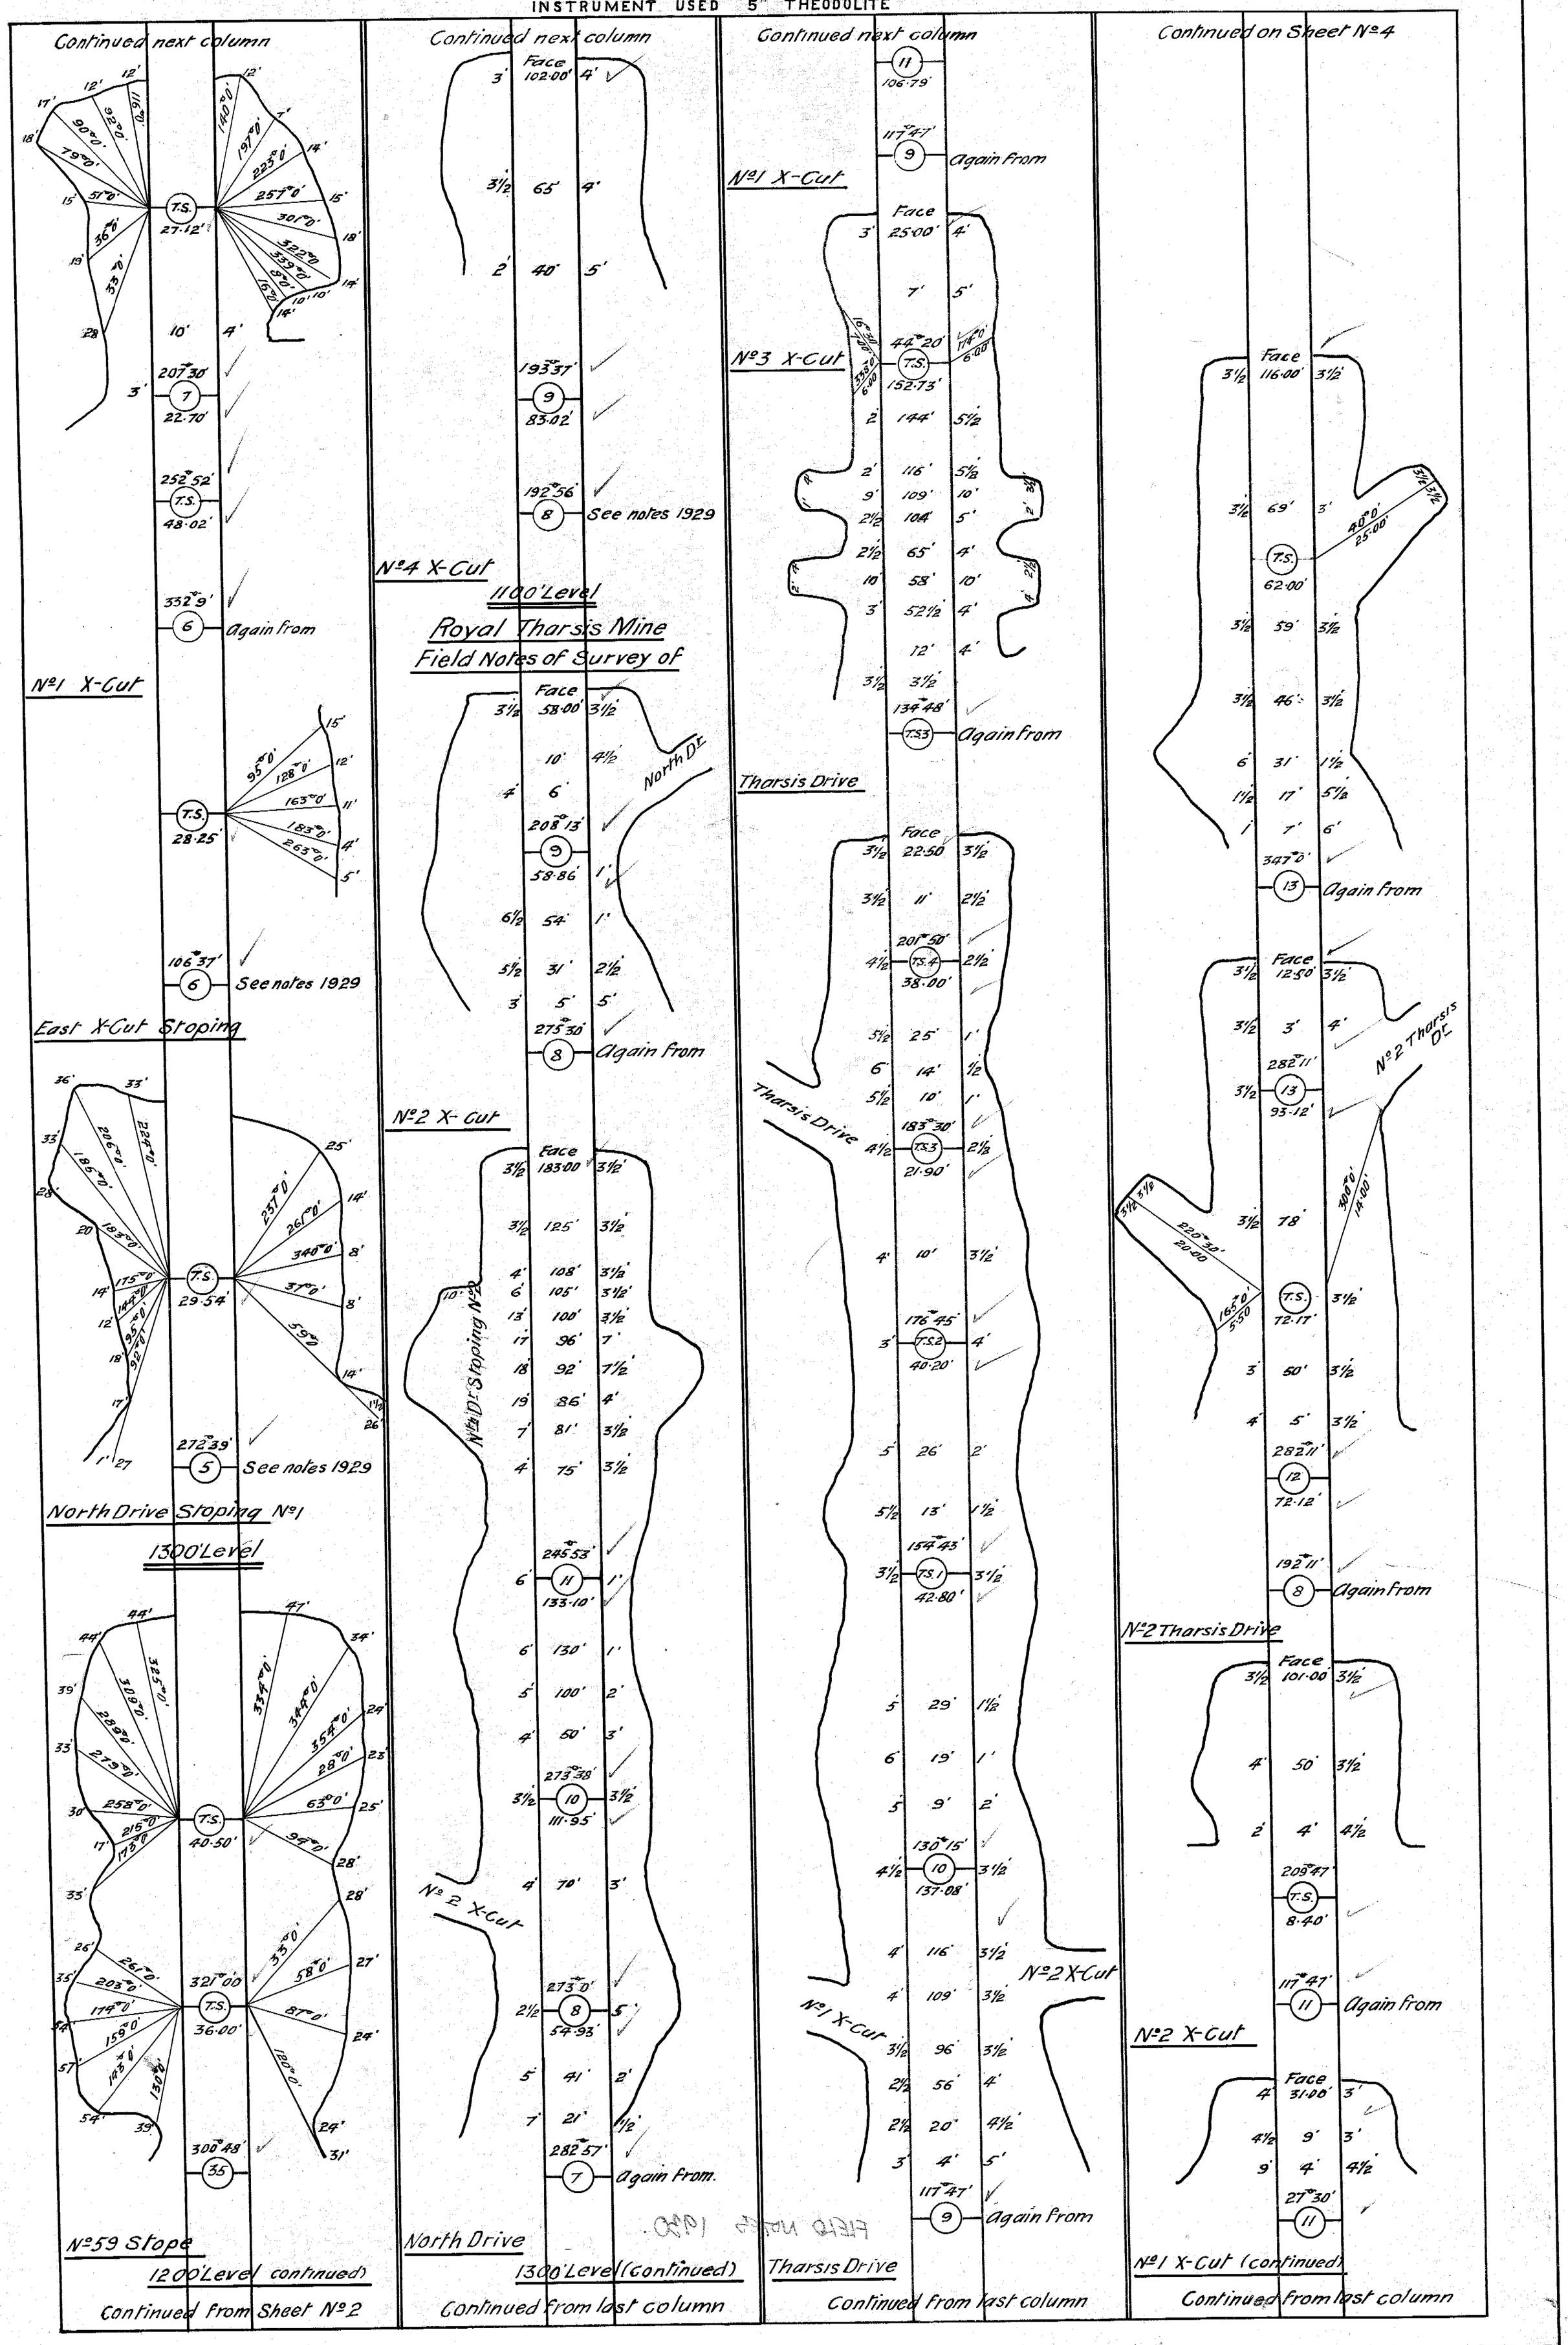
INSTRUMENT USED 5" THEODOLITE