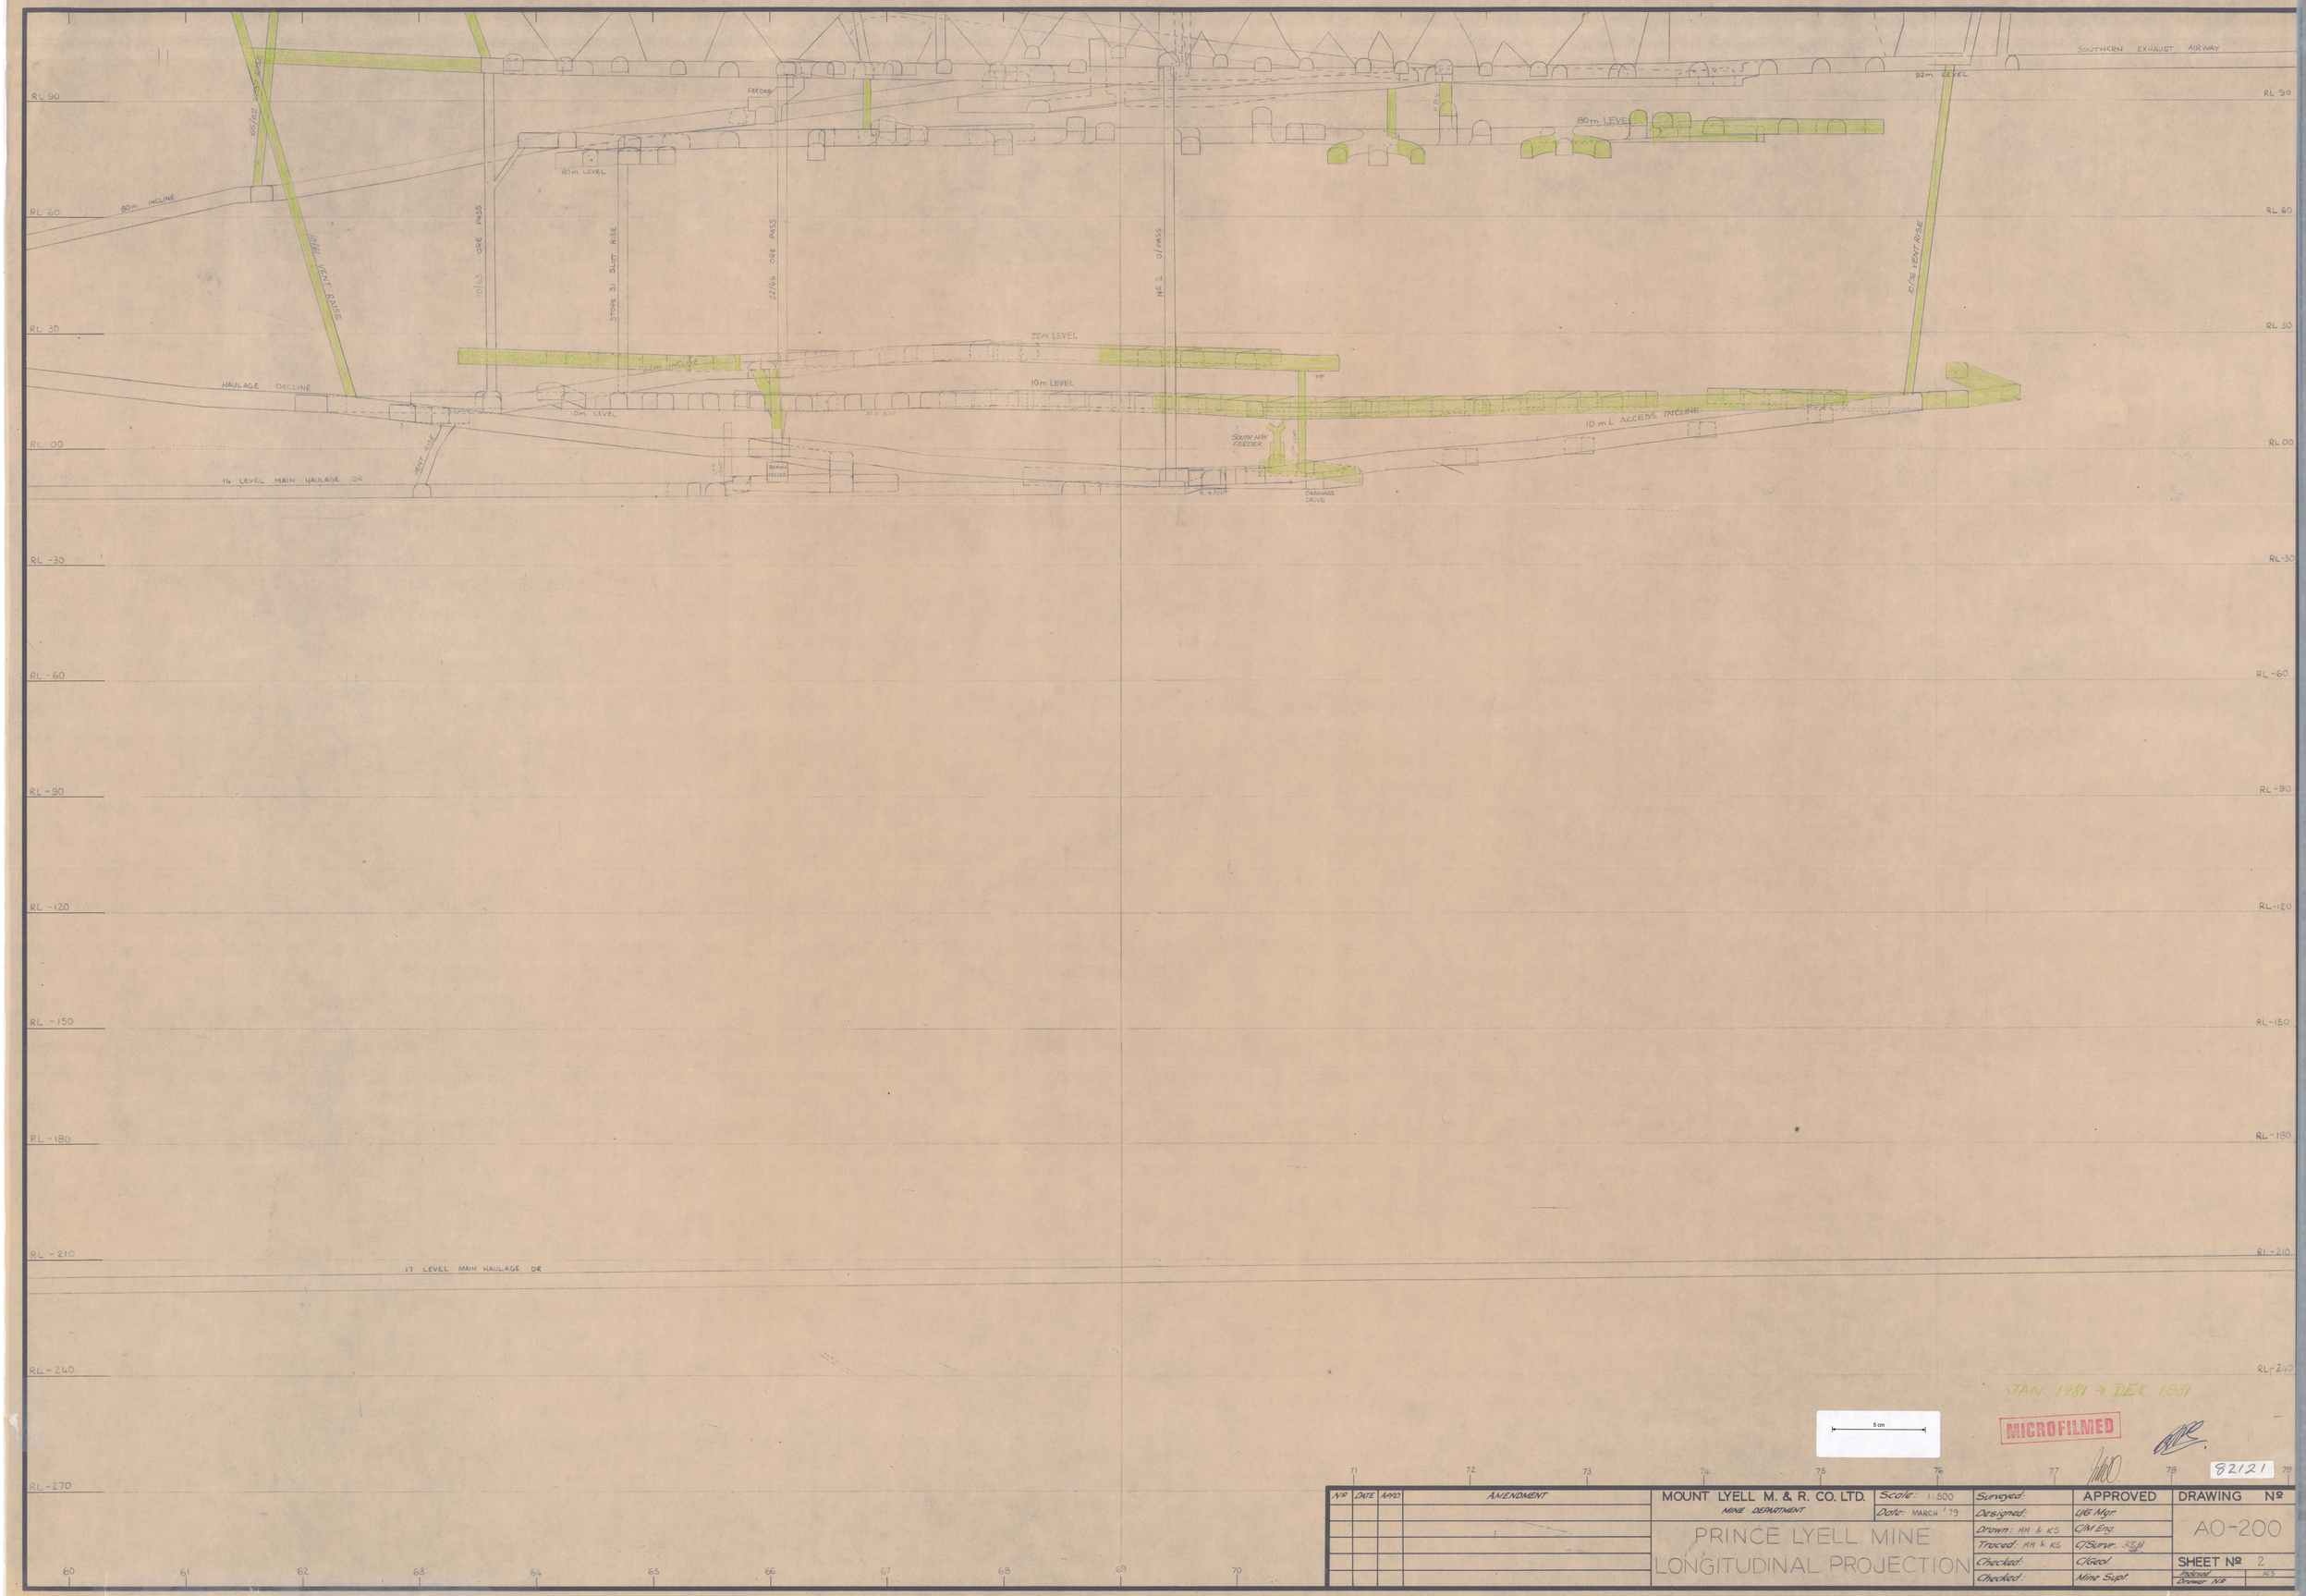

JAN 1981 → DEC 1981

5 cm

MICROFILMED

82121

Nº	DATE	APPD	AMENDMENT

MOUNT LYELL M. & R. CO. LTD.
MINE DEPARTMENT

PRINCE LYELL MINE
LONGITUDINAL PROJECTION

Scale: 1:500
Date: MARCH '79

Surveyed:	APPROVED	DRAWING Nº
Designed:	UG Mgr.	AO-200
Drawn: MM & KS	Civil Eng.	
Traced: MM & KS	Survr.	SHEET Nº 2
Checked:	Geol.	
Checked:	Mine Supt.	Indexed Drawer Nº 165

0056 - 183