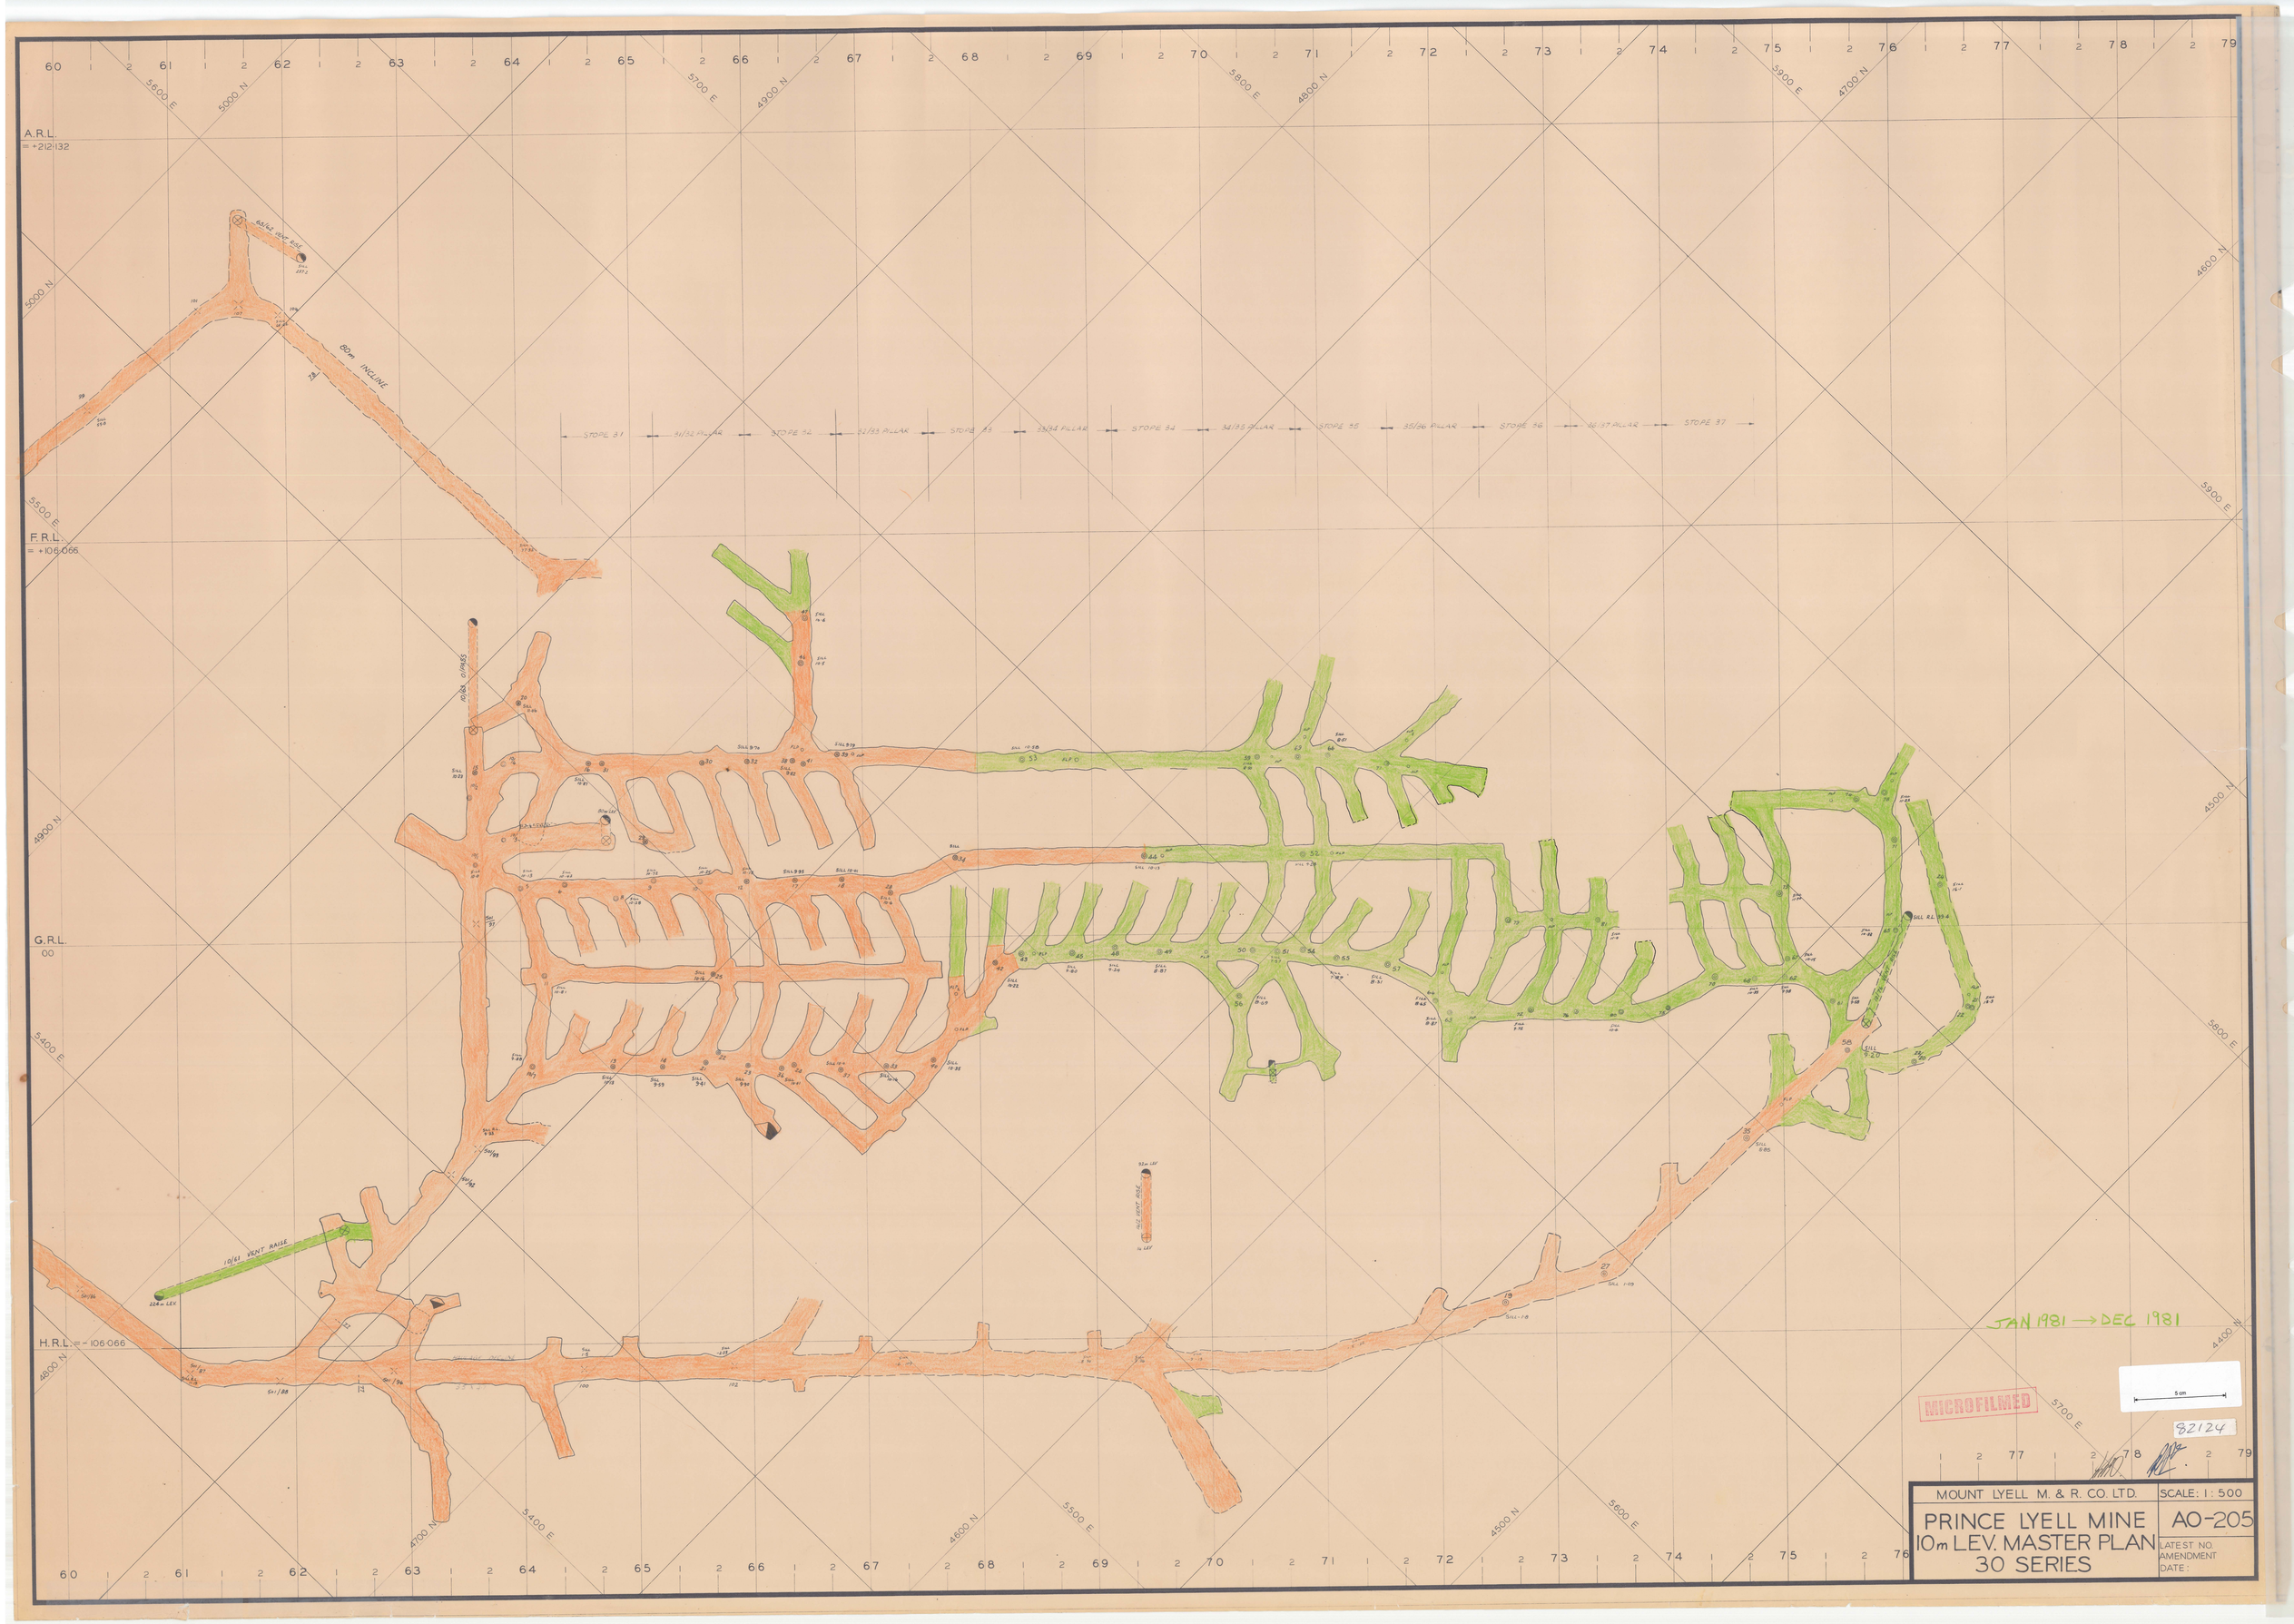
A.R.L.
= +212·132
F.R.L.
= +106·066
G.R.L.
00
H.R.L. = -106·066
80m INCLINE
STOPE 31
31/32 PILLAR
STOPE 32
32/33 PILLAR
STOPE 33
33/34 PILLAR
STOPE 34
34/35 PILLAR
STOPE 35
35/36 PILLAR
STOPE 36
36/37 PILLAR
STOPE 37
10/61 VENT RAISE
JAN 1981 → DEC 1981
MICROFILMED
82124
MOUNT LYELL M. & R. CO. LTD.
SCALE: 1 : 500
PRINCE LYELL MINE
10m LEV. MASTER PLAN
30 SERIES
AO-205
LATEST NO.
AMENDMENT
DATE: