58-07

5 cm

58-07

PLAN

OF THE

WALLSEND COLLIERY WORKINGS

Scale.- One Chain to An Inch.

Reference

Faults :- 2'0"

Work ceased 13/11/10

Workings Plotted to 13/11/10

R. H. Stokes.

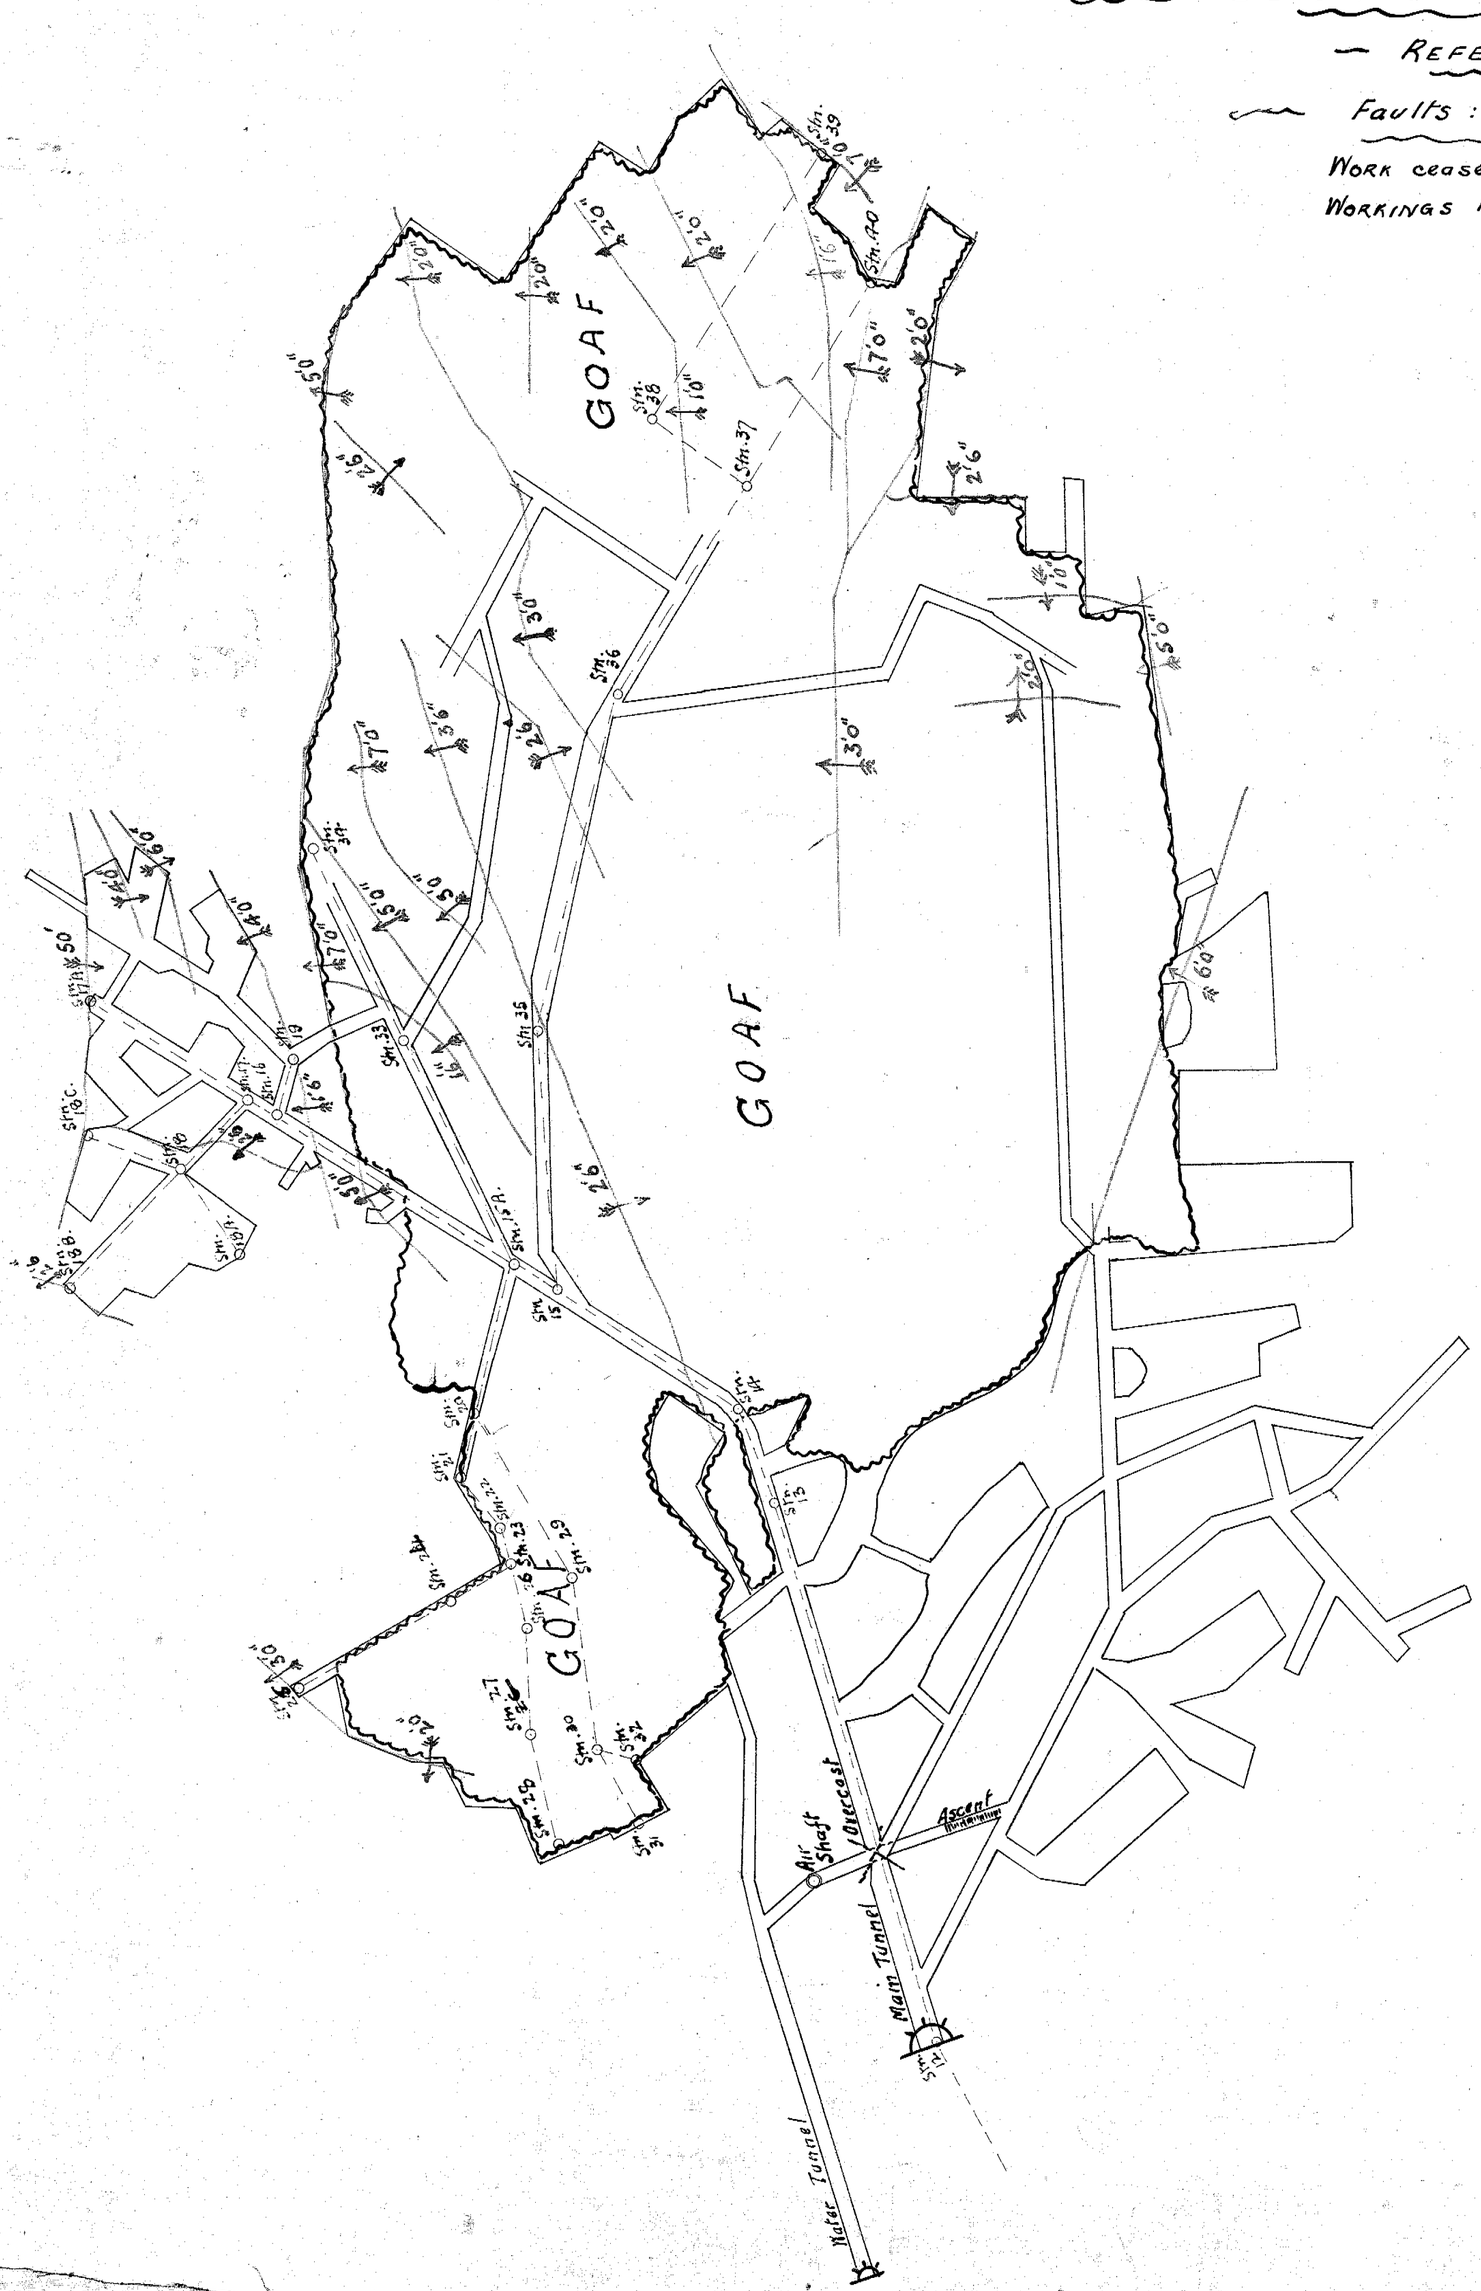

218