SANDFLY COAL MINE

MESSRS. FOGARTY BROS.

UNDERGROUND WORKINGS

SCALE ~~40~~ 50' FT TO AN INCH

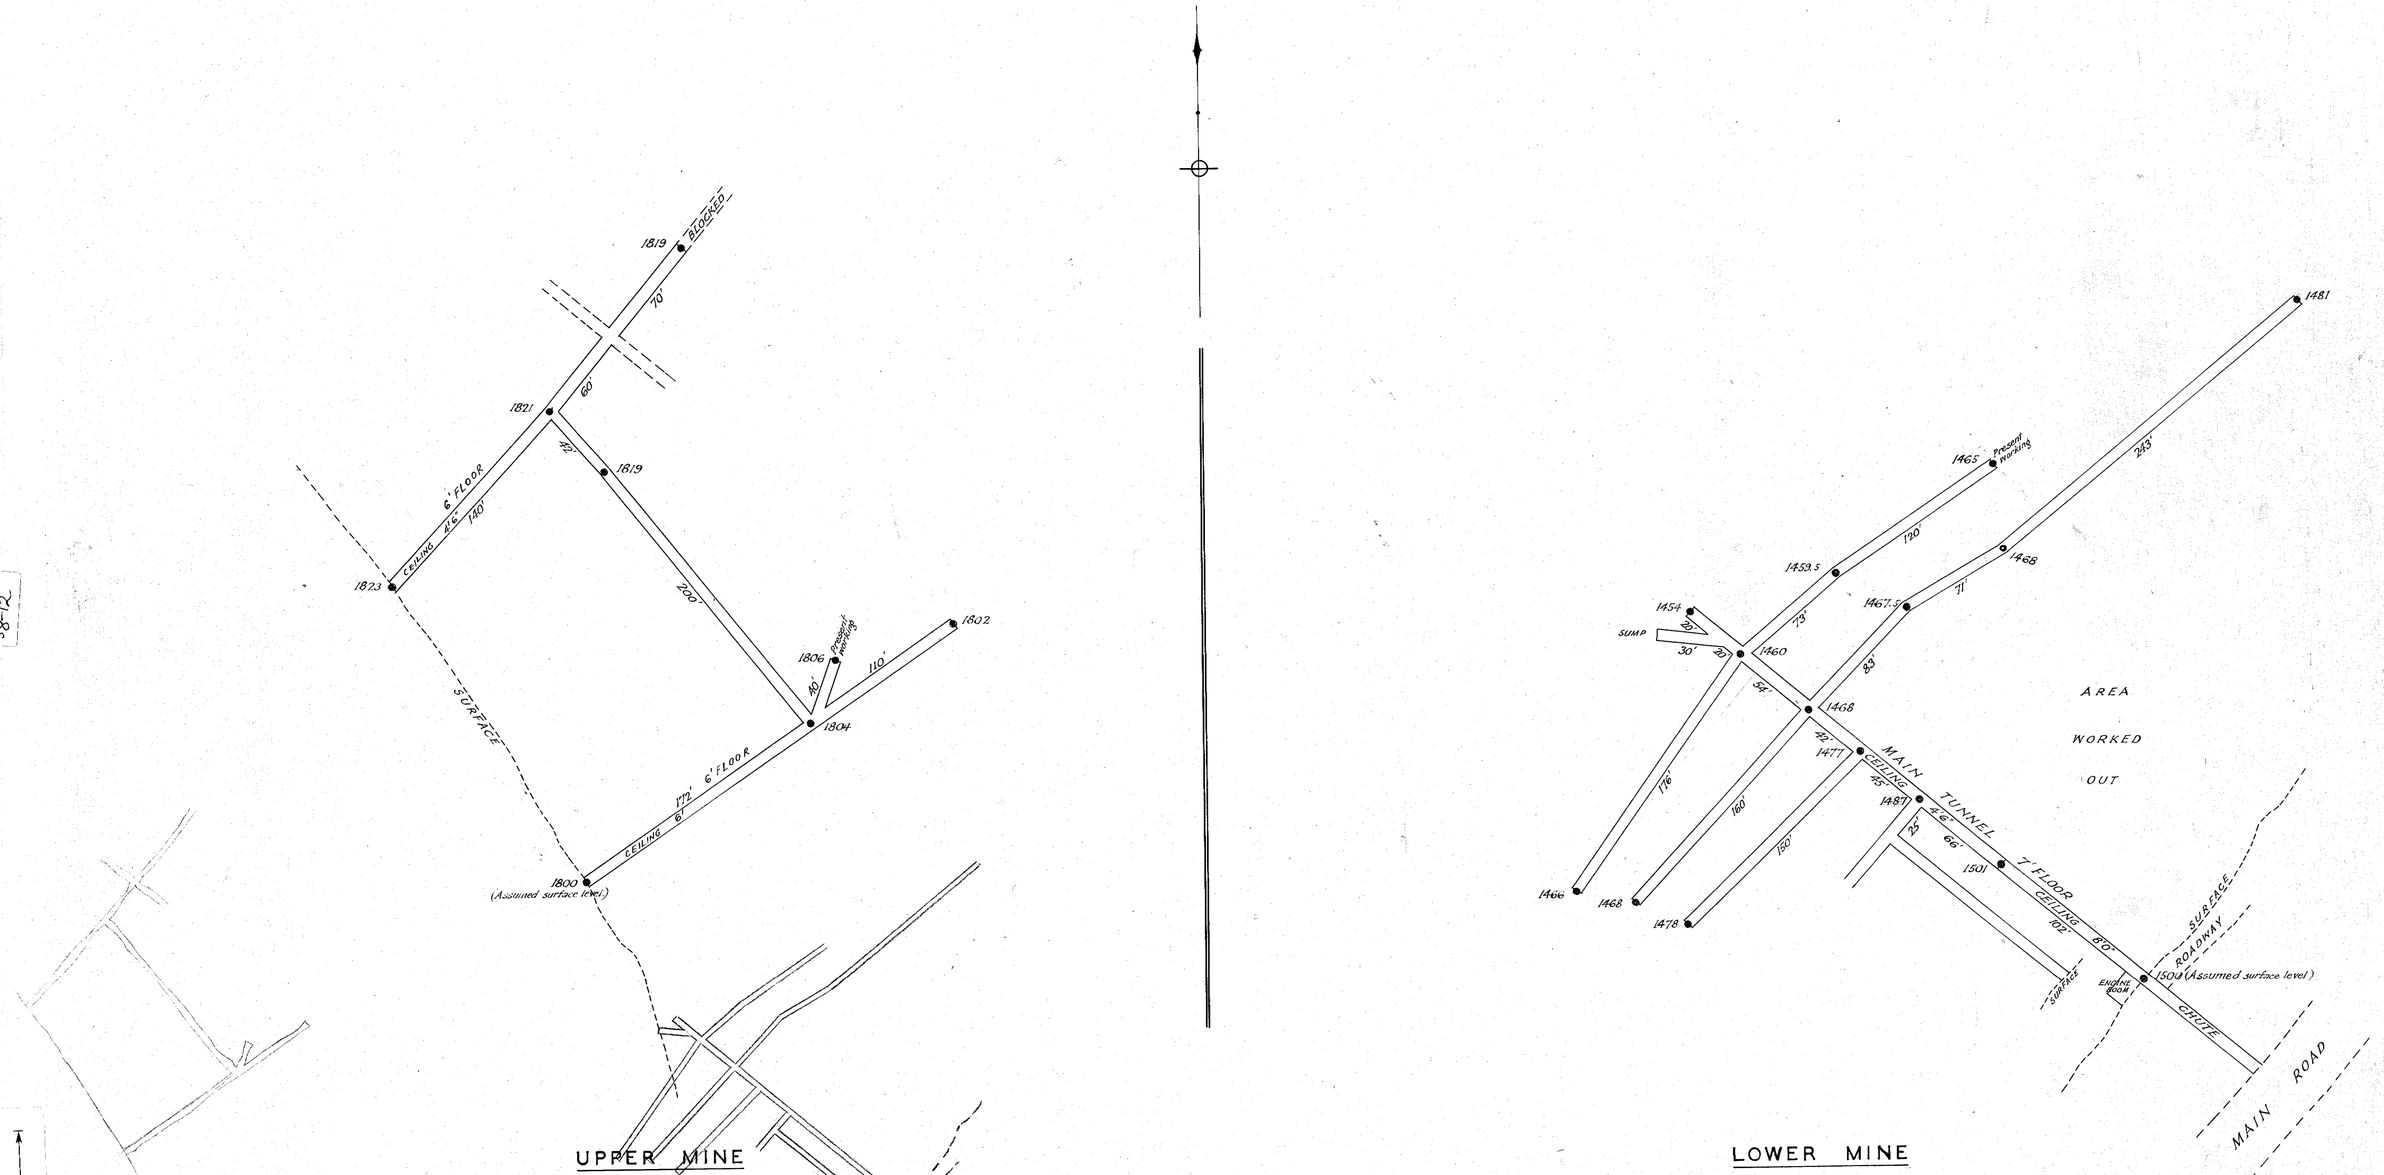

58-12

58-12

K.A. Terry
Lic'd Surveyor
12/8/41