


5 cm

58-14

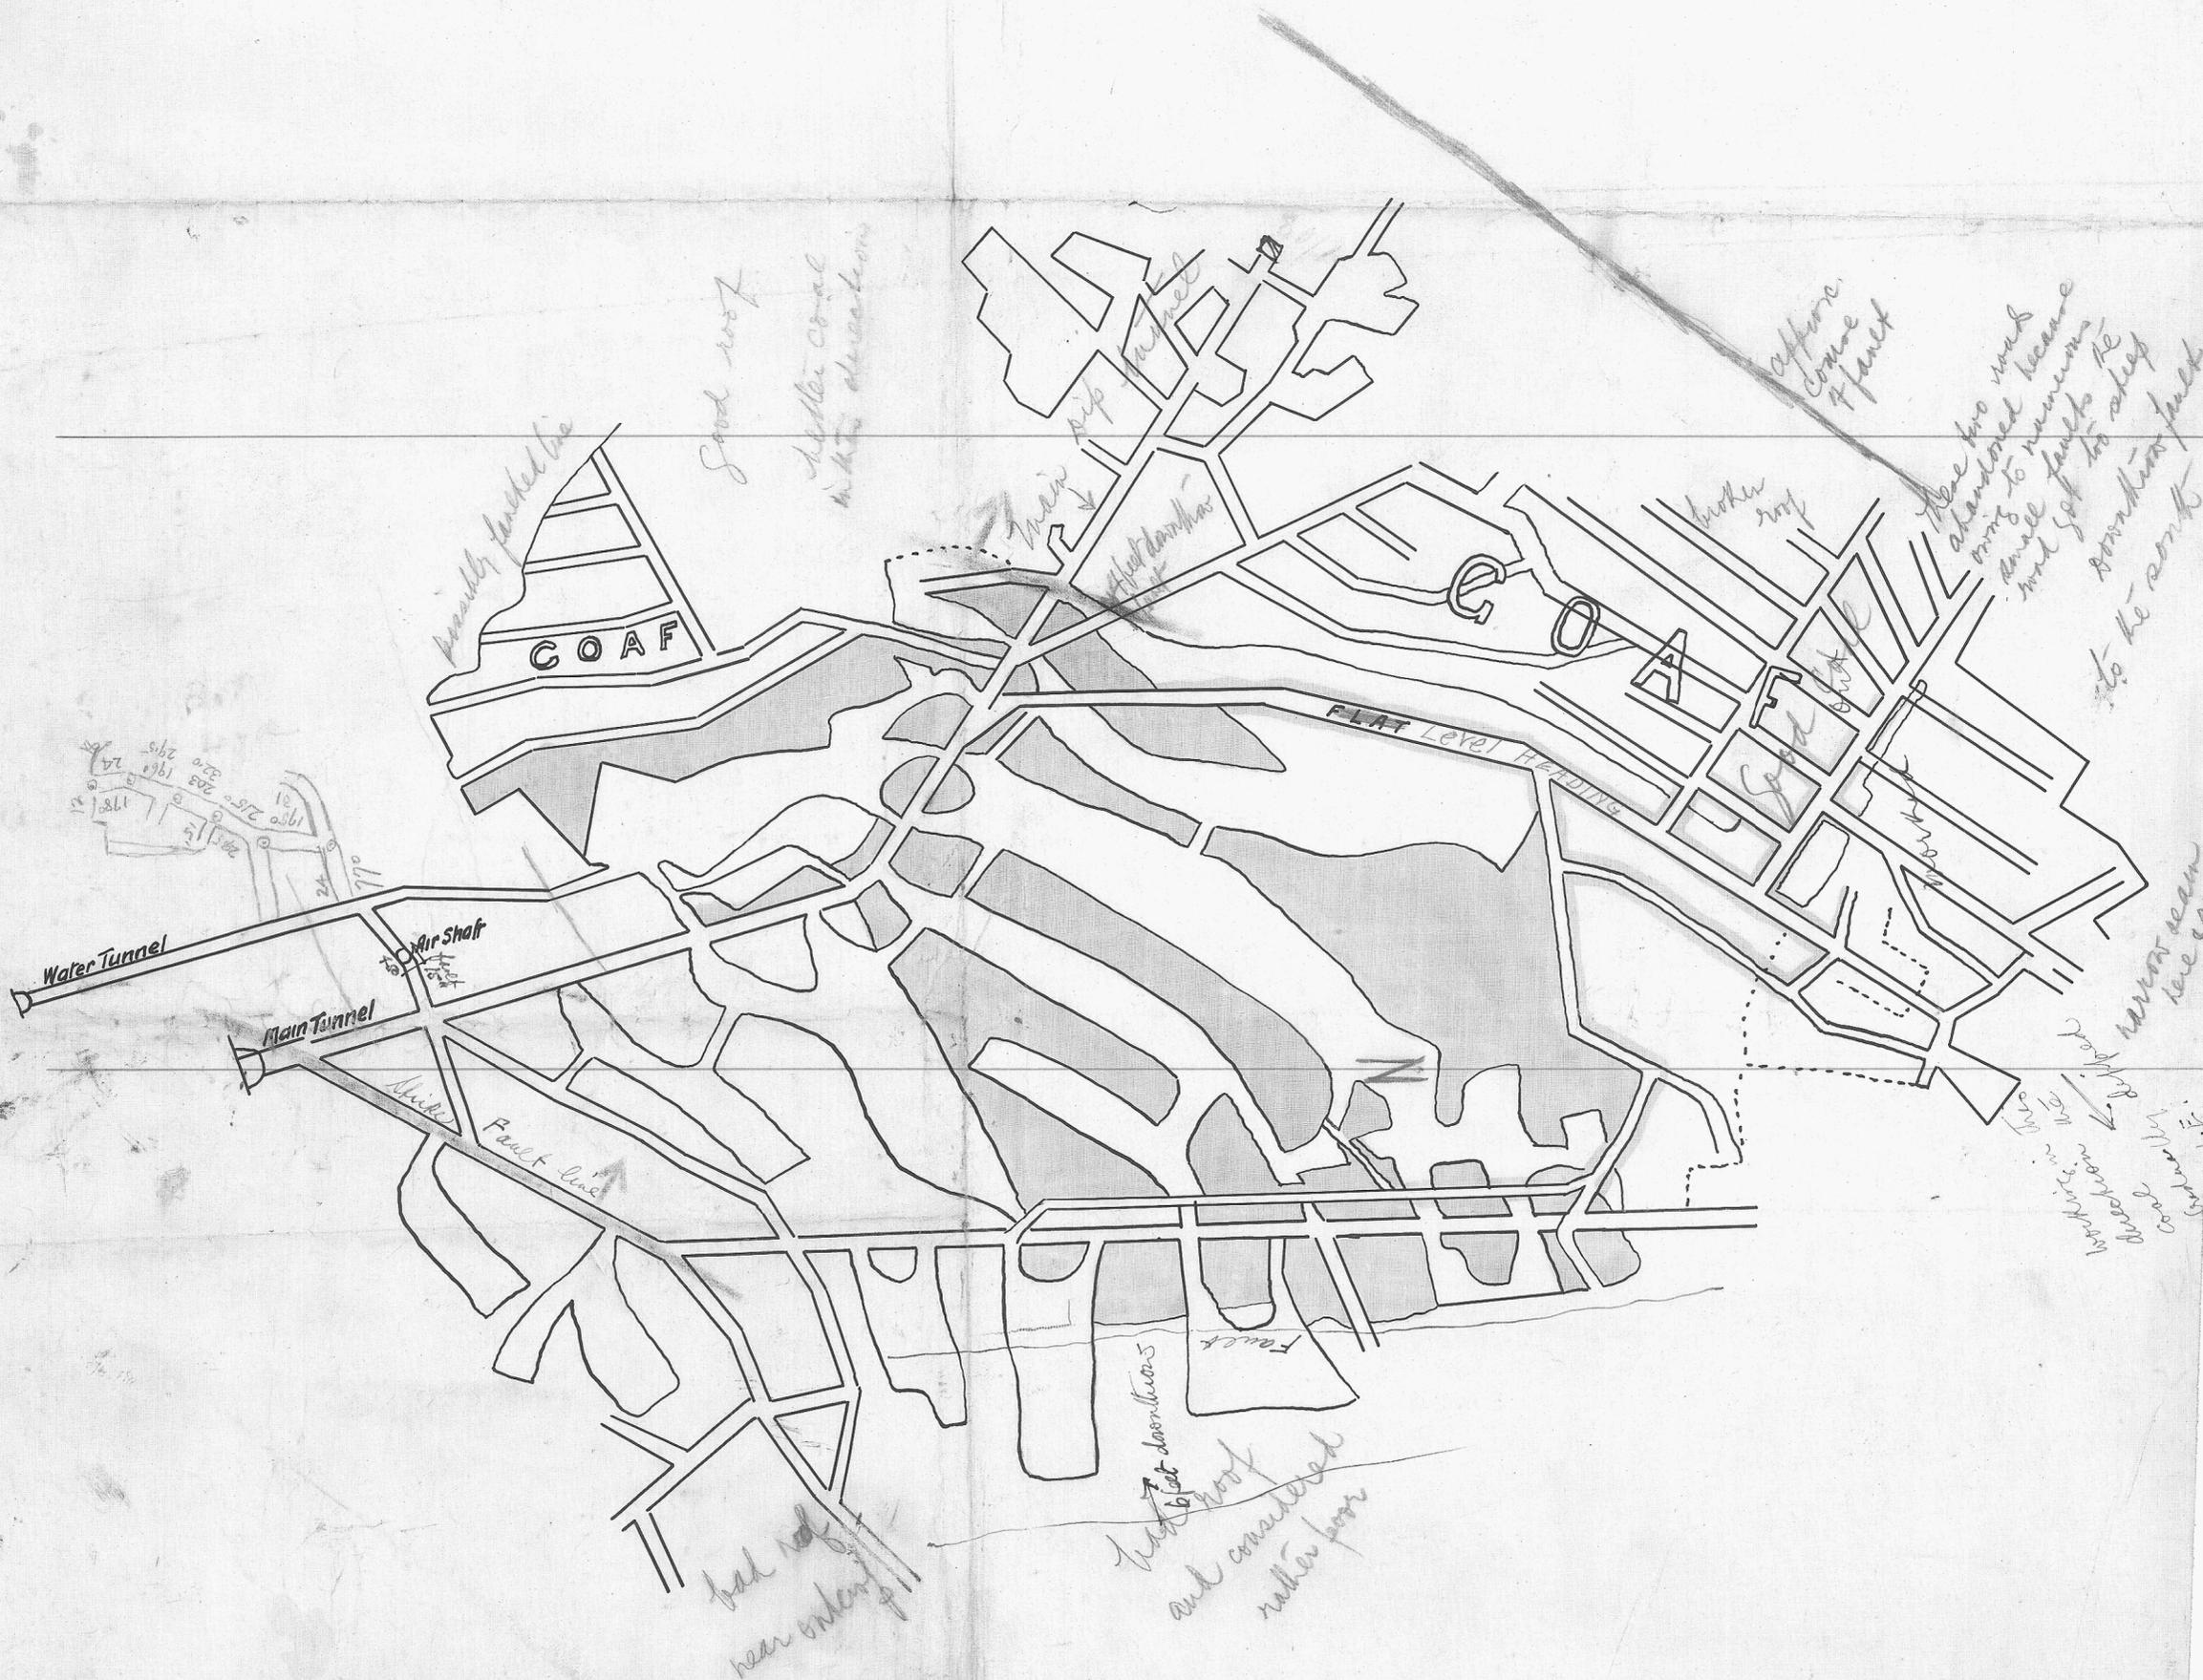


1535  
 270  
 1265

1210