59-16

5 cm

NORTH MOUNT FARRELL MINING Co., N.L.

M.L. No. 3818 M

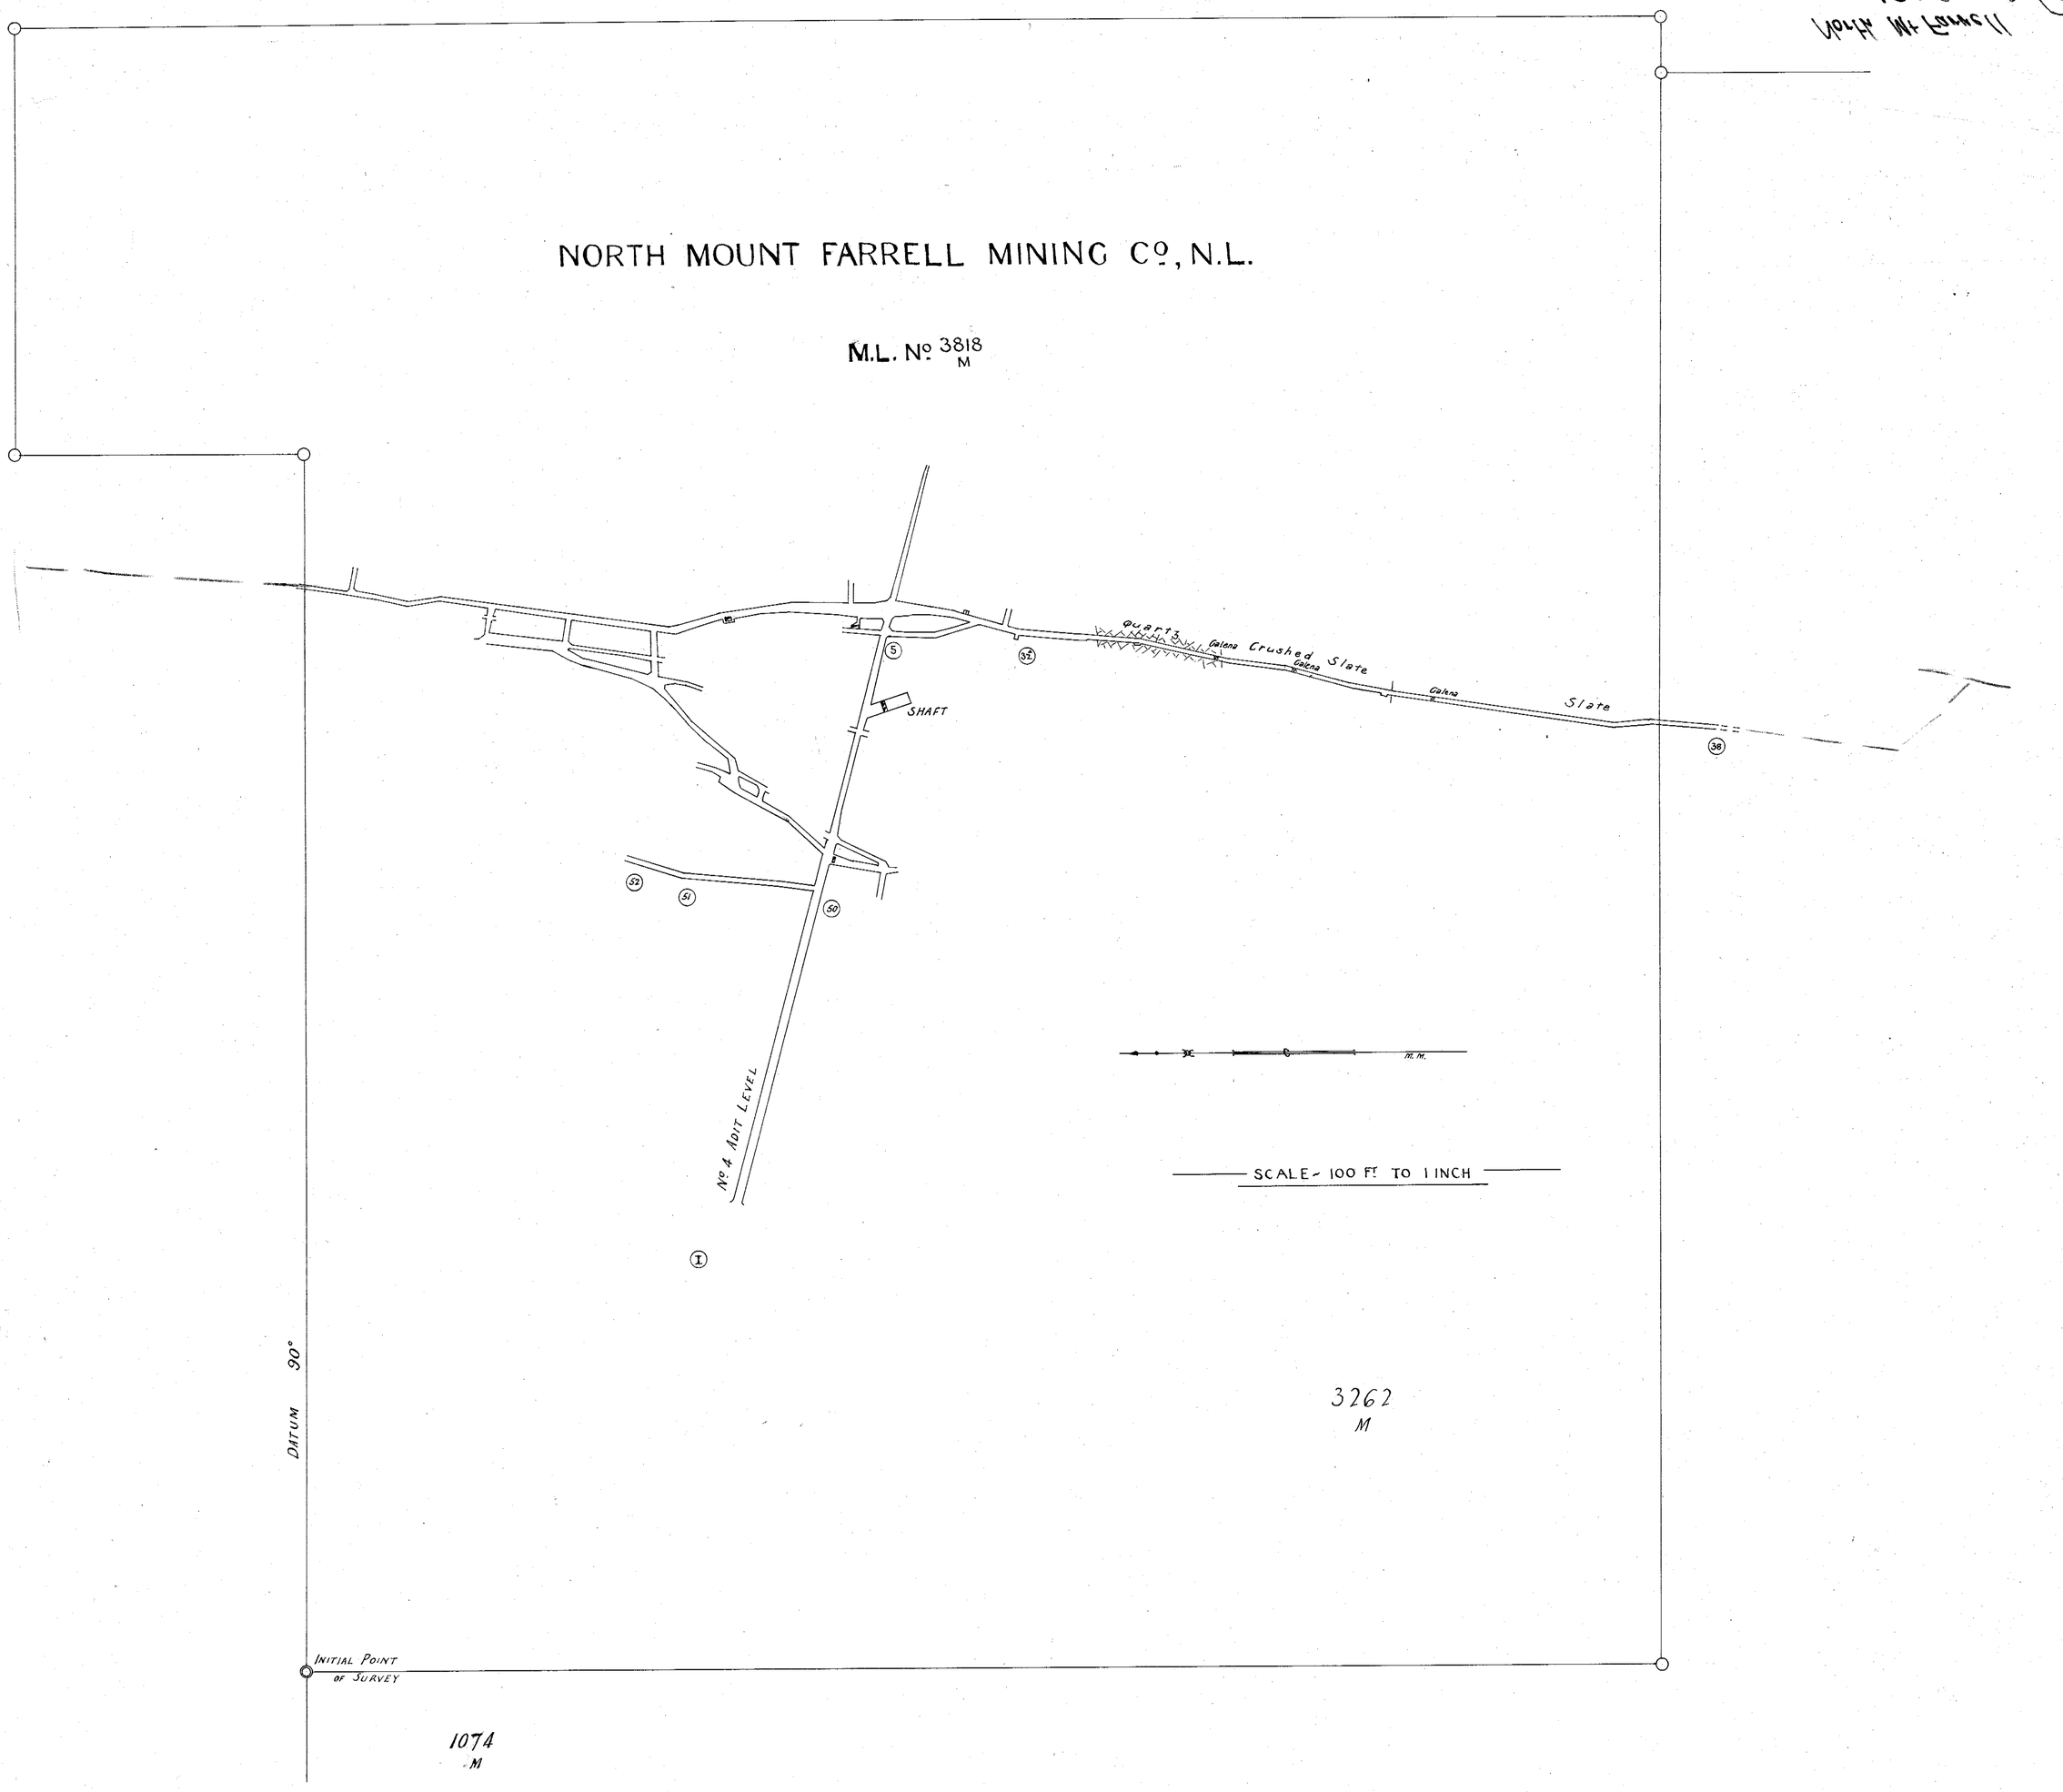

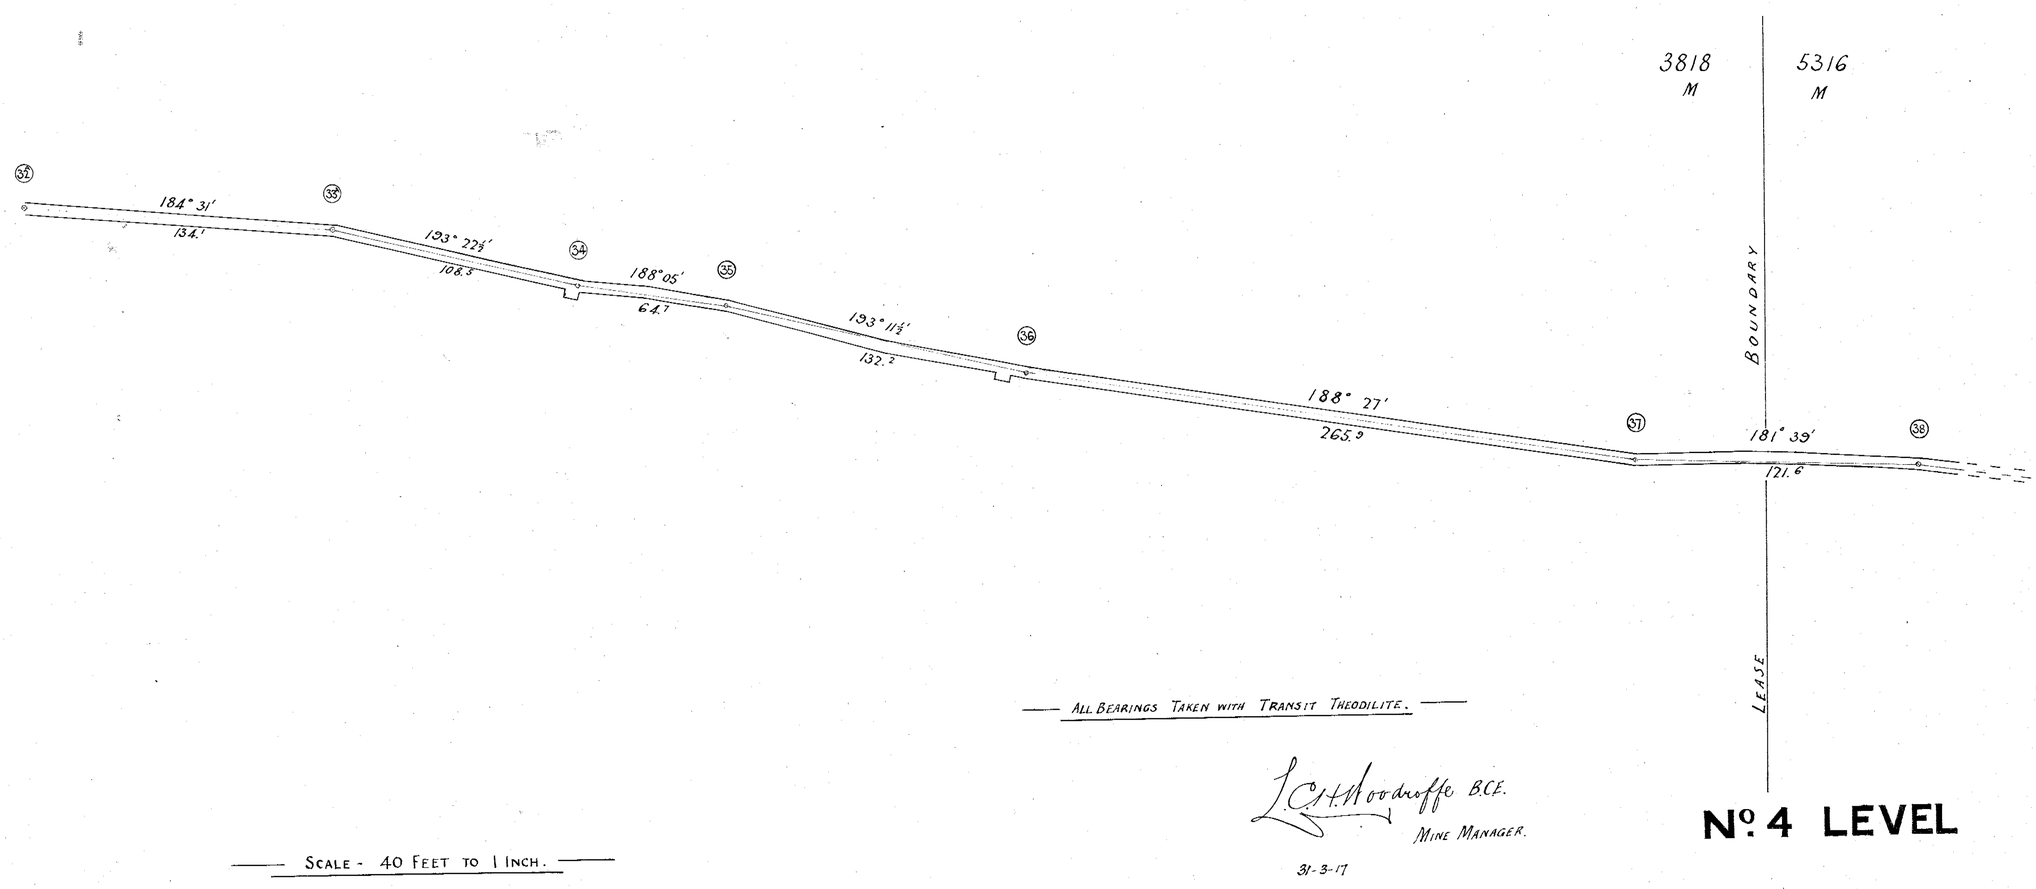

L. C. H. Hoodnoffe B.C.E.
MINE MANAGER.
31-3-17

No. 4 LEVEL