


# NORTH MOUNT FARRELL MINING Co.


NO LIABILITY.

MINE WORKINGS AT N° 6 LEVEL

Scale: 25ft. to One Inch.

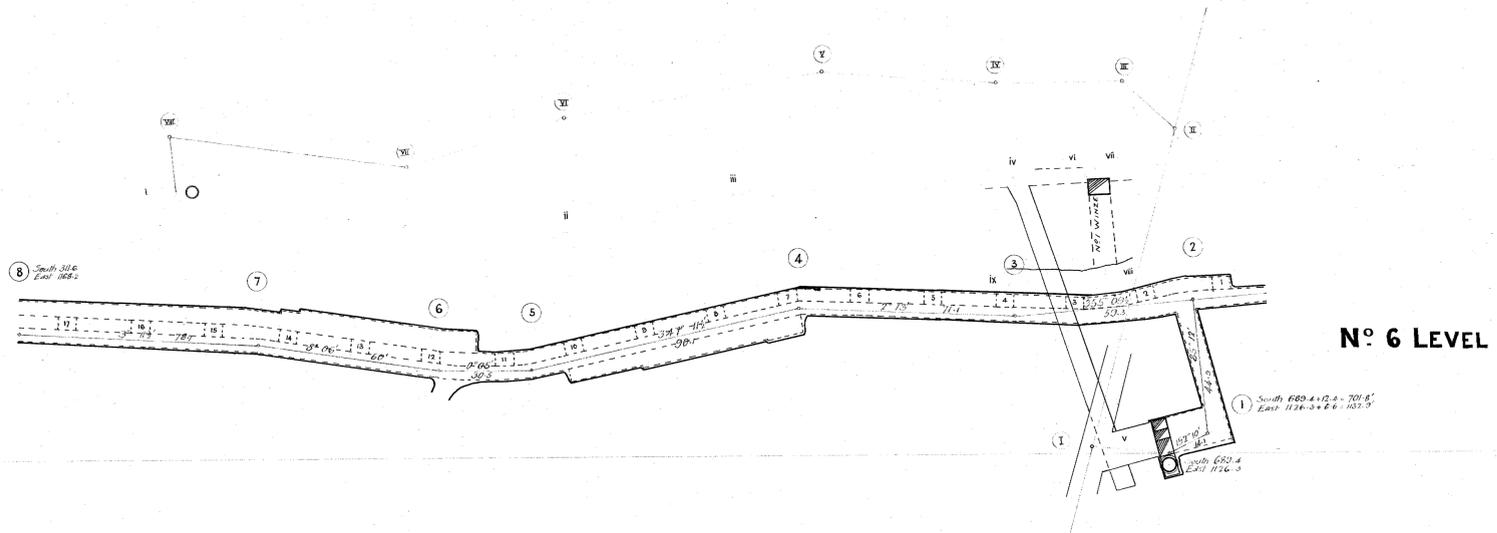

PLAN

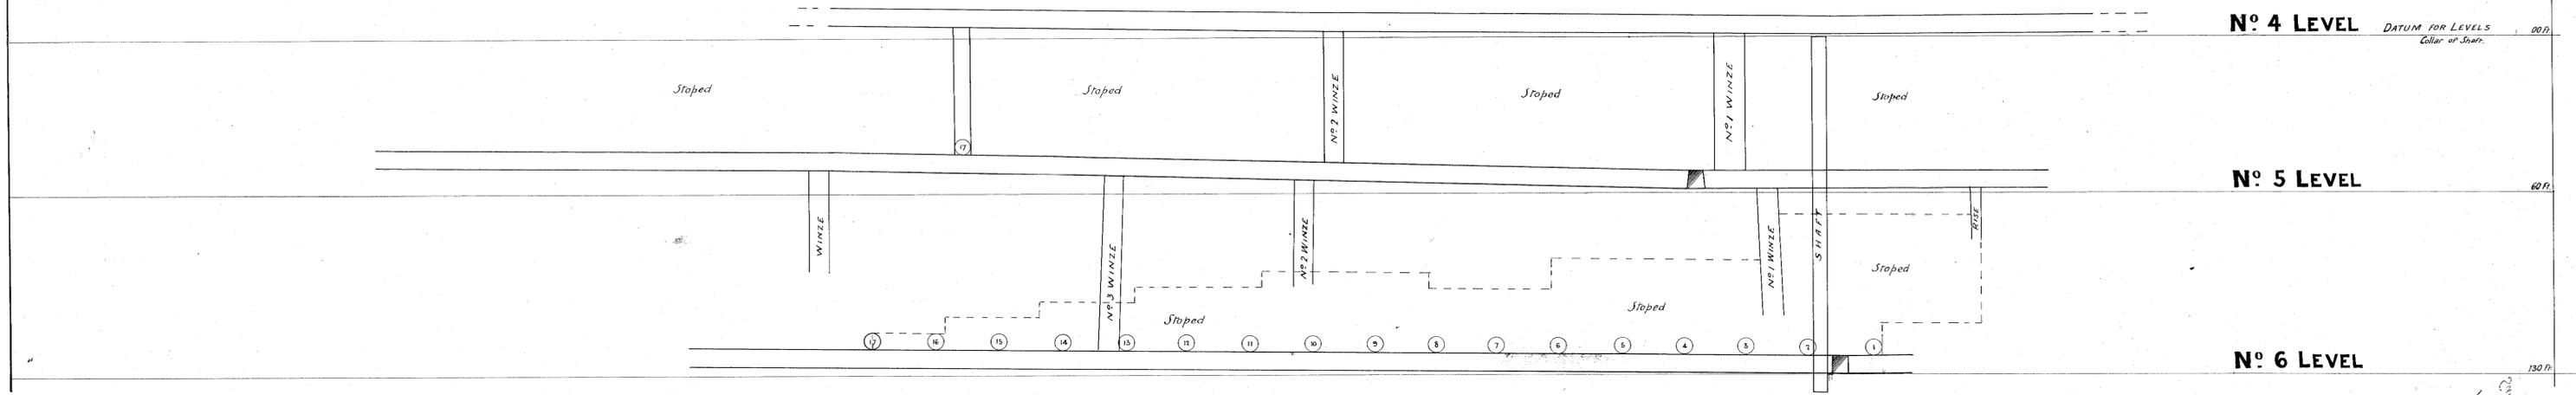

SECTION

PROJECTION

*Leithwoodroffe B.C.C. & Co. Mine Managers North Mount Farrell N.M. Co. 22/4/14*

57-18

57-18

5 cm