North Mount Farrell Mine

Longitudinal Section Workings on No. 3 Lode

Scale: 30 ft. = 1 inch

Note Ground Stoped out May 1, 1911 colored Red

J. C. H. Goodchaffe B.C.E.
Mine Manager.

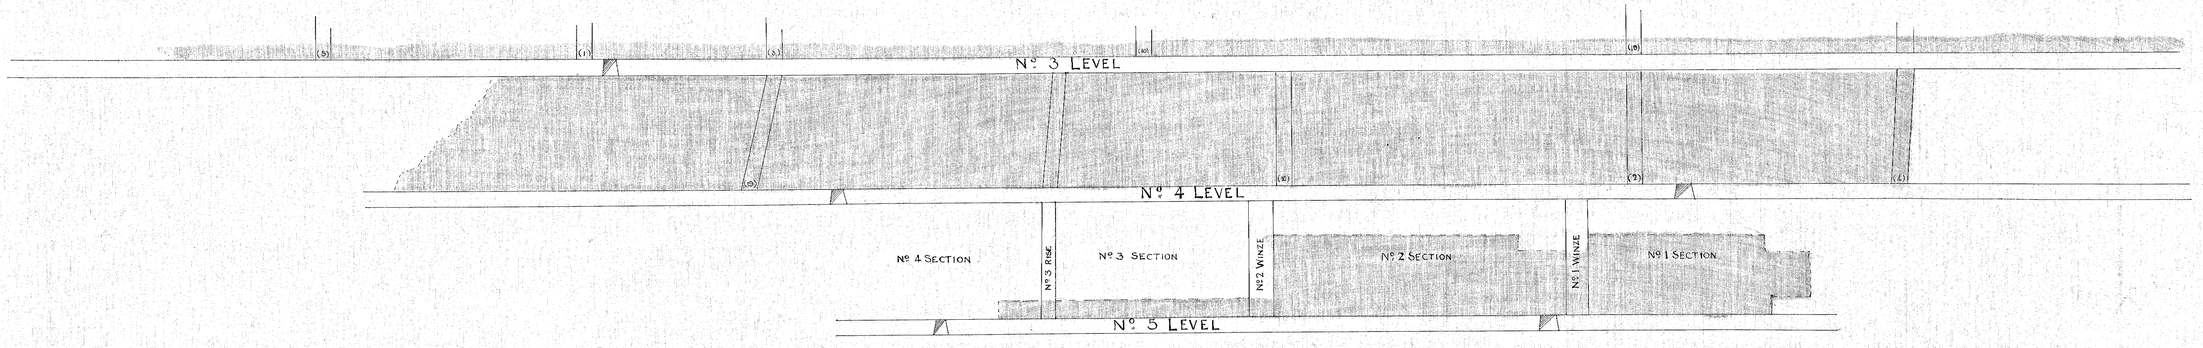

6 m

22-65

22-65