


STOPES N^o 3 LODE

Scale 25' to 1 Inch

March 21st 1908

W.P. Sal.
Surveyor

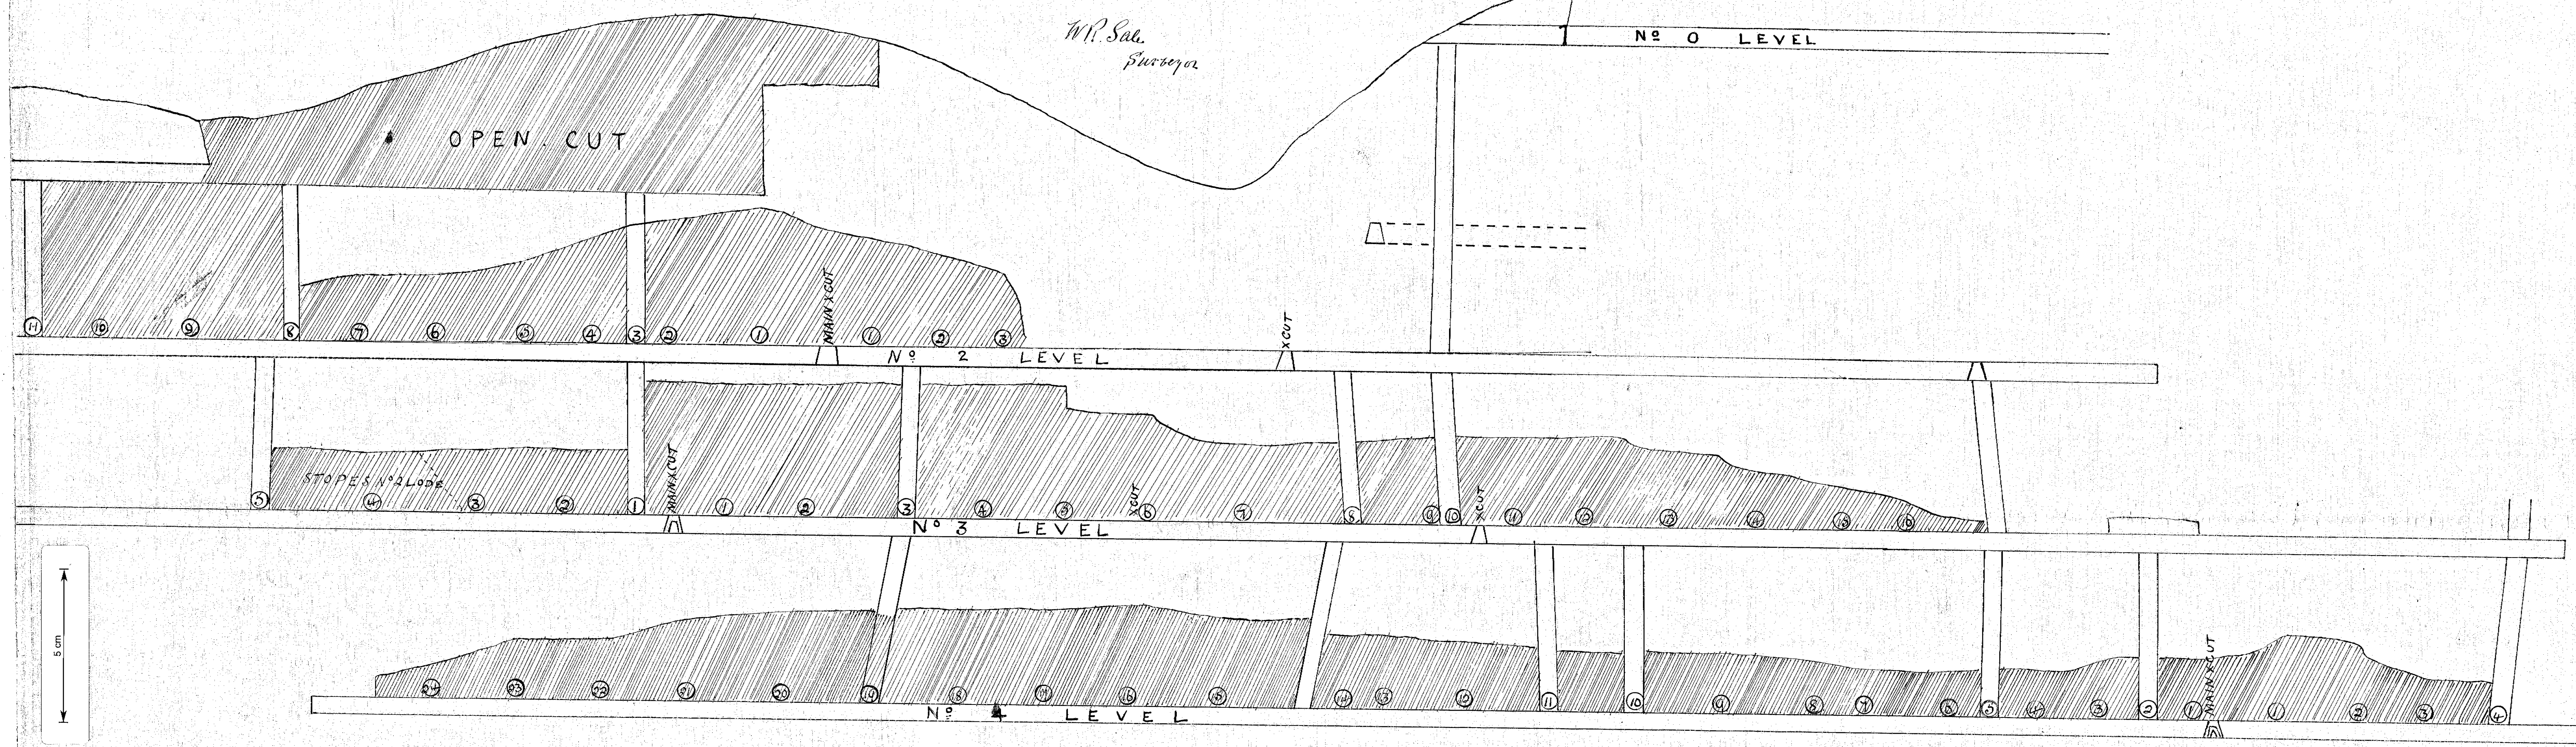

5 cm

59-28

