THE
NORTH MOUNT FARRELL
S.M. Co's UNDERGROUND WORKINGS
May 18. 1907

W.R. Sale
Mine Manager

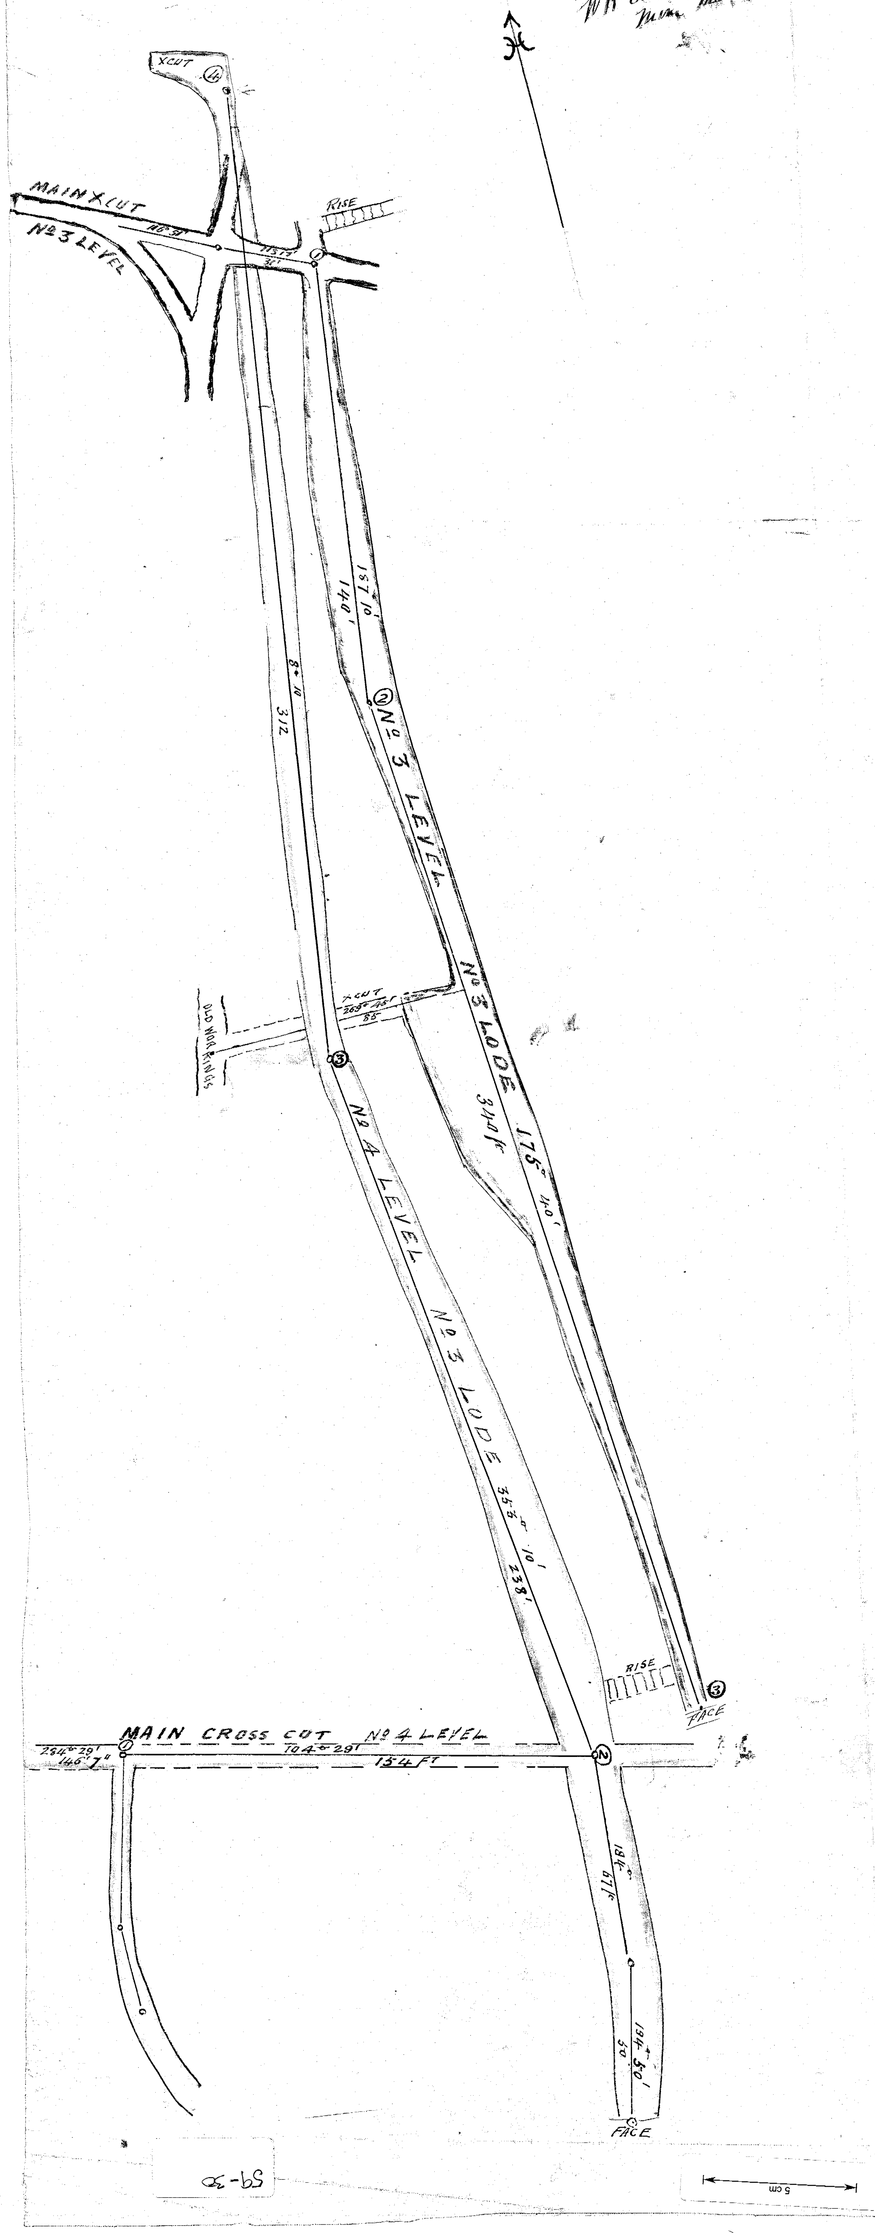

59-50