


# NORTH MOUNT FARRELL C°N.L. LONGITUDINAL SECTION

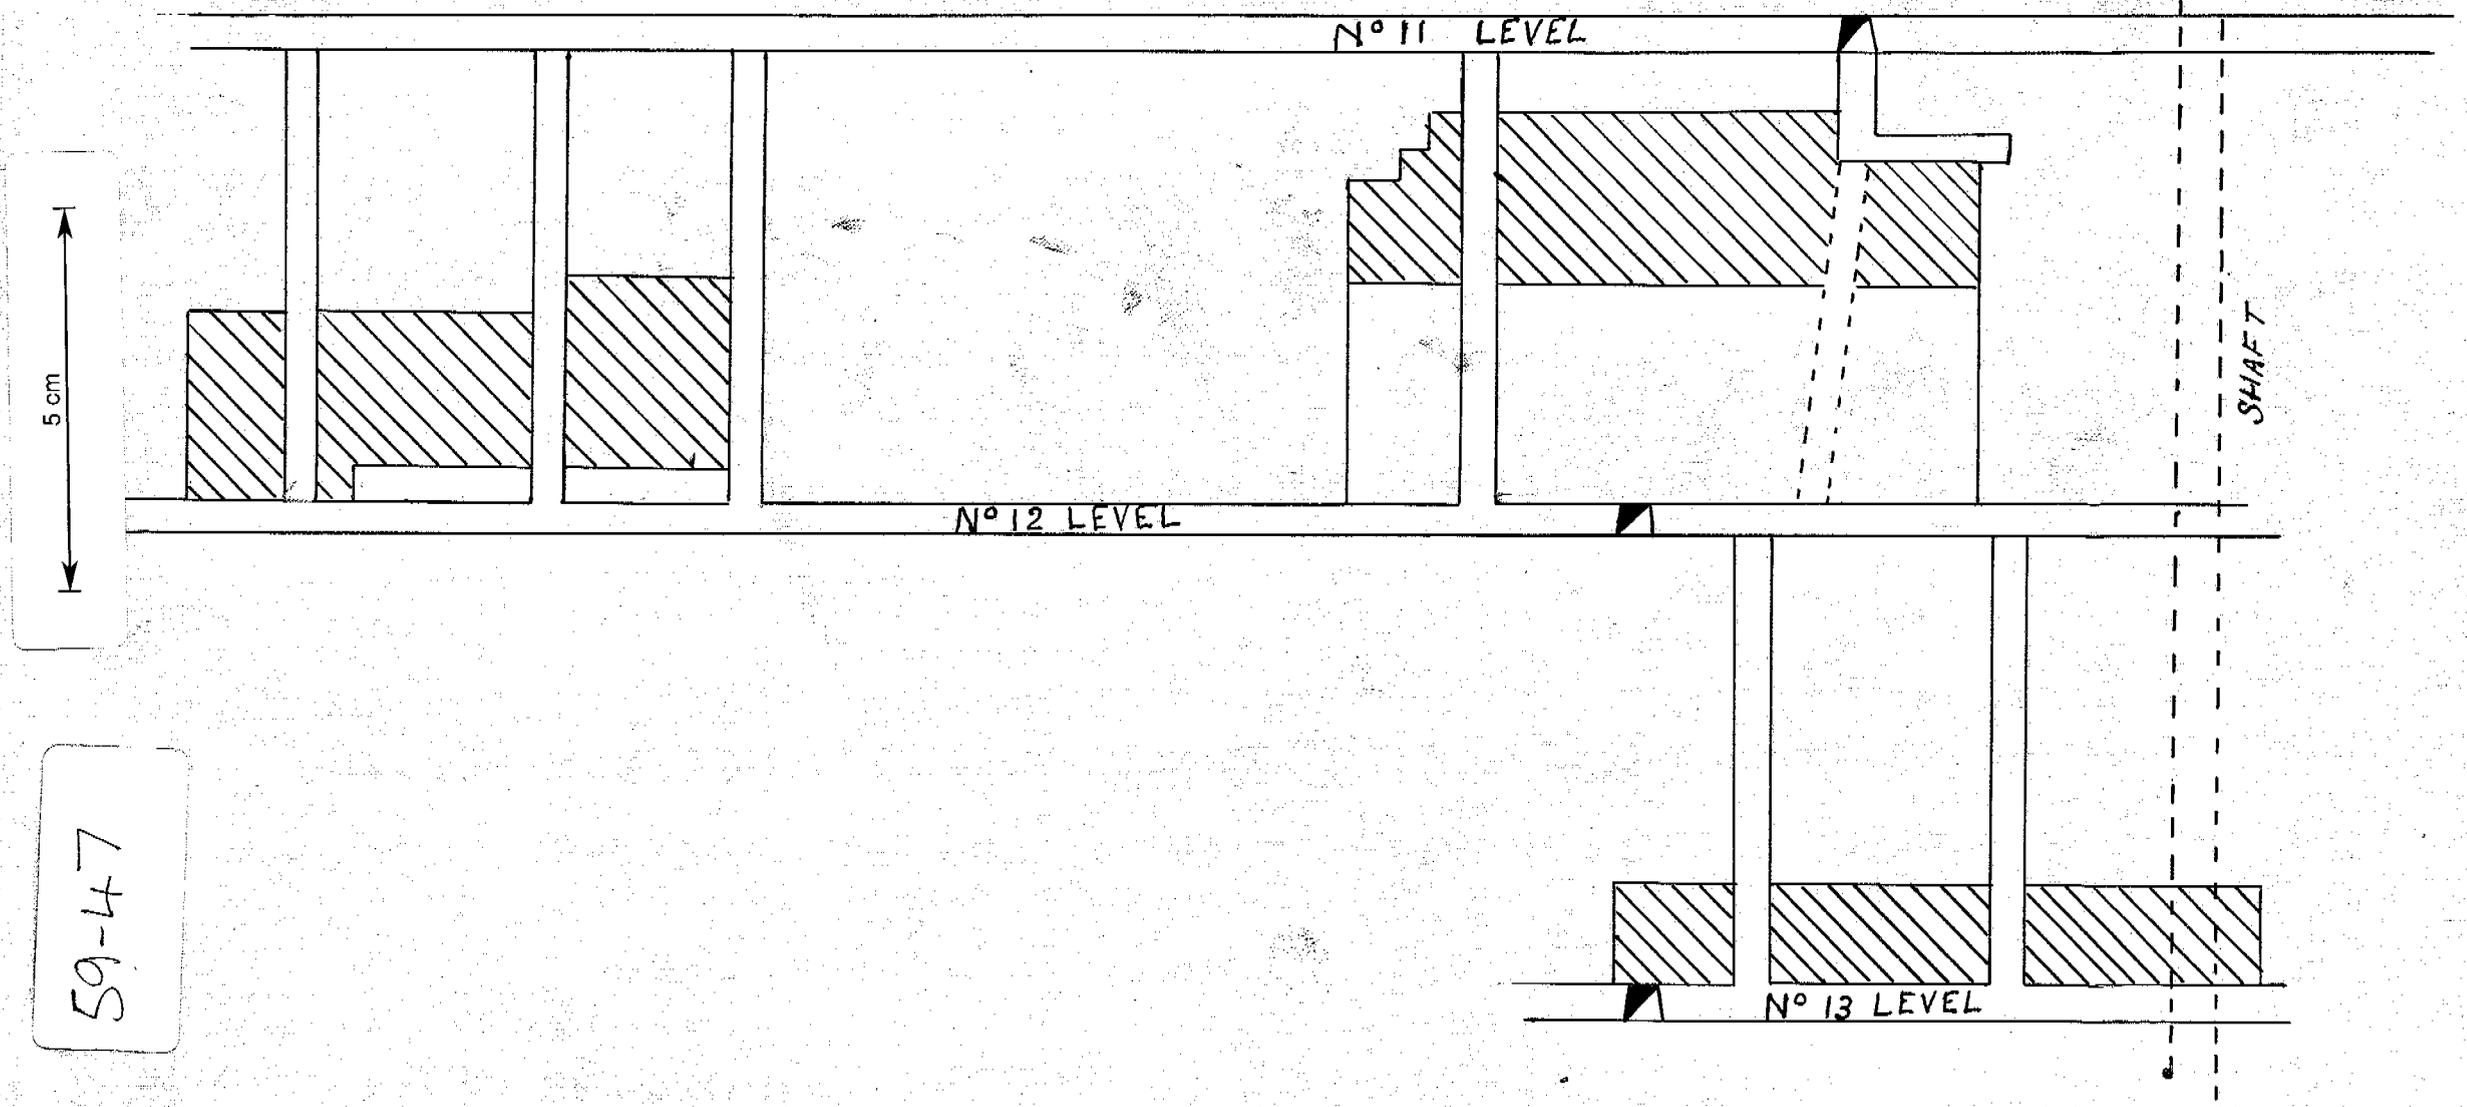


59-47