





NORTH MOUNT FARRELL COMPANY, N.L.

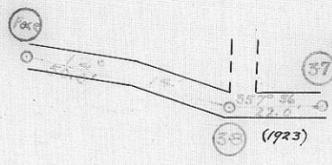

Nº 8 LEVEL (NO 7)

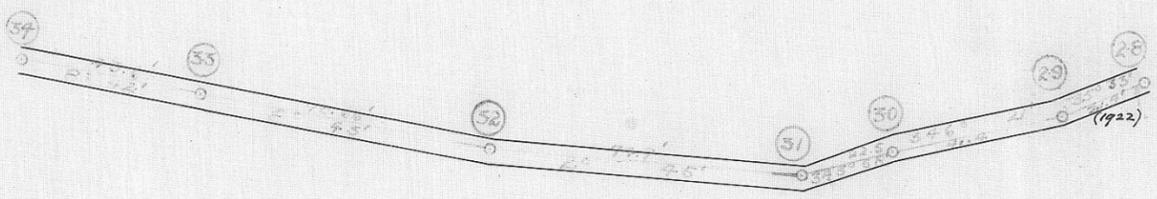

Nº 9 LEVEL (NO 5)

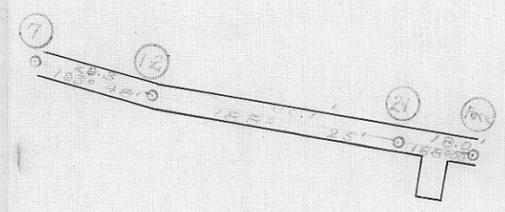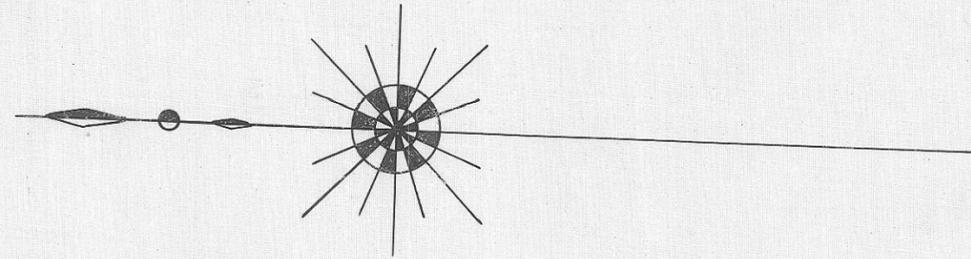

Nº 10 LEVEL (NO 6)

