


NORTH MOUNT FARRELL MINING CO N.L.


SCALE .40 FEET TO AN INCH

*H. J. Jones and
3/14/30*


LONGITUDINAL SECTION

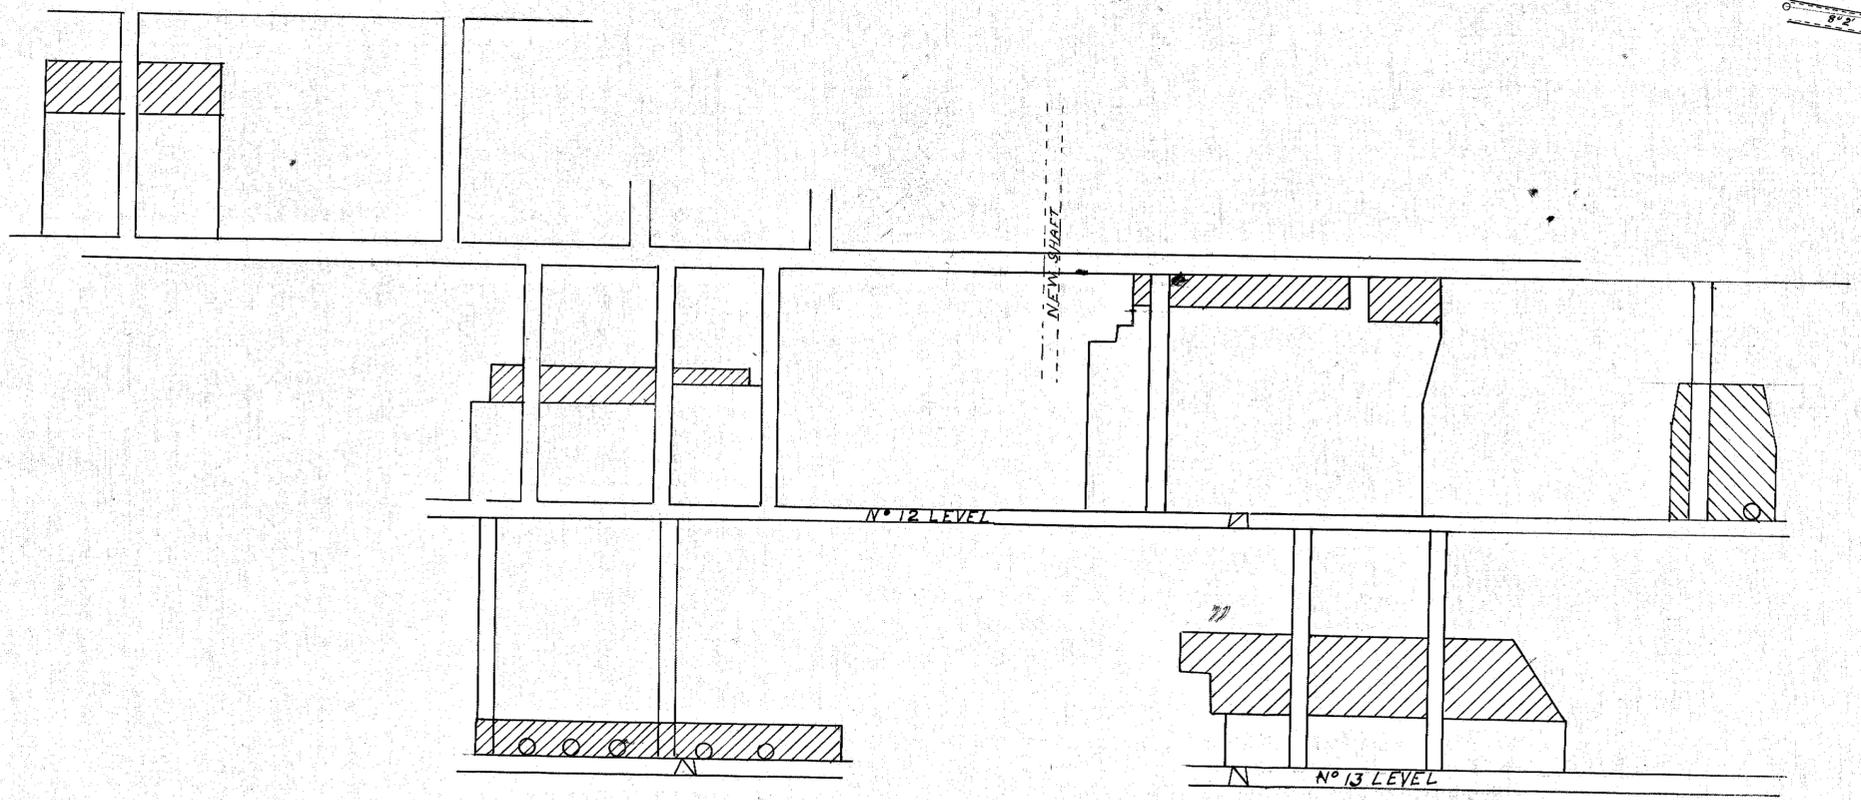

PLAN

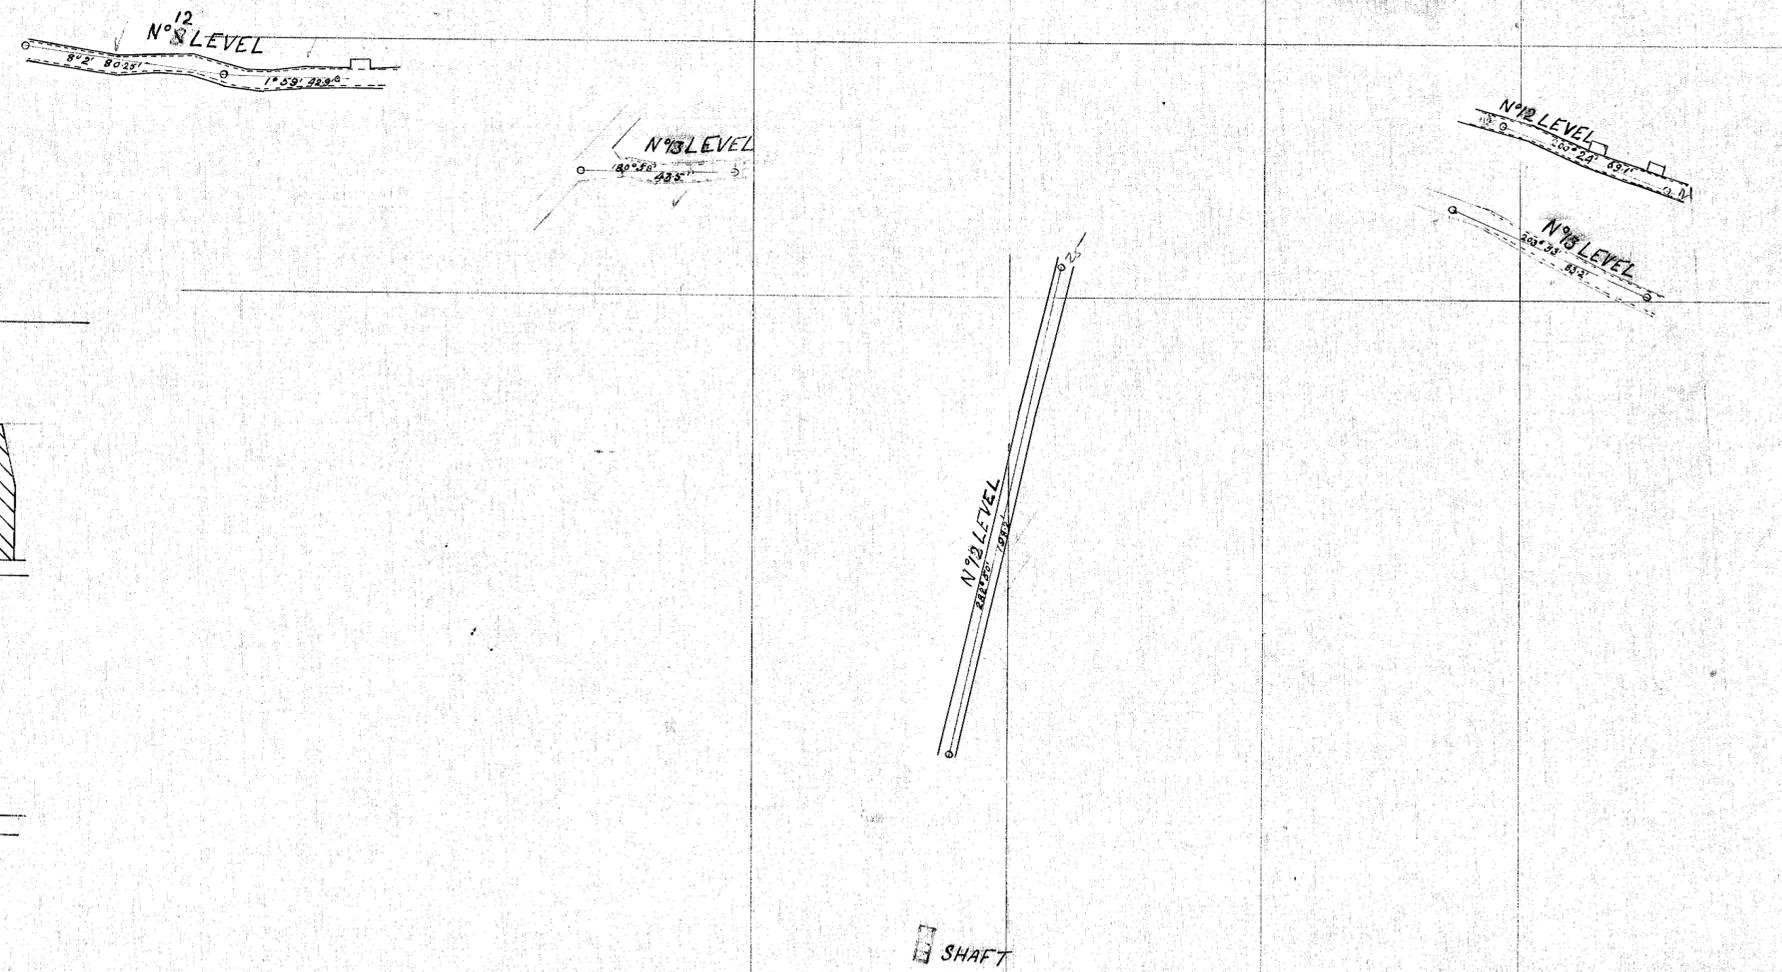

59-57

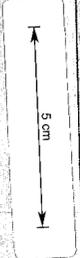

59-57