




0059 - 059

A3-503-0002

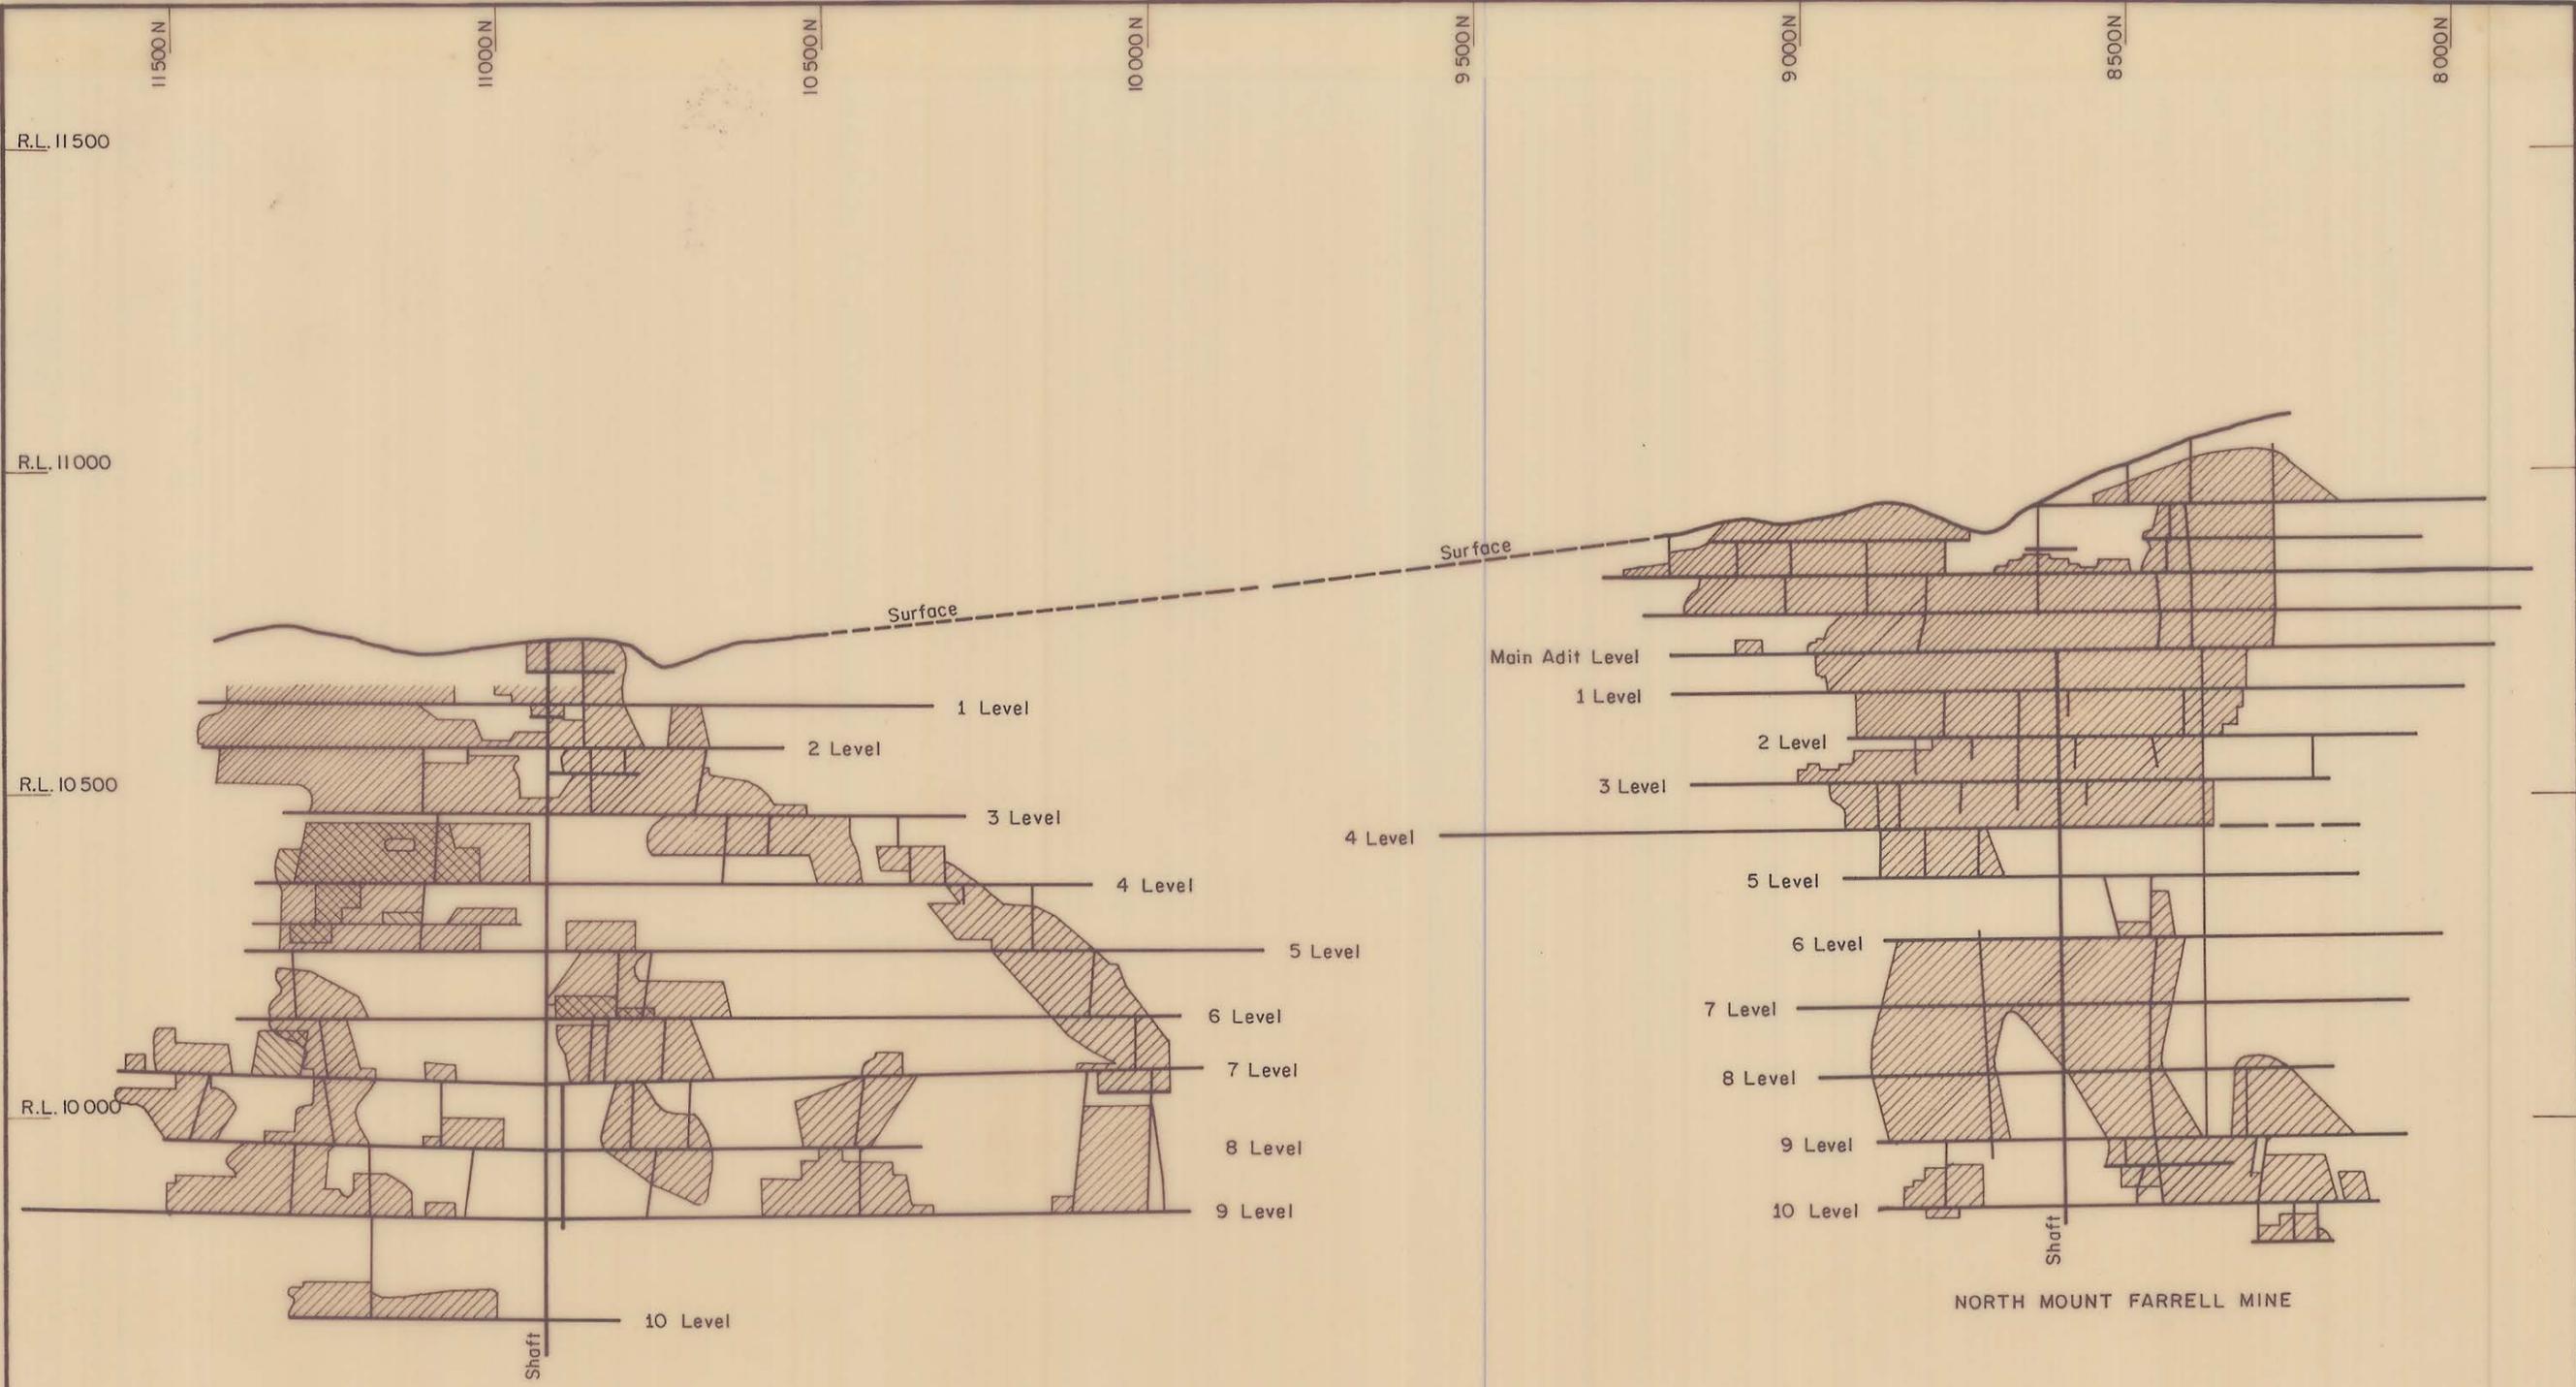

NEW NORTH MOUNT FARRELL MINE

NORTH MOUNT FARRELL MINE

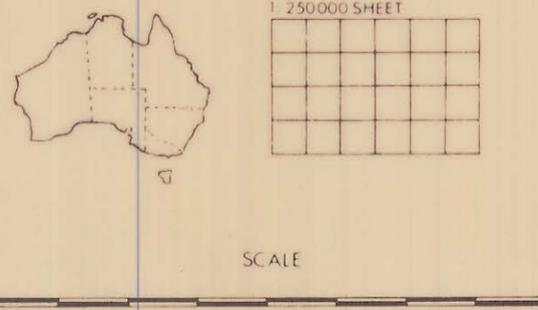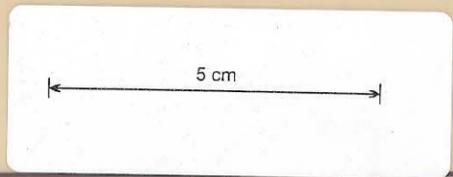

EZ
 ELECTROLYTIC ZINC COMPANY OF AUSTRALASIA LIMITED
 MINERAL RESOURCES DIVISION

PROJECT **FARRELL MINES**

LONGITUDINAL PROJECTION

Compiled S.C.	Date 12-8-'85	Scale N.T.S.
Latitude	Longitude	PLAN NO
Drawn R.J.R.	File No:	A3-503-0002

Trimline A3 for report pockets