
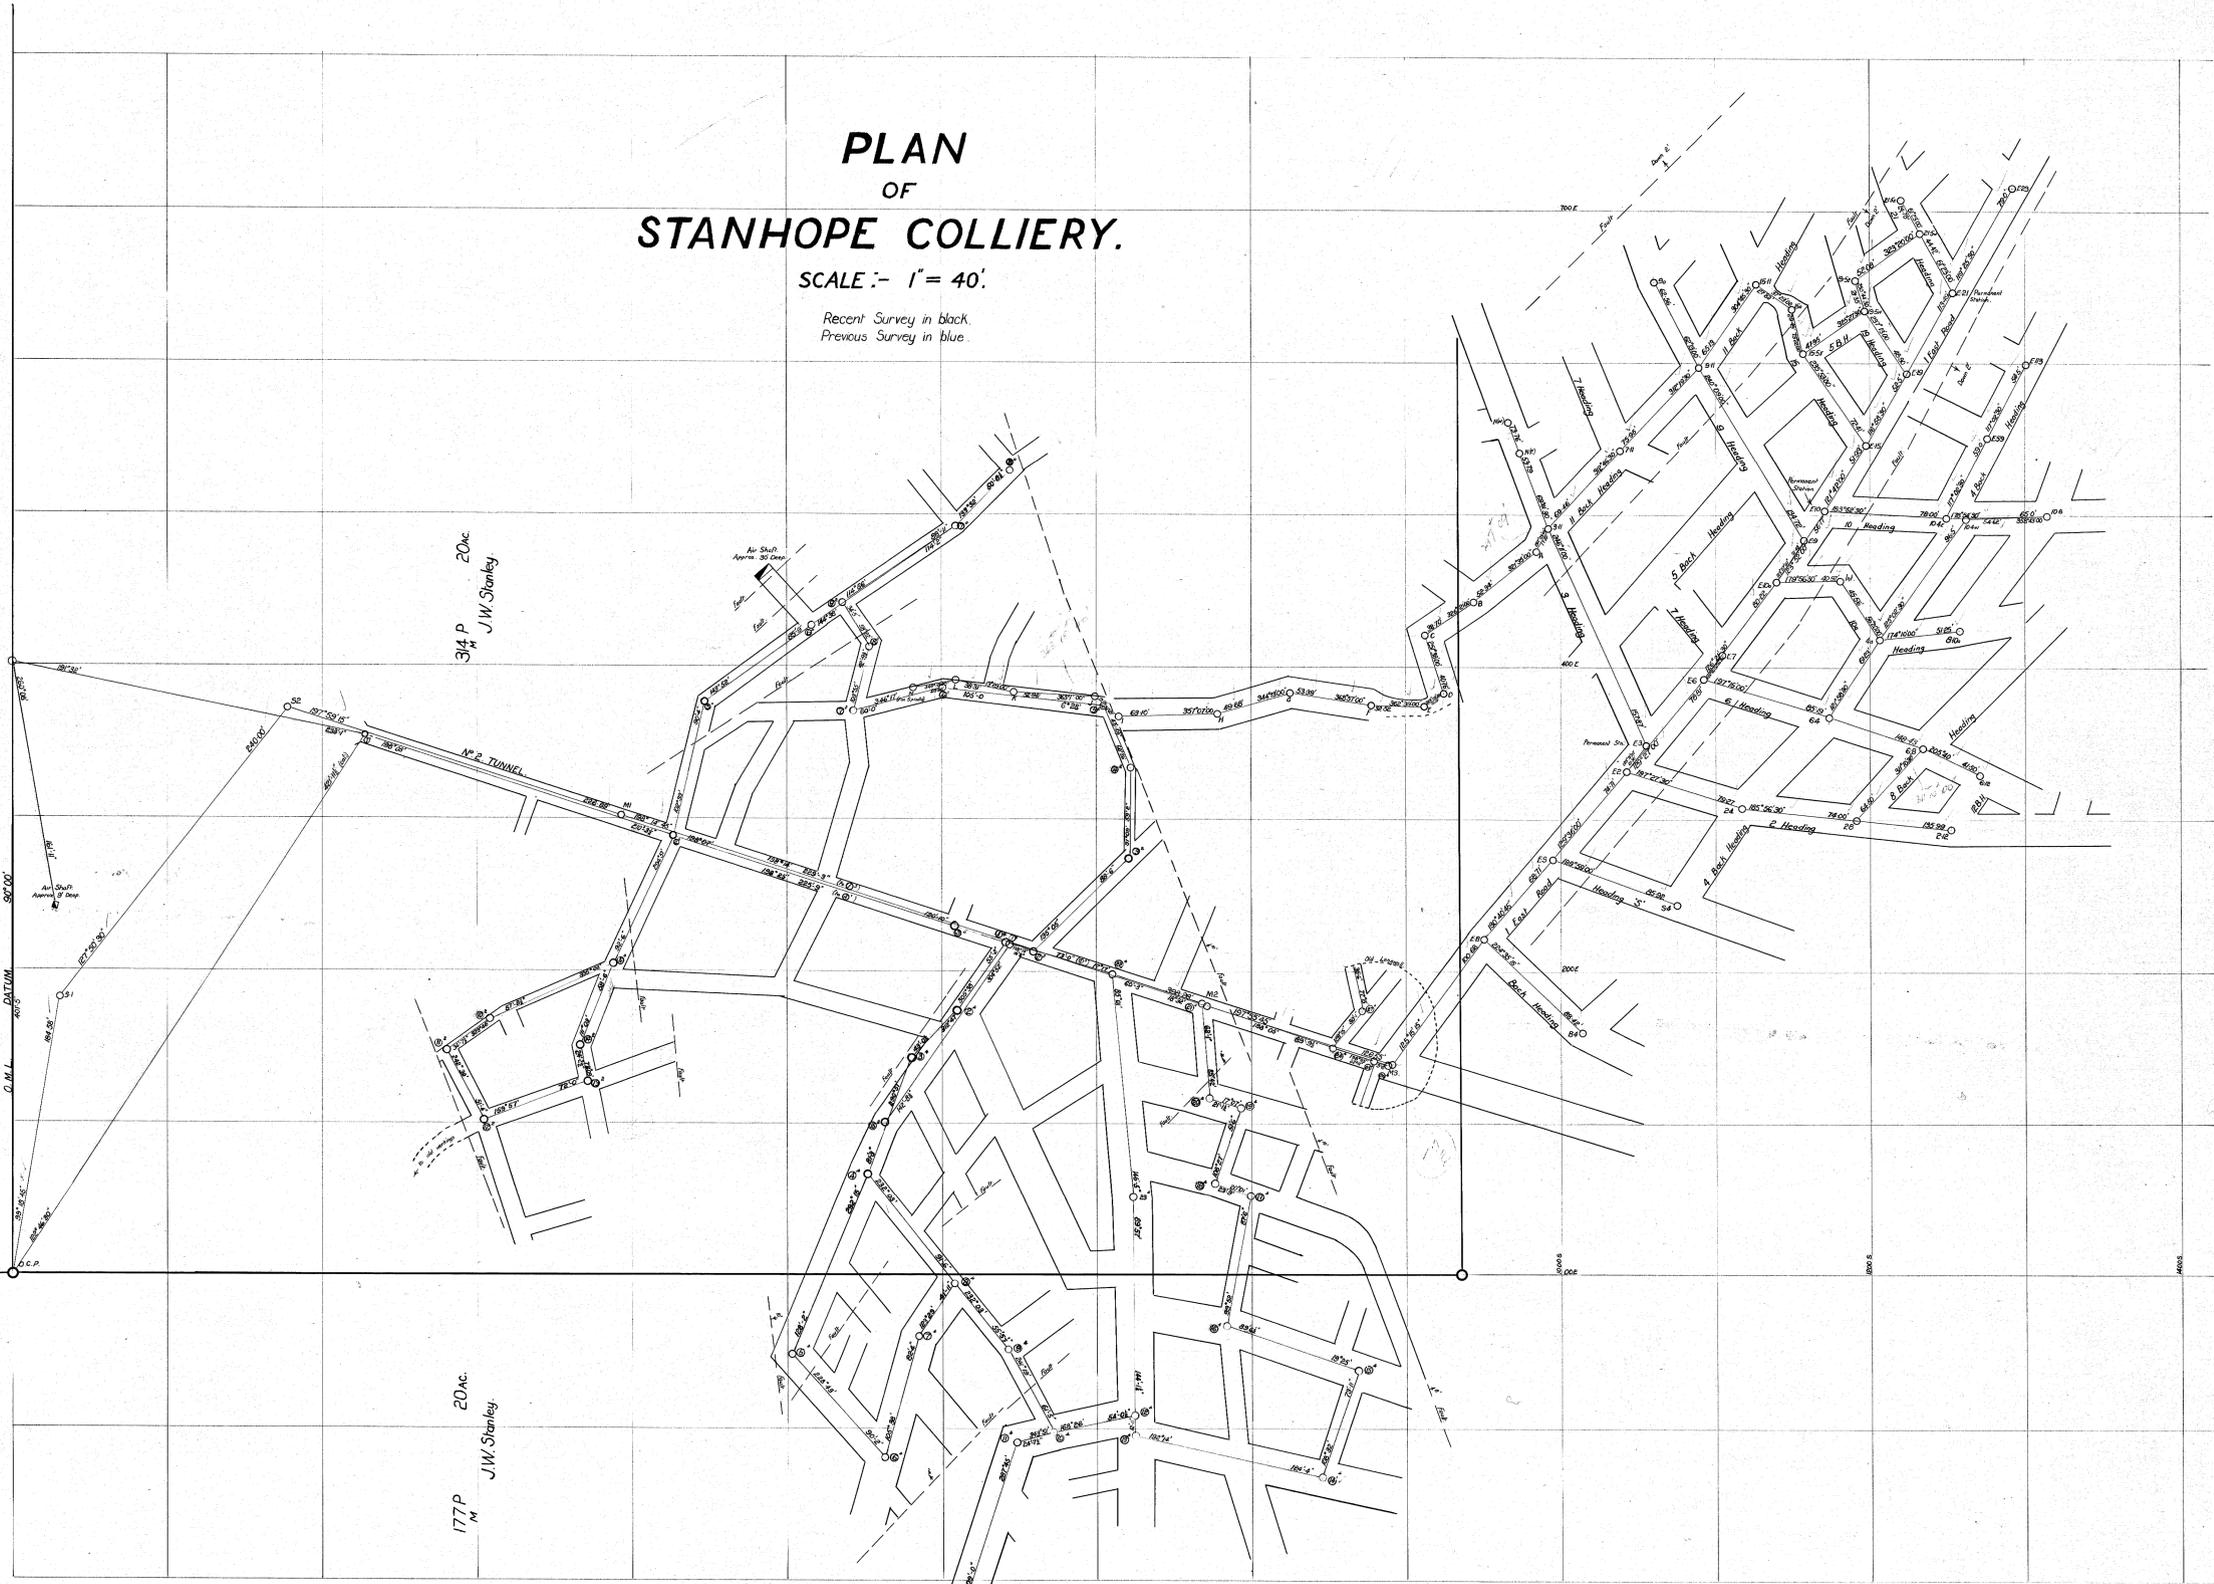


PLAN OF STANHOPE COLLIERY.

SCALE :- 1" = 40'

Recent Survey in black.
Previous Survey in blue.

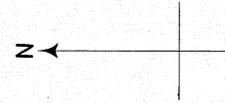

314 P
20ac
J.W. Stanley

177 P
20ac
J.W. Stanley

20 AC.

285 P
M






