PLAN. 2.

PLAN OF STANHOPE COLLIERY

Scale. 40 feet. to an inch

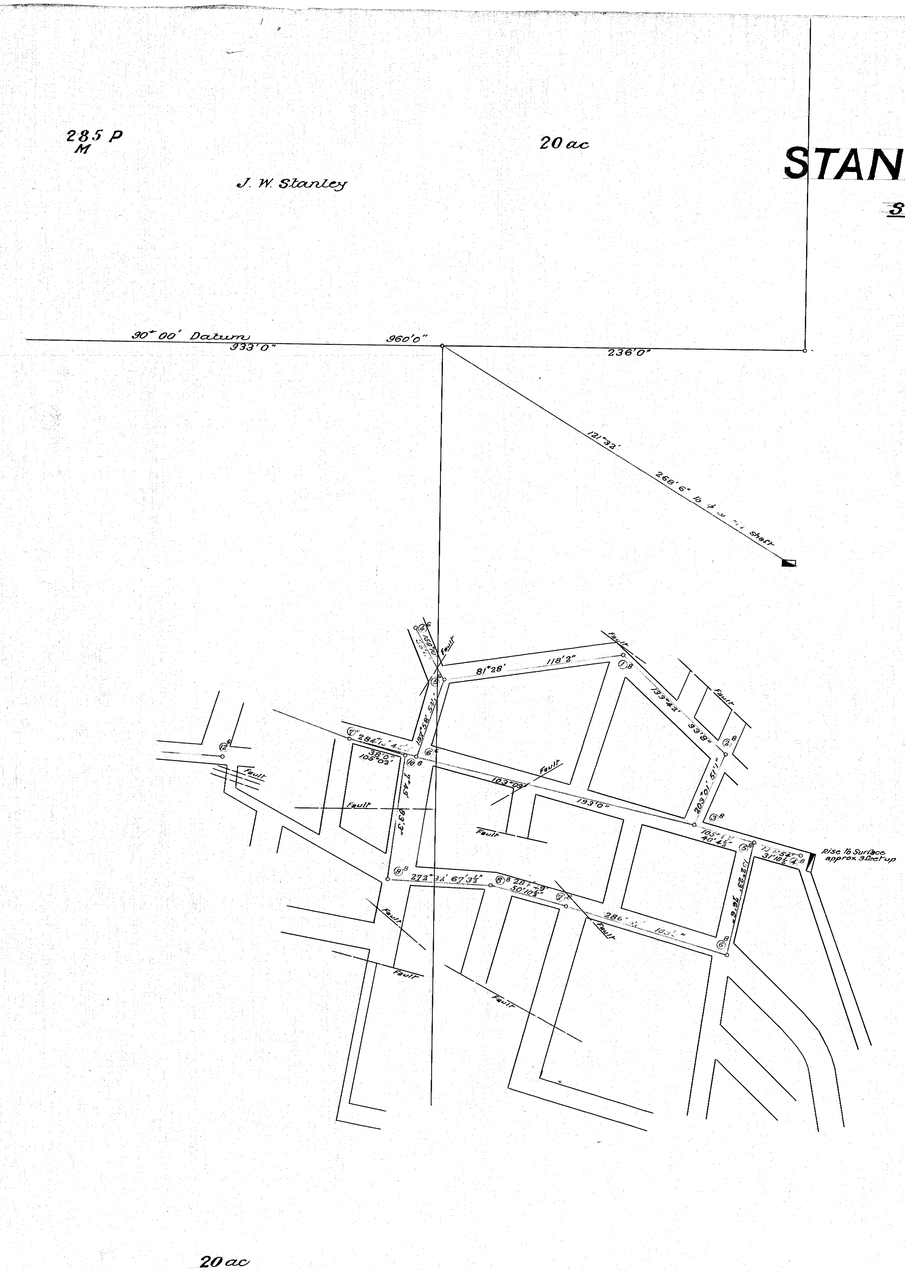

A.W.T. McCure
Mining Surveyor
10th June 1938.

5 cm

60-04