
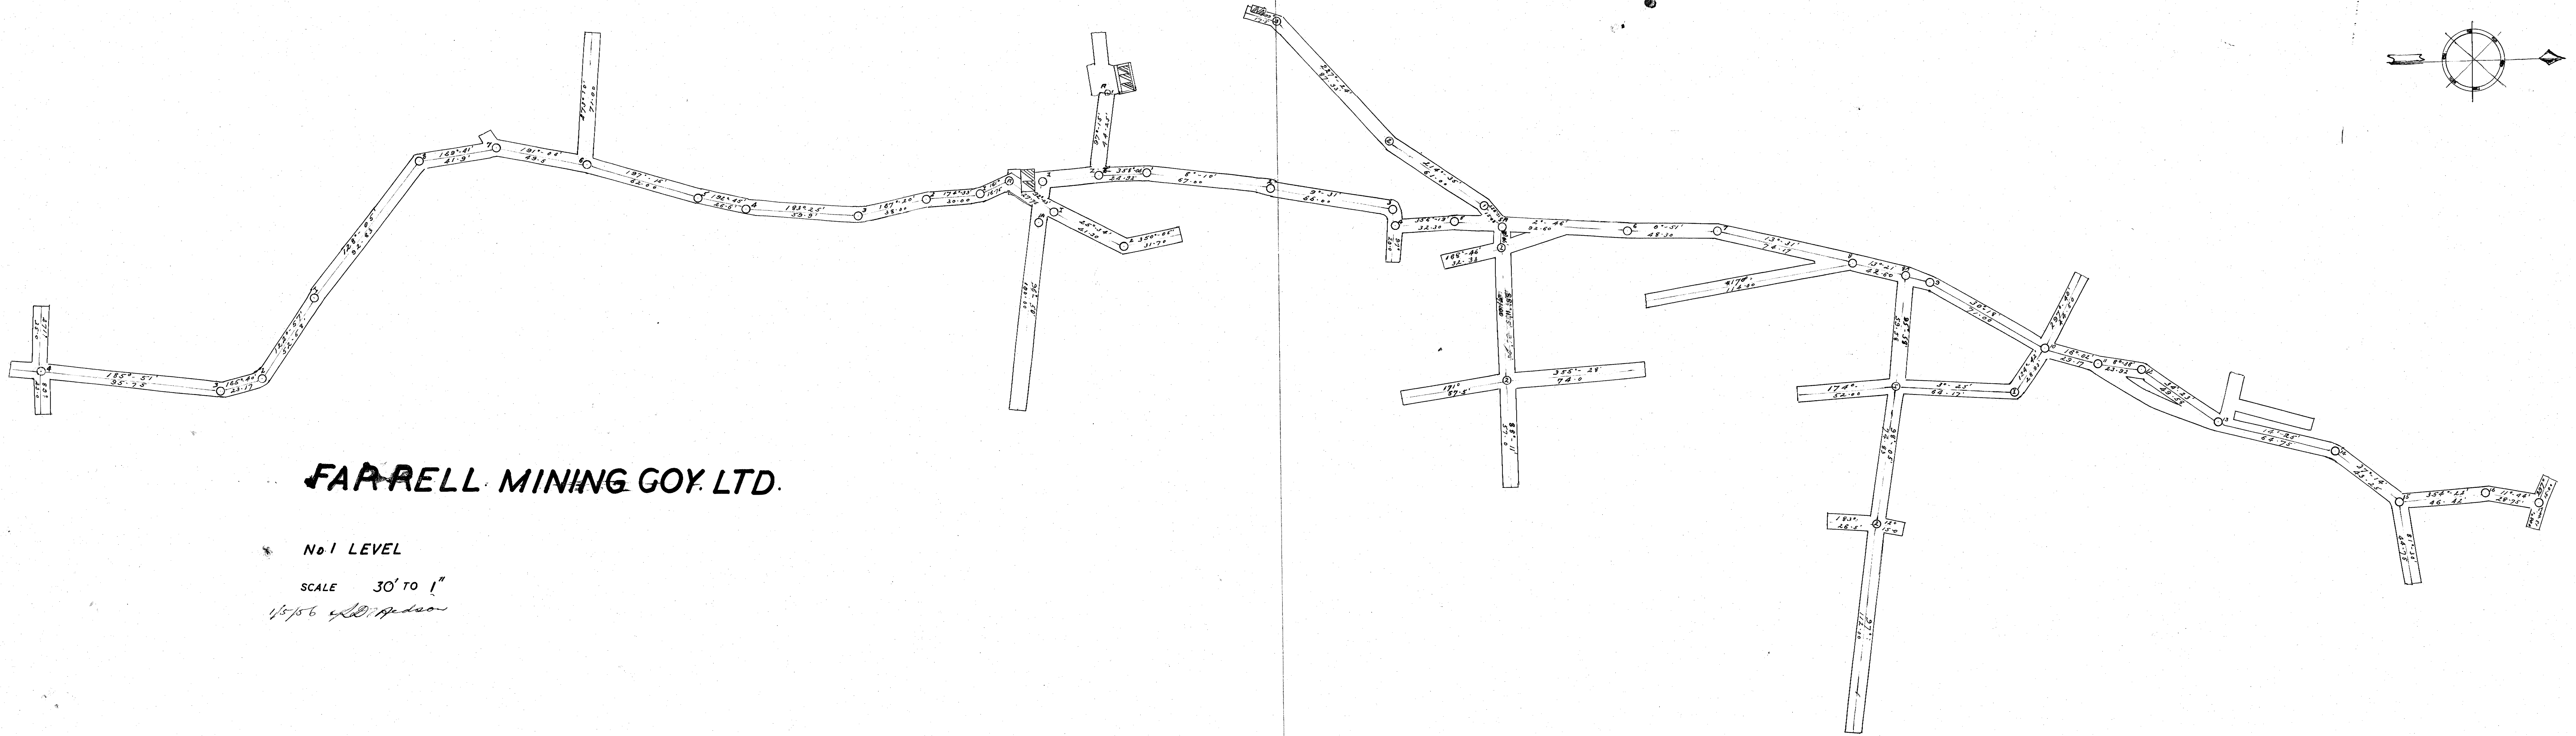


61-03

61-03

500 F

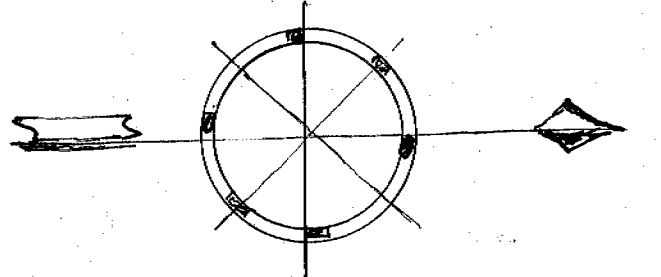

FARRELL MINING COY. LTD.

No. 1 LEVEL

SCALE 30' TO 1"

1/5/56 *W.D. Jackson*

5 cm